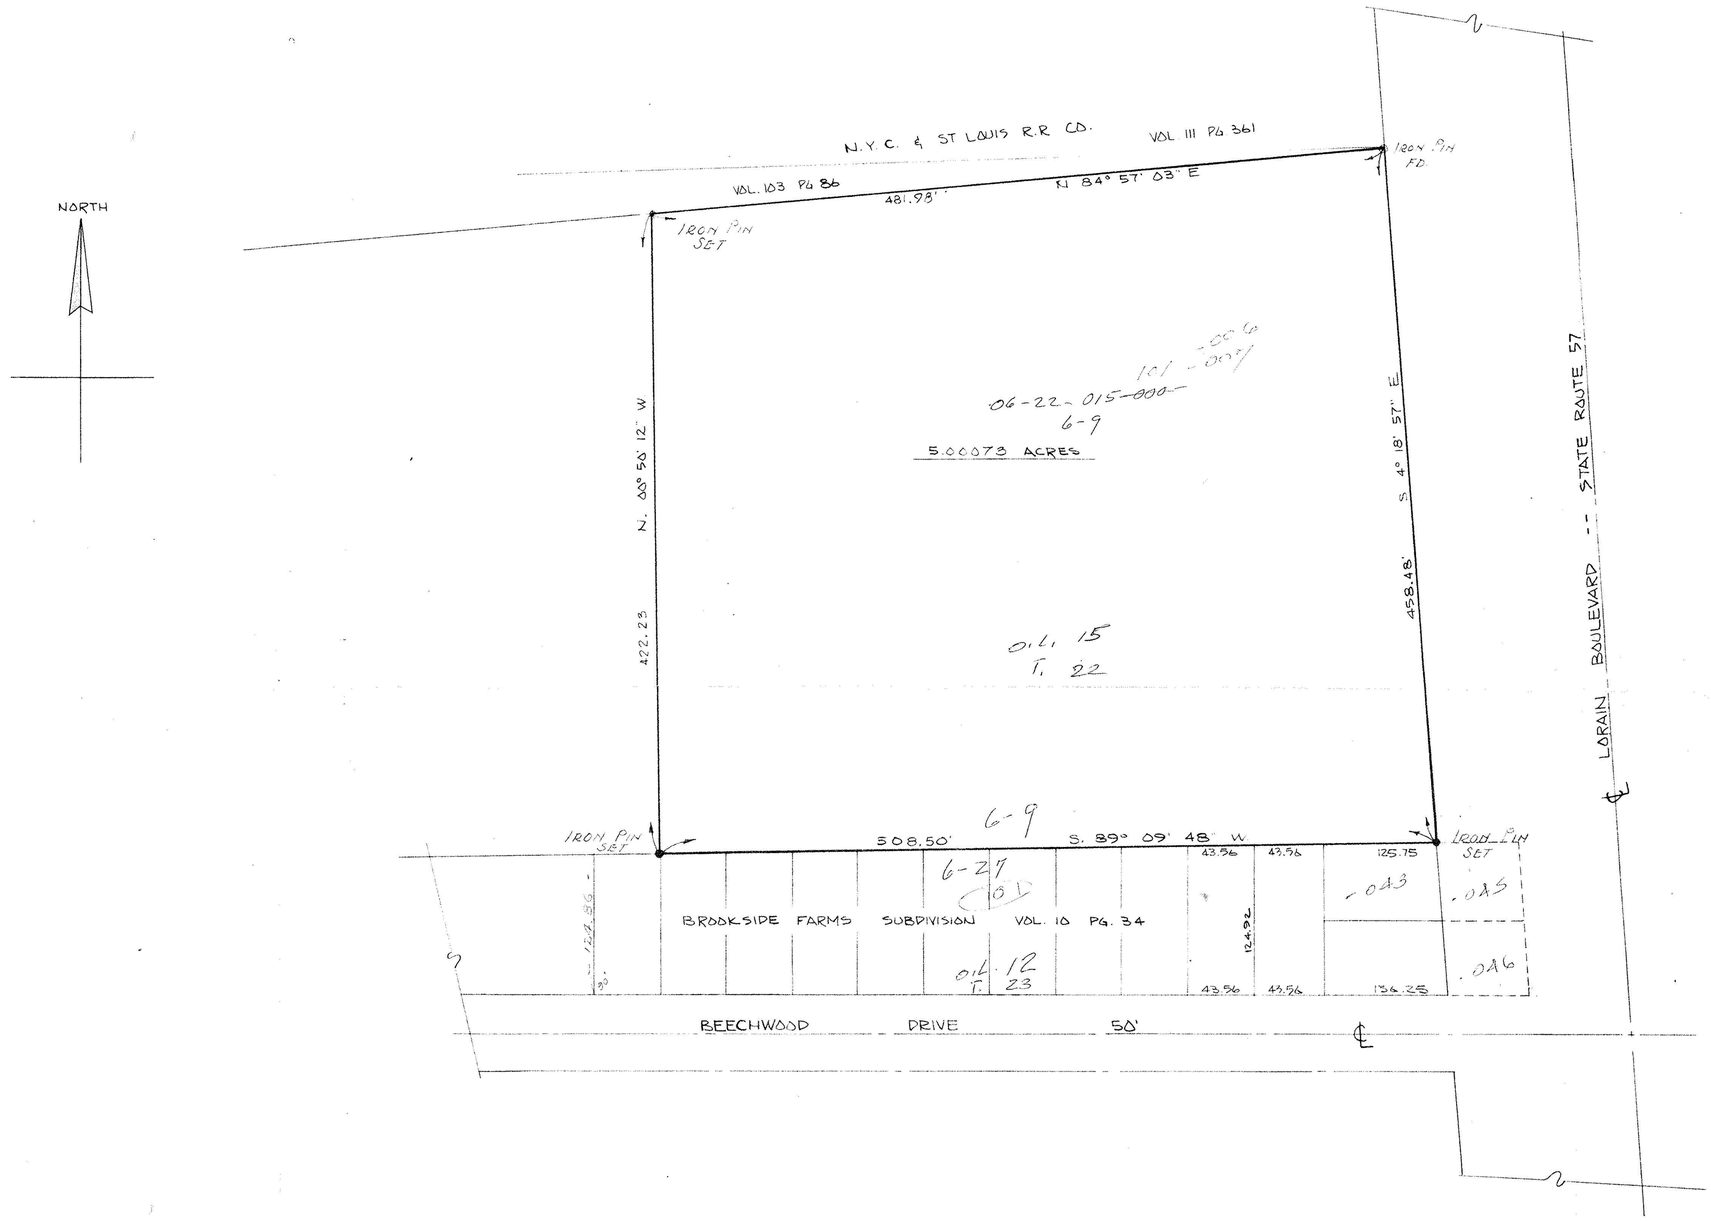

REFERENCE: RAY HOLLIS FIELD BOOK 103
PGS 52,53,54,56.
RAY HOLLIS DRAWING, FILE NO.
6-BURRELLDAY-15,16

REVISED 3-6-73

STATE OF OHIO
JOHN L. MENO
3662
REGISTERED SURVEYOR

MILAN INDUSTRIES INC.
N. MAIN STREET
MILAN, OHIO

SCHAFER, HURA & ASSOCIATES, INC.
ENGINEERS AND SURVEYORS
4370 OBERLIN AVE.
LORAIN, OHIO

SURVEY

ORIGINAL LOT 15, BURRELL DAY TR	DATE 12-4-72
TOWNSHIP ELYRIA	SCALE 1" = 50'
CITY OF ELYRIA	FIELD BOOK 219, PGS 90,91
COUNTY OF LORAIN	DRAWN BY JFR
STATE OF OHIO	CHECKED BY
W. O. 1879	FILE NO. 6-BURRELLDAY-15