21269

APPROVED
LORAIN CO.
MAP DEPT

DATE 3-17-95

PAGE 6-50

BY CAROLYN FRANCIS

21269

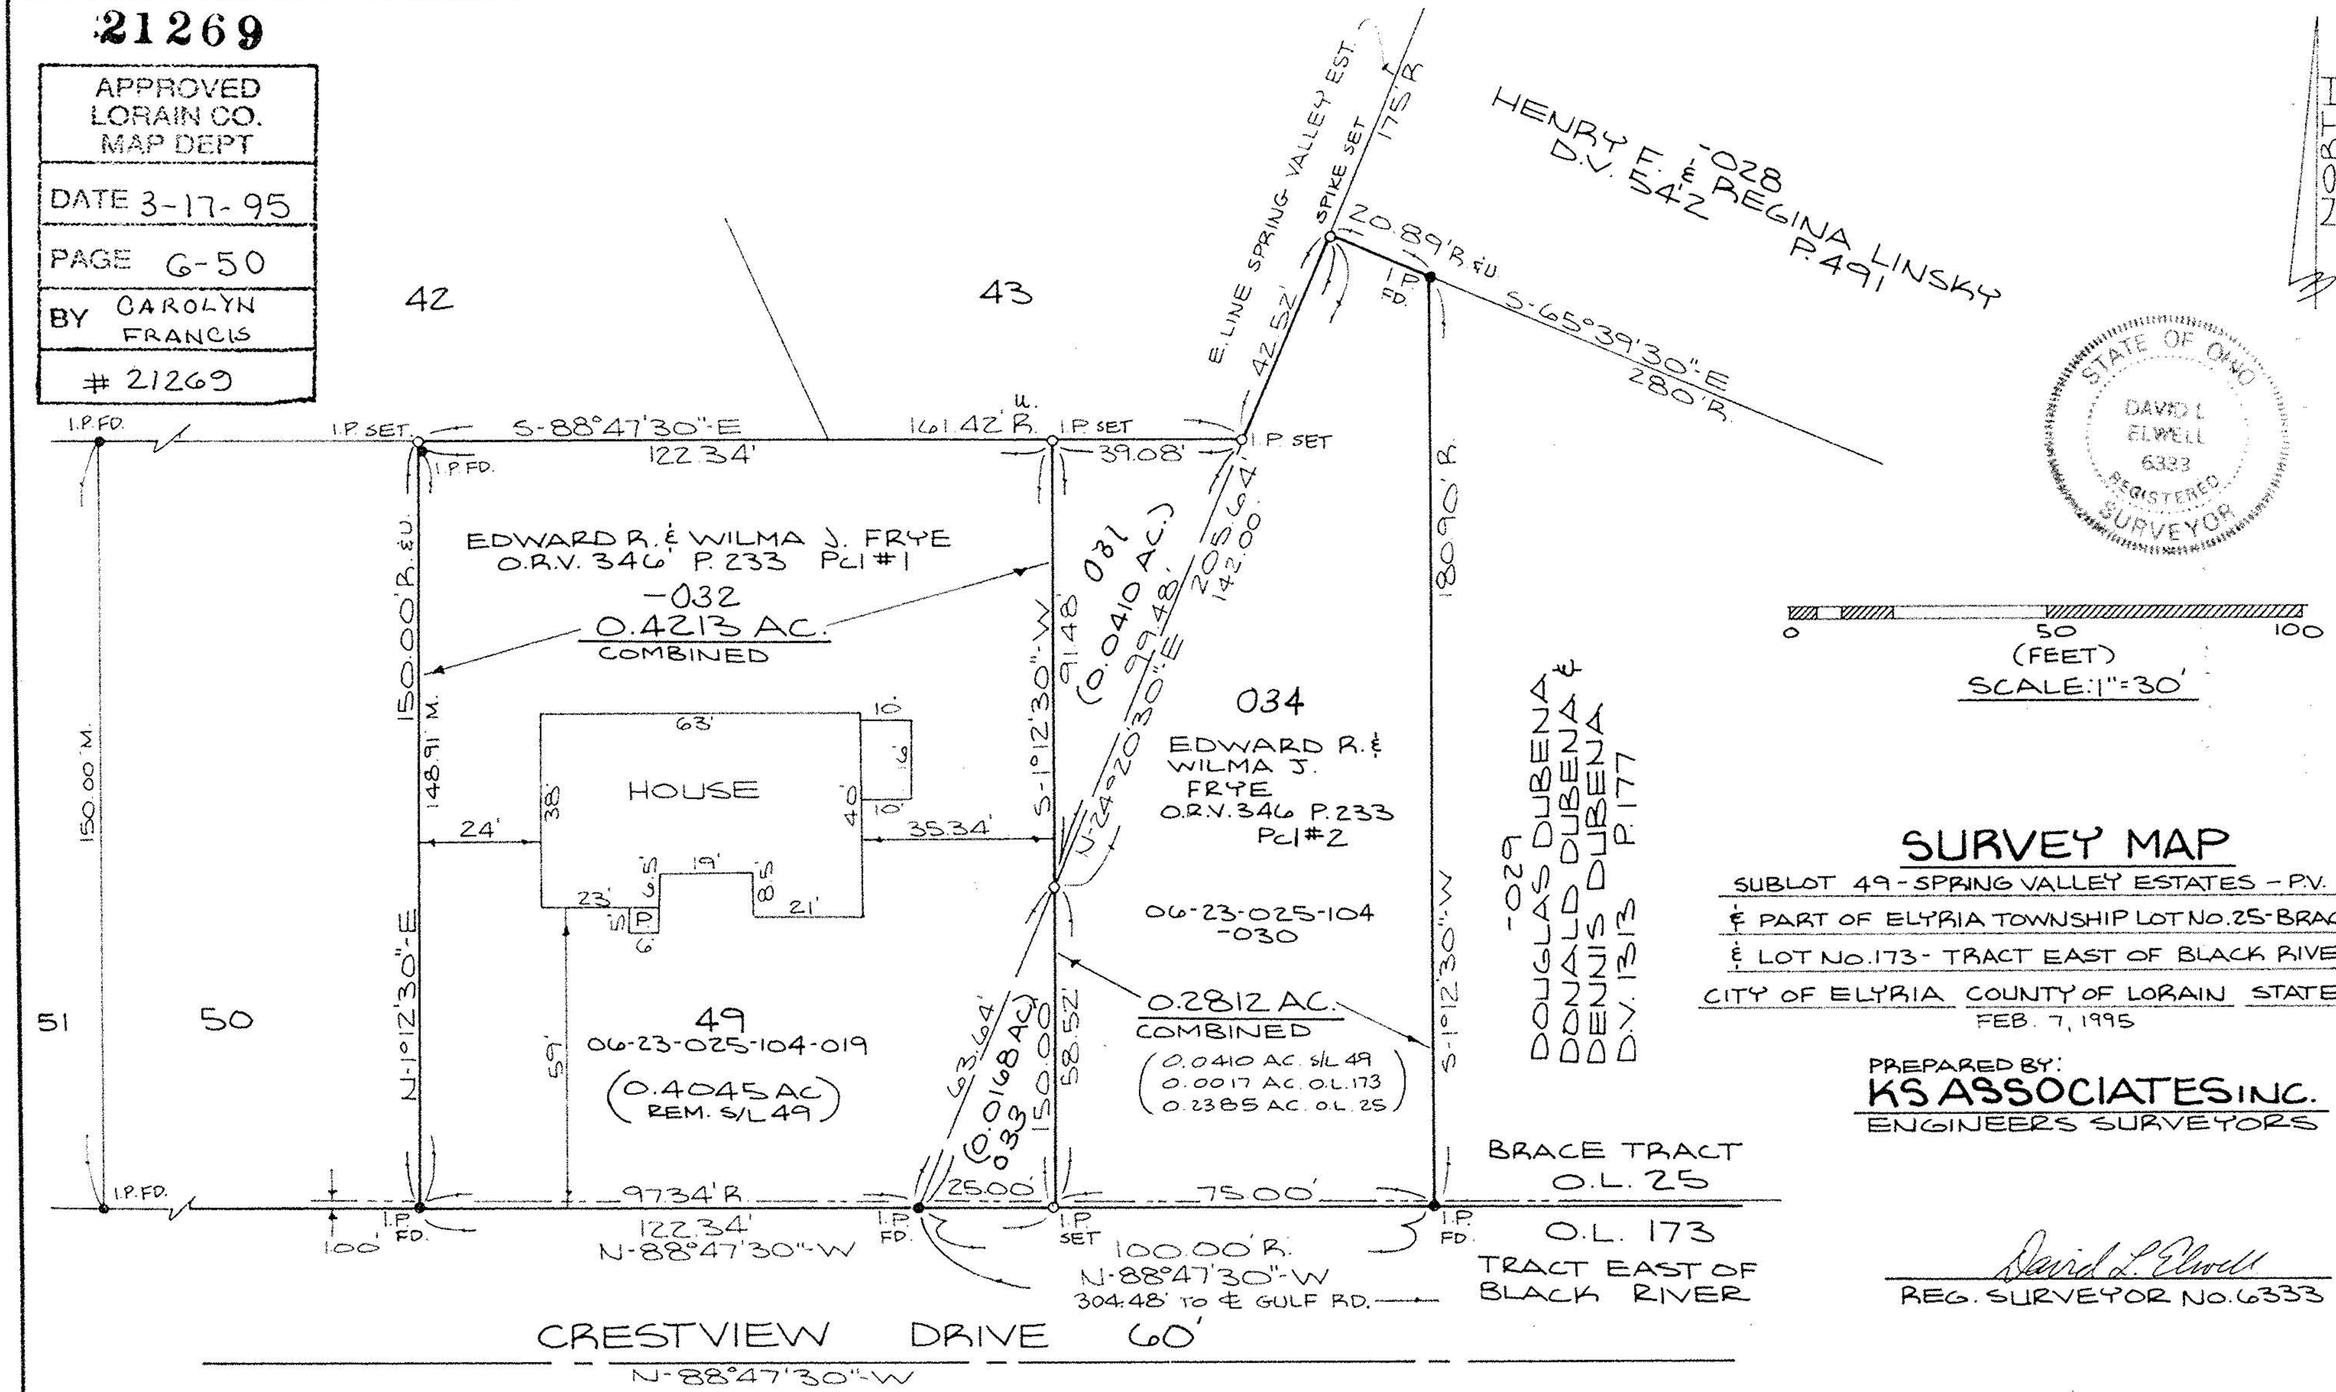

STATE OF OHIO
DAVID L. ELWELL
6333
REGISTERED
SURVEYOR

SURVEY MAP

SUBLOT 49 - SPRING VALLEY ESTATES - P.V. 19 P. 2
& PART OF ELYRIA TOWNSHIP LOT No. 25 - BRACE TRACT
& LOT No. 173 - TRACT EAST OF BLACK RIVER

CITY OF ELYRIA COUNTY OF LORAIN STATE OF OHIO

FEB. 7, 1995

PREPARED BY:
KS ASSOCIATES INC.
ENGINEERS SURVEYORS

David L. Elwell
REG. SURVEYOR No. 6333

95-008