


06-23-026

06-23-026

8750

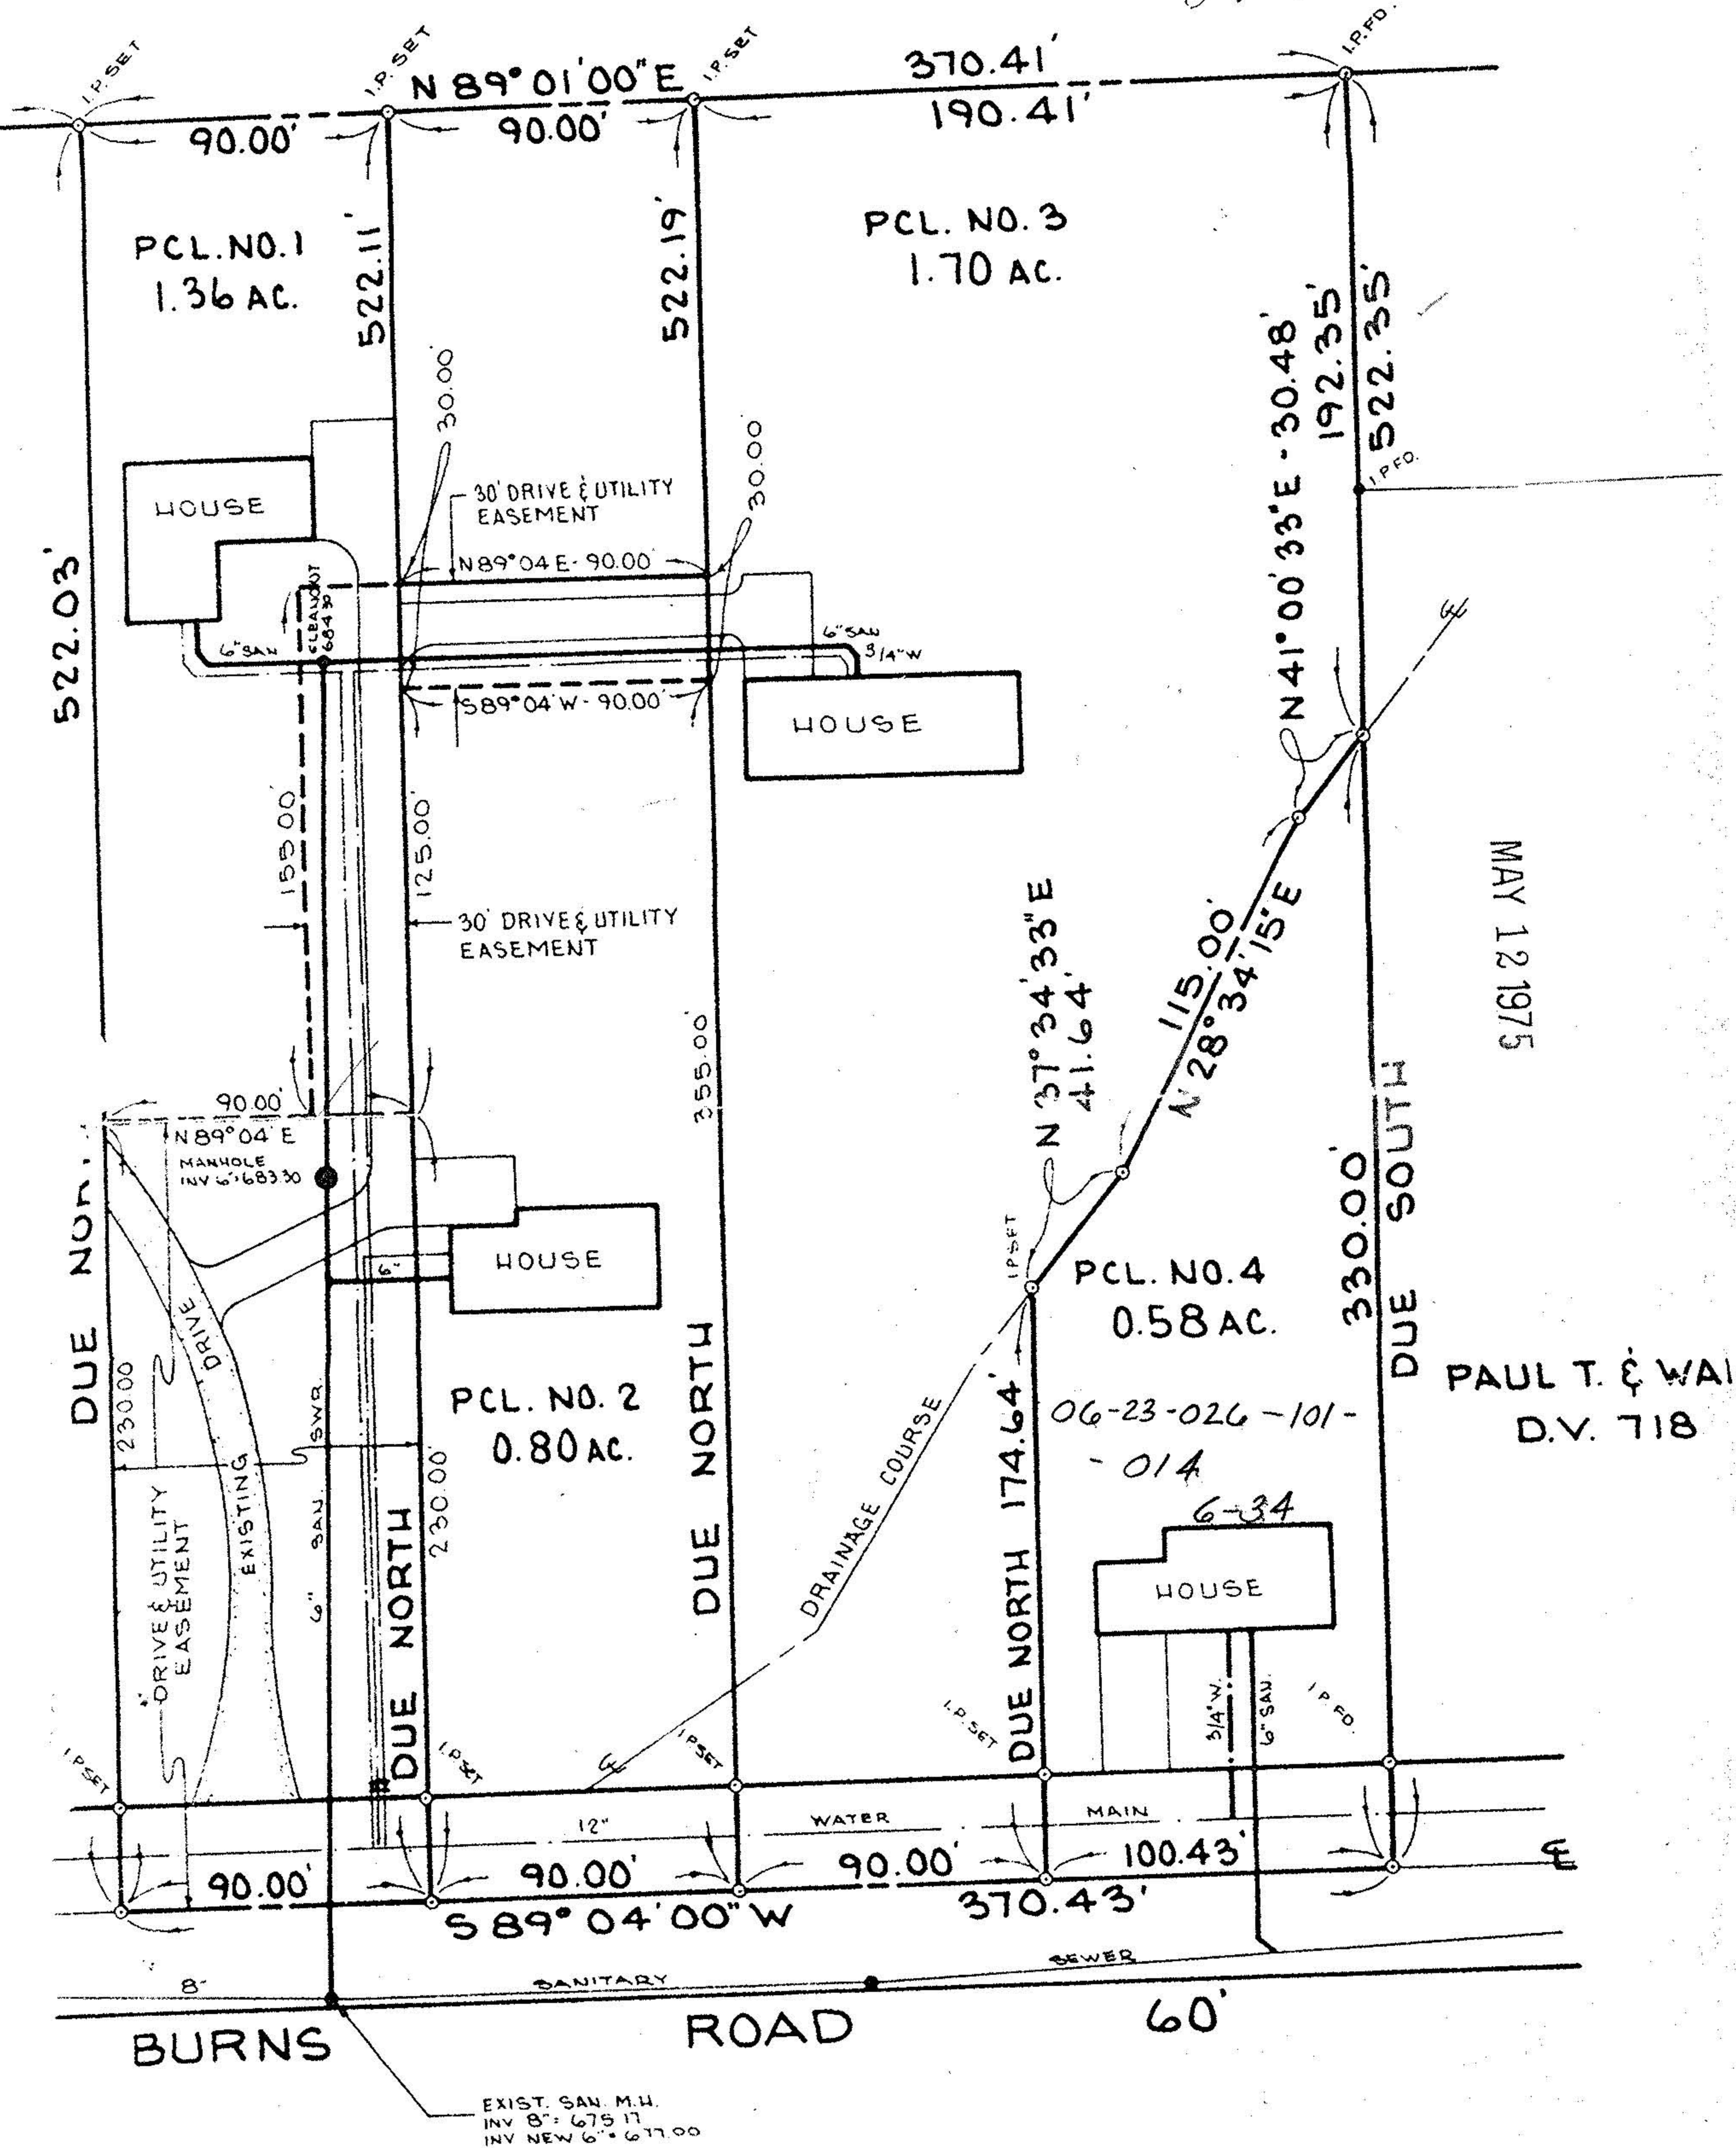


MAY 12 1975

PAUL T. & WAI
D.V. 718

06-23-026-101-014

6-34

DEC 1 1975

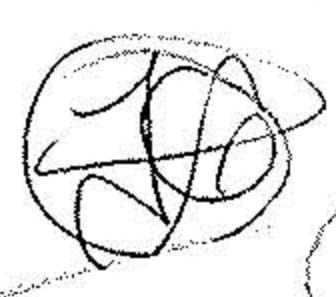

23-026