


6-2-71
11-1-77
L.C. 23-017-101-033

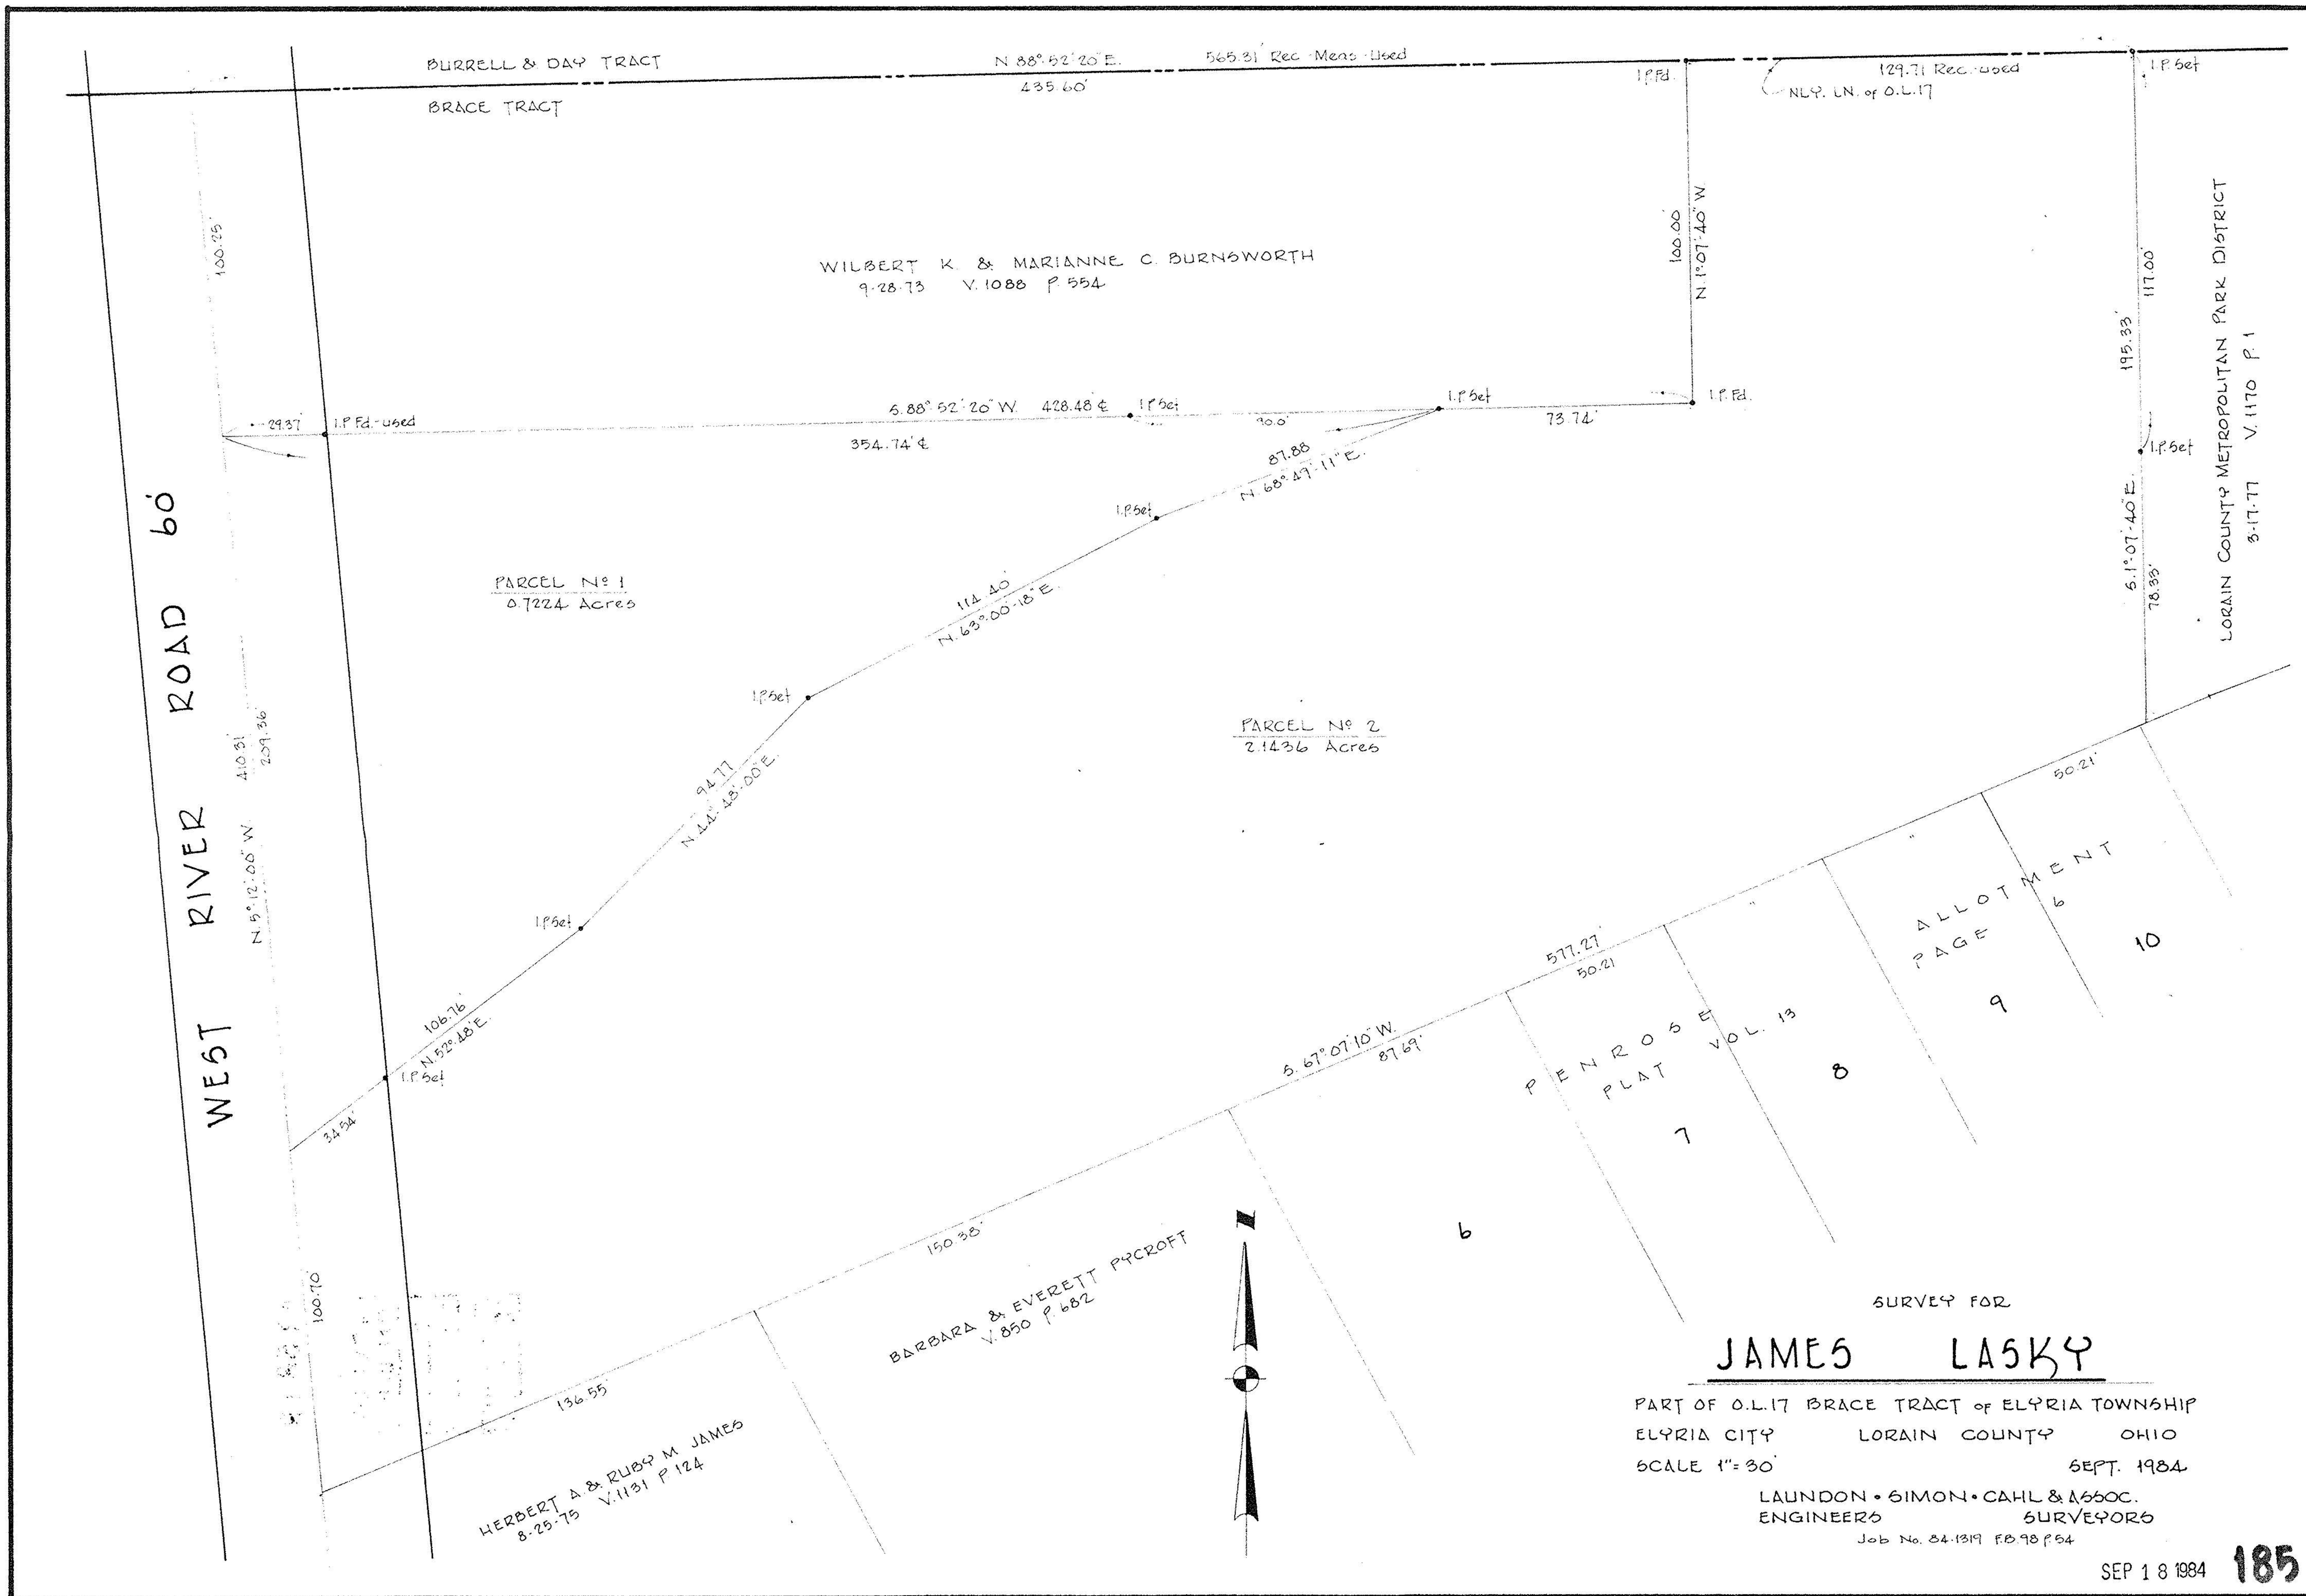

6-2-71
11-1-77
L.C. 23-017-101-033
- 101-110-22-20 # 15819 # 62-9