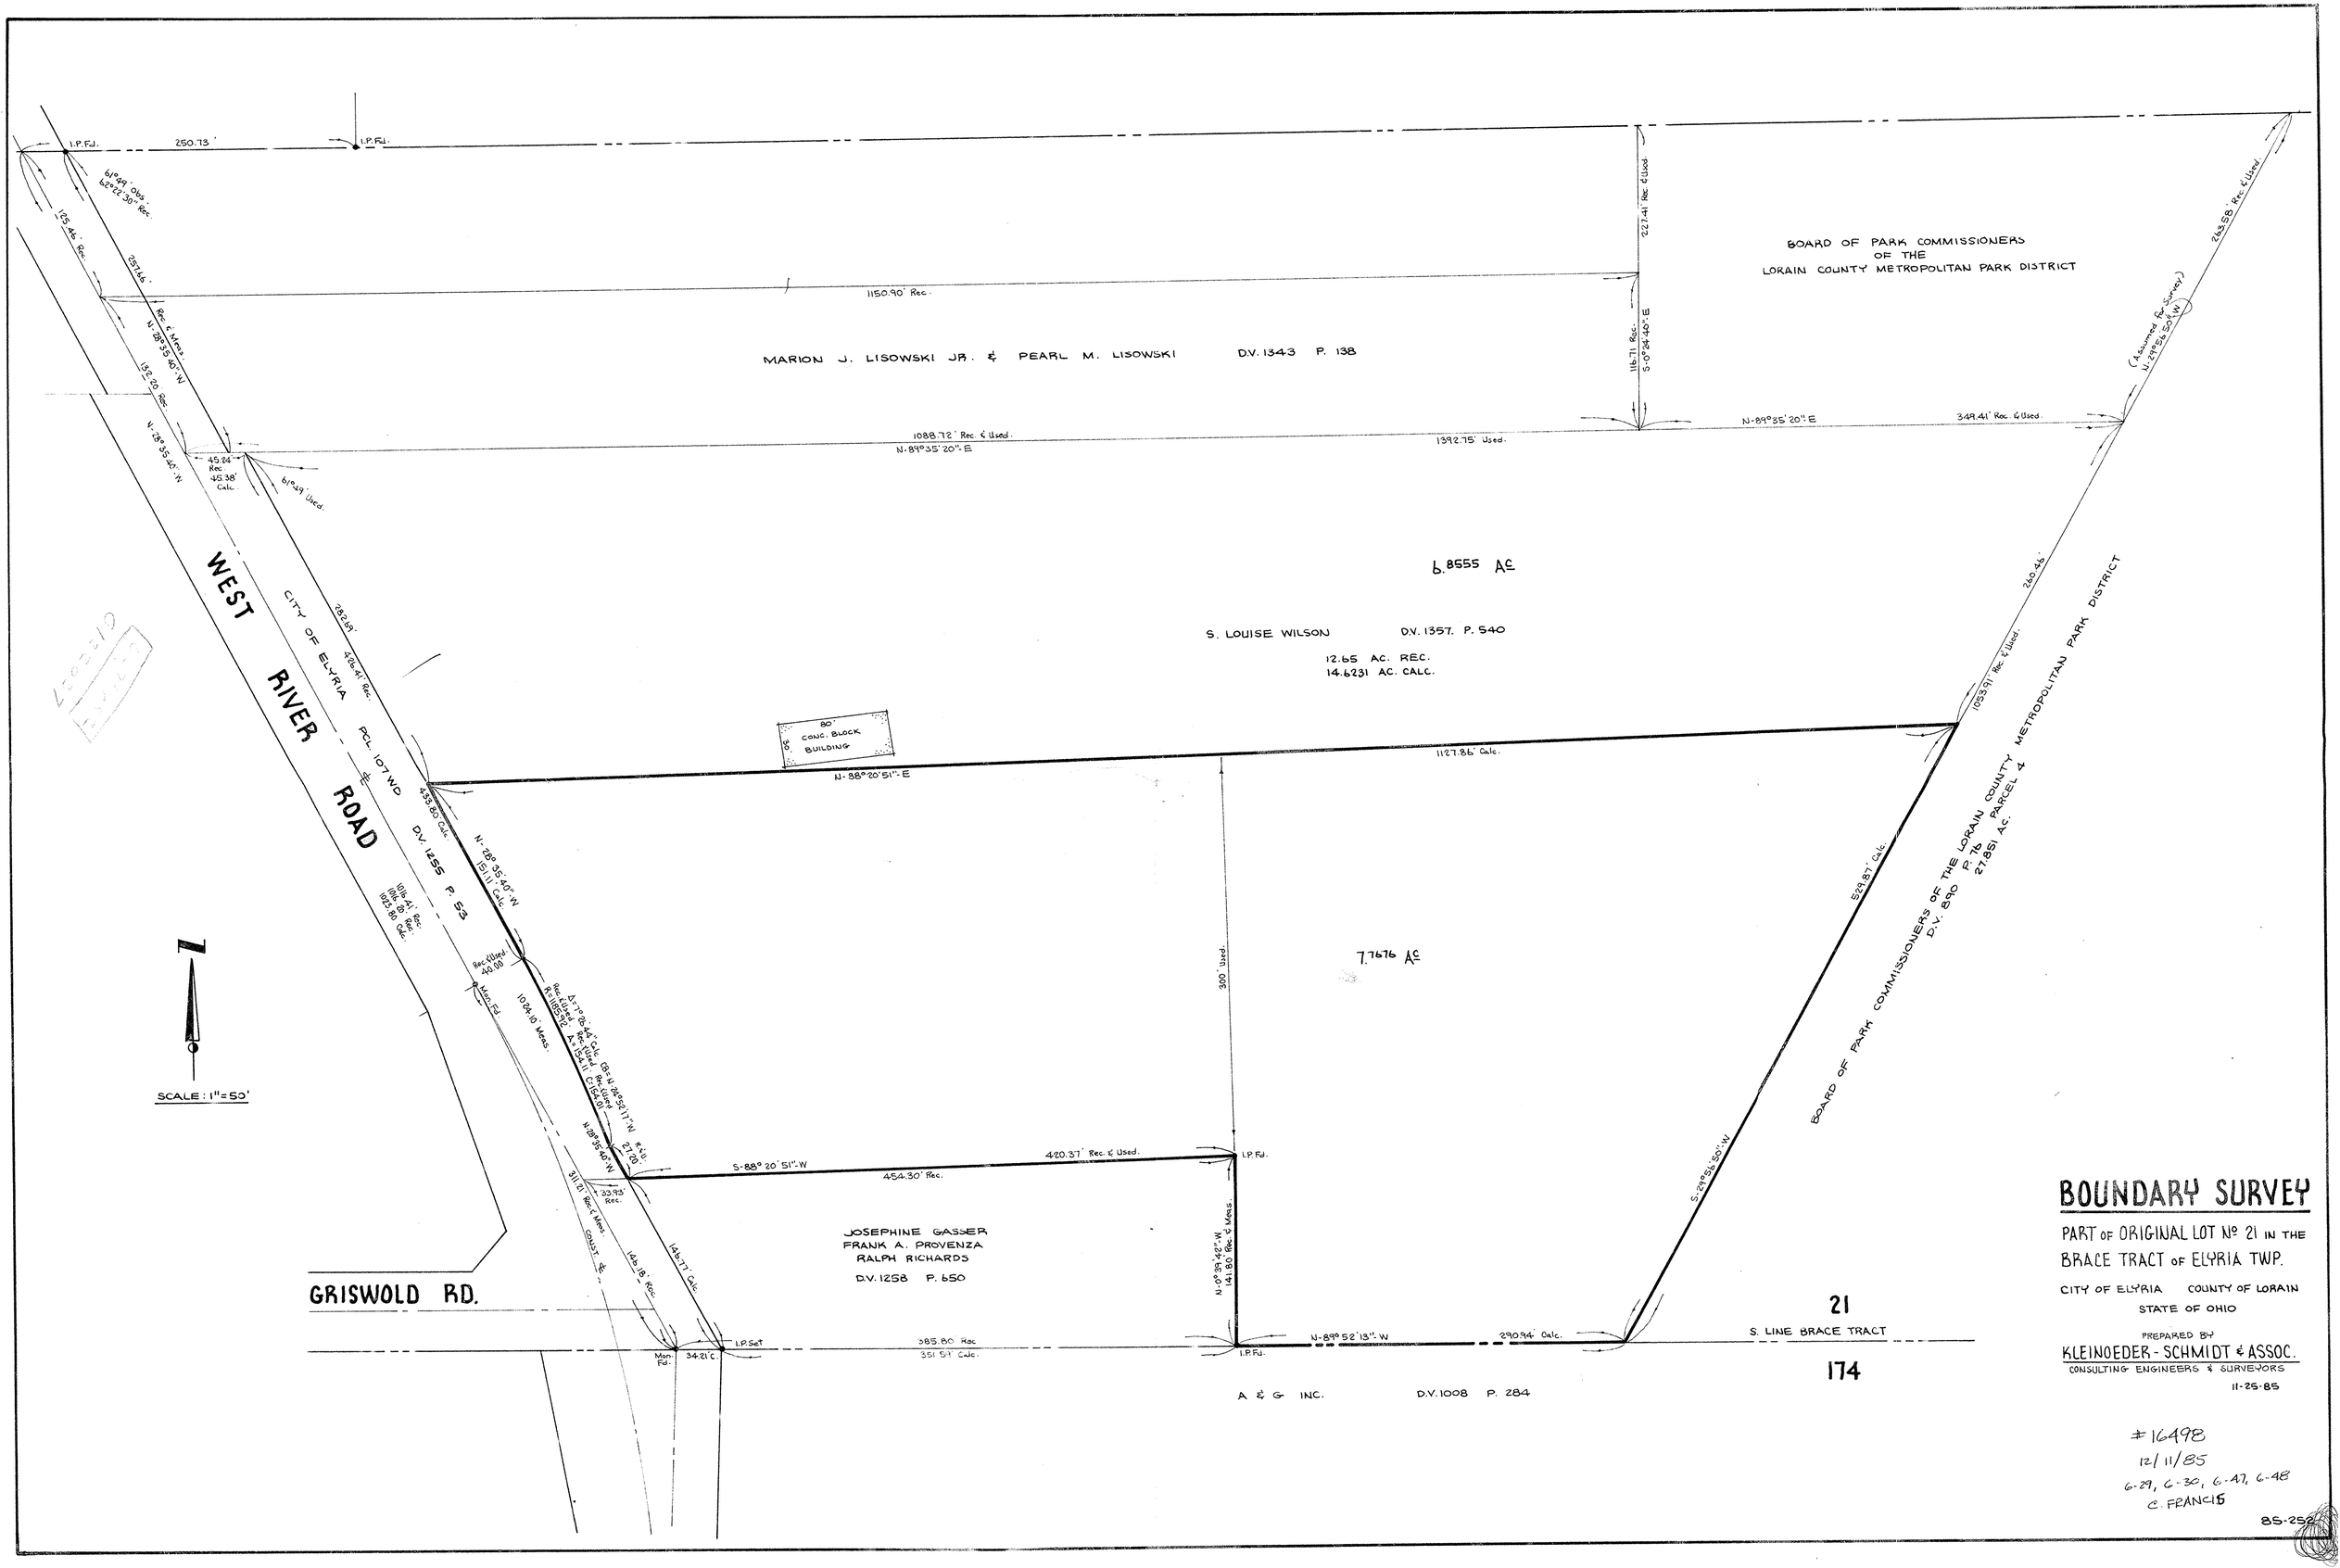

BOUNDARY SURVEY

PART OF ORIGINAL LOT Nº 21 IN THE BRACE TRACT OF ELYRIA TWP.

CITY OF ELYRIA COUNTY OF LORAIN
STATE OF OHIO

PREPARED BY
KLEINOEDER - SCHMIDT & ASSOC.
CONSULTING ENGINEERS & SURVEYORS
11-25-85

#16498
12/11/85
6-29, 6-30, 6-47, 6-48
C. FRANCIS

85-252