BOUNDARY & LOT SPLIT SURVEY
SUBLOT 3
LIBERTY COURT INDUSTRIAL PARK
PLAT VOLUME 36, PAGES 8&9
PART OF ORIGINAL ELYRIA TOWNSHIP LOT NO. 9
BRACE TRACT

NORTH

GRAPHIC SCALE
0 50
25 100
(IN FEET)

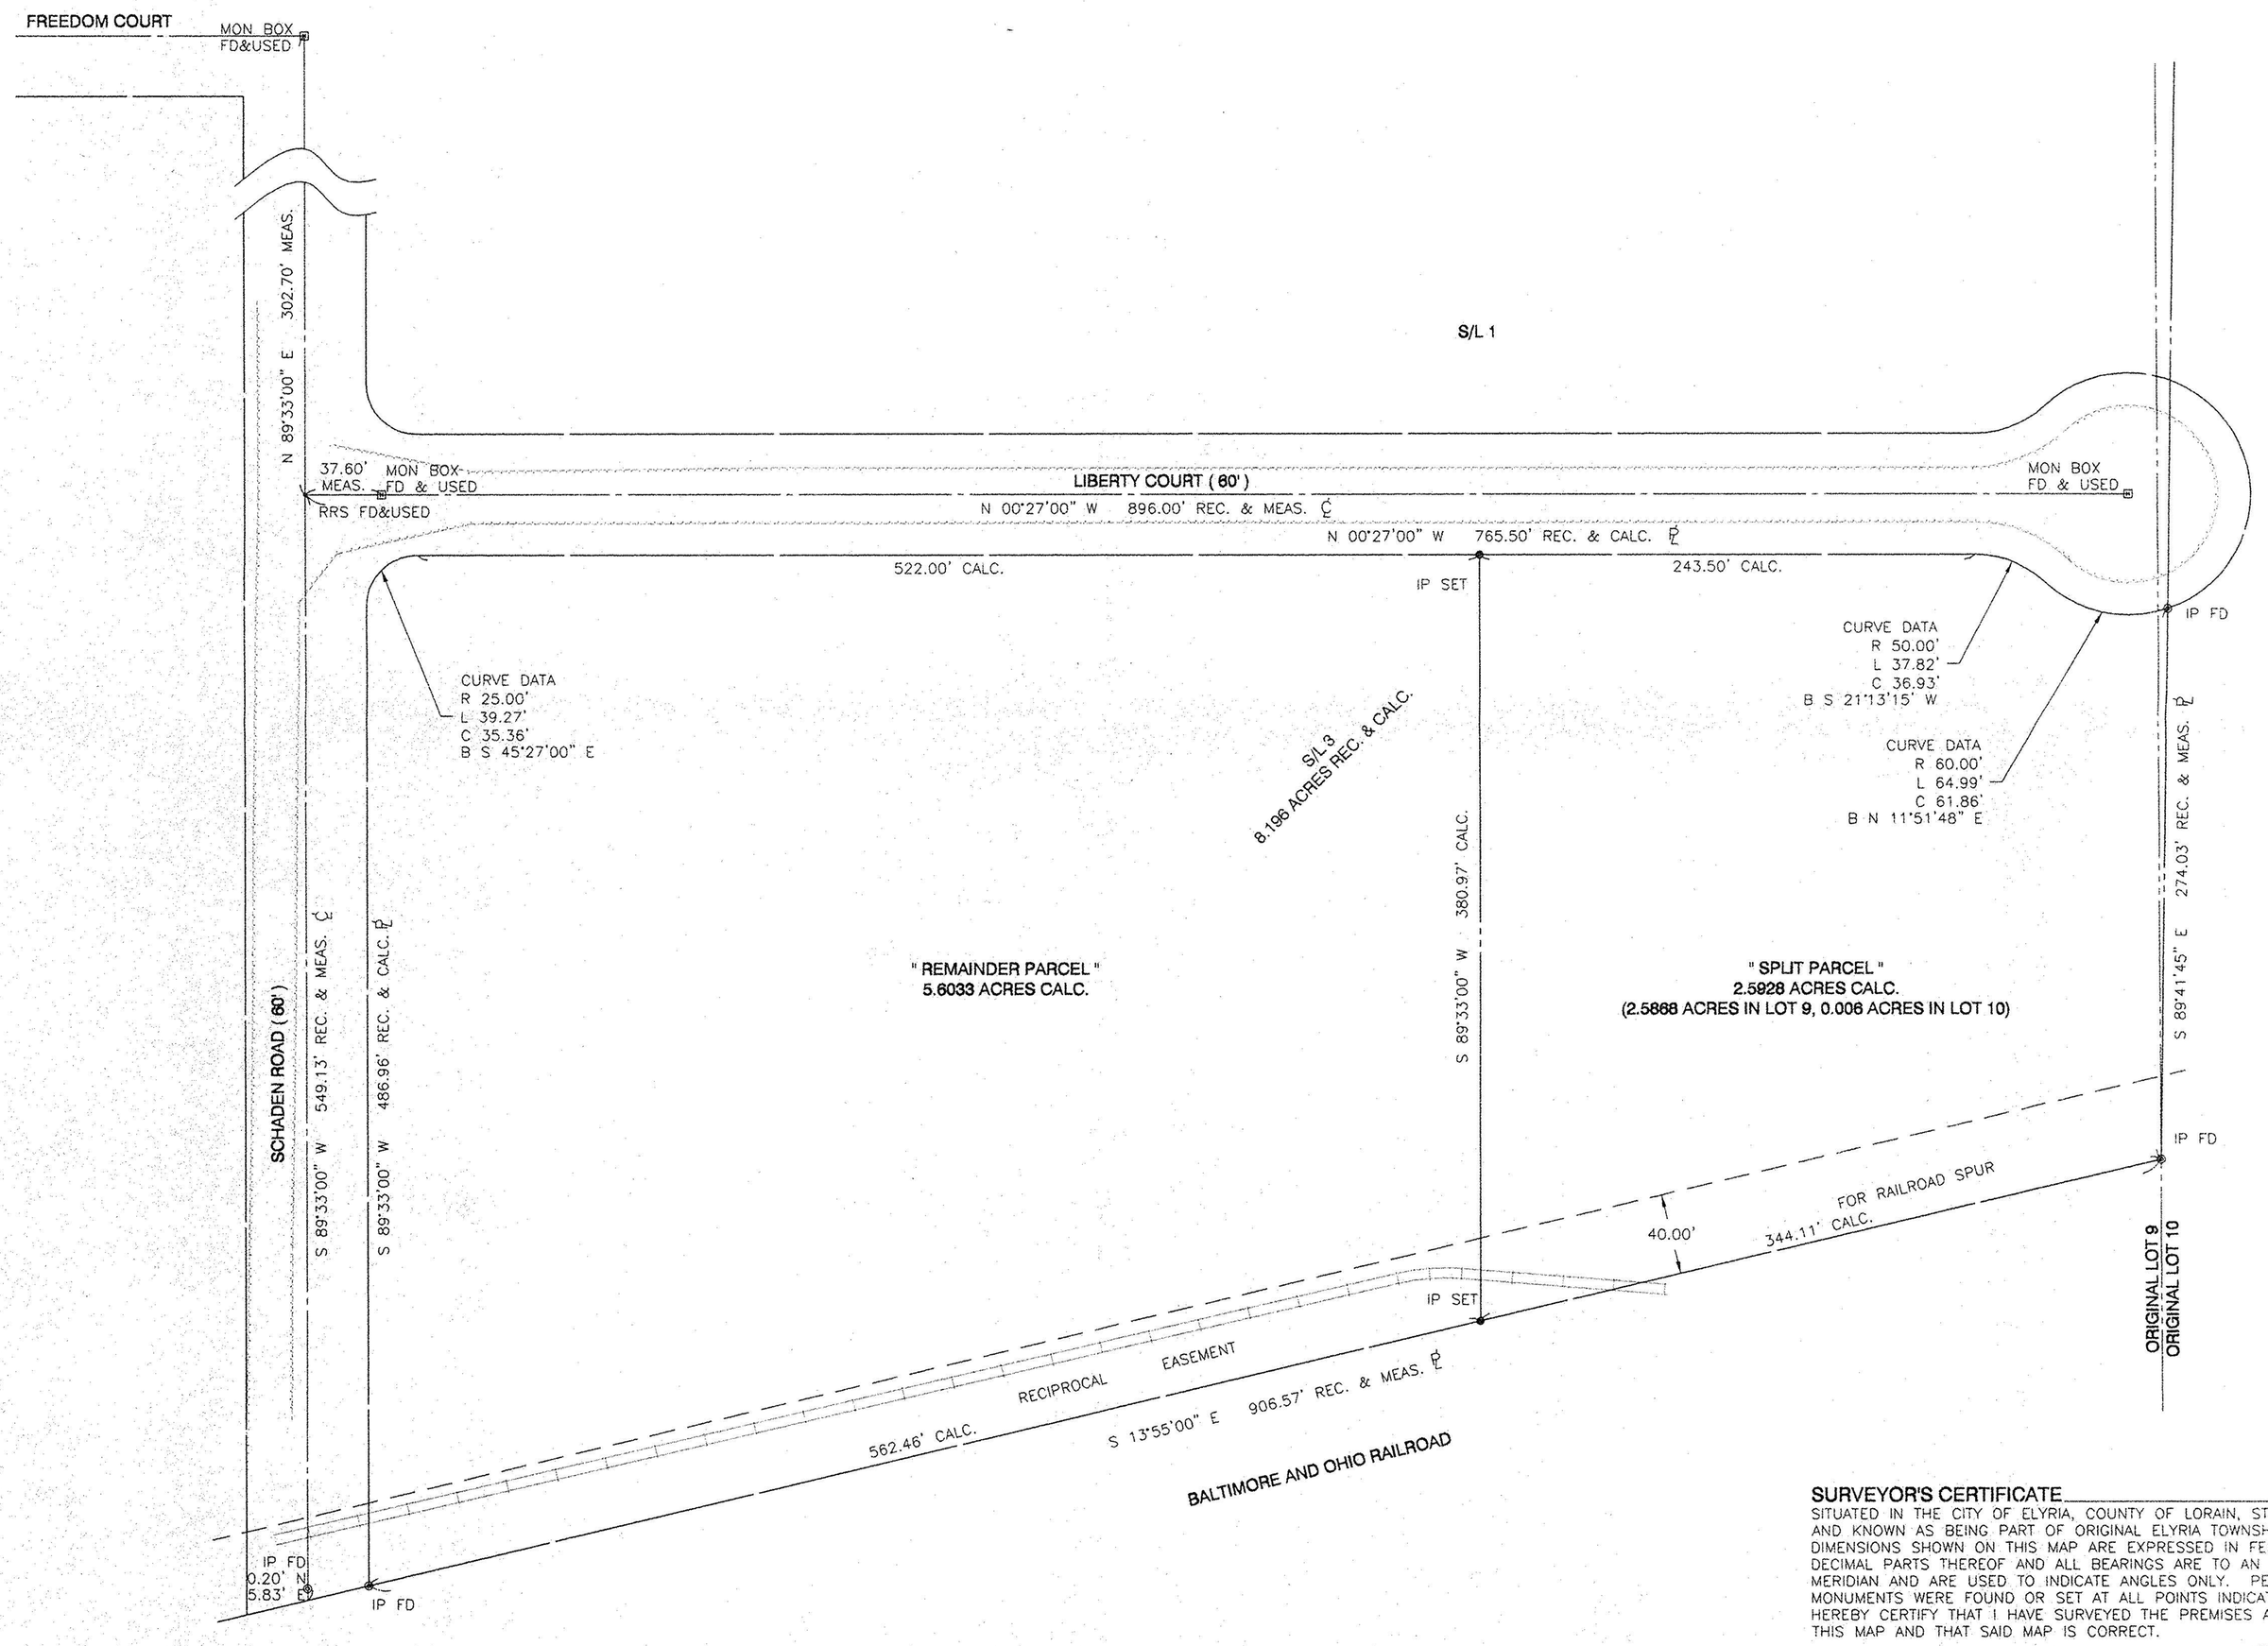

#22338

APPROVED LORAIN CO. MAP DEPT
DATE 10/31/97
PAGE 6-25
BY K. Colbert

SURVEYOR'S CERTIFICATE

SITUATED IN THE CITY OF ELYRIA, COUNTY OF LORAIN, STATE OF OHIO, AND KNOWN AS BEING PART OF ORIGINAL ELYRIA TOWNSHIP LOT NO. 9. DIMENSIONS SHOWN ON THIS MAP ARE EXPRESSED IN FEET AND DECIMAL PARTS THEREOF AND ALL BEARINGS ARE TO AN ASSUMED MERIDIAN AND ARE USED TO INDICATE ANGLES ONLY. PERMANENT MONUMENTS WERE FOUND OR SET AT ALL POINTS INDICATED. I HEREBY CERTIFY THAT I HAVE SURVEYED THE PREMISES AND PREPARED THIS MAP AND THAT SAID MAP IS CORRECT.

STATE OF OHIO
DOUGLAS H. MOSLEY
6303
REGISTERED
PROFESSIONAL SURVEYOR

Doug Mosley

DOUG MOSLEY
REGISTERED SURVEYOR NO. 6303

BRAMHALL
ENGINEERING & SURVEYING COMPANY
37311 HARVEST DRIVE
AVON, OHIO 44011
(216) 934-7878

BOUNDARY & LOT SPLIT SURVEY
S/L 3 LIBERTY COURT
ELYRIA, OHIO

N

SCALE
1" = 50'

DATE
8/97

REV.
8/21/97

SHEET
1 / 1

JOB NO.
97-256
\97256S2.DWG