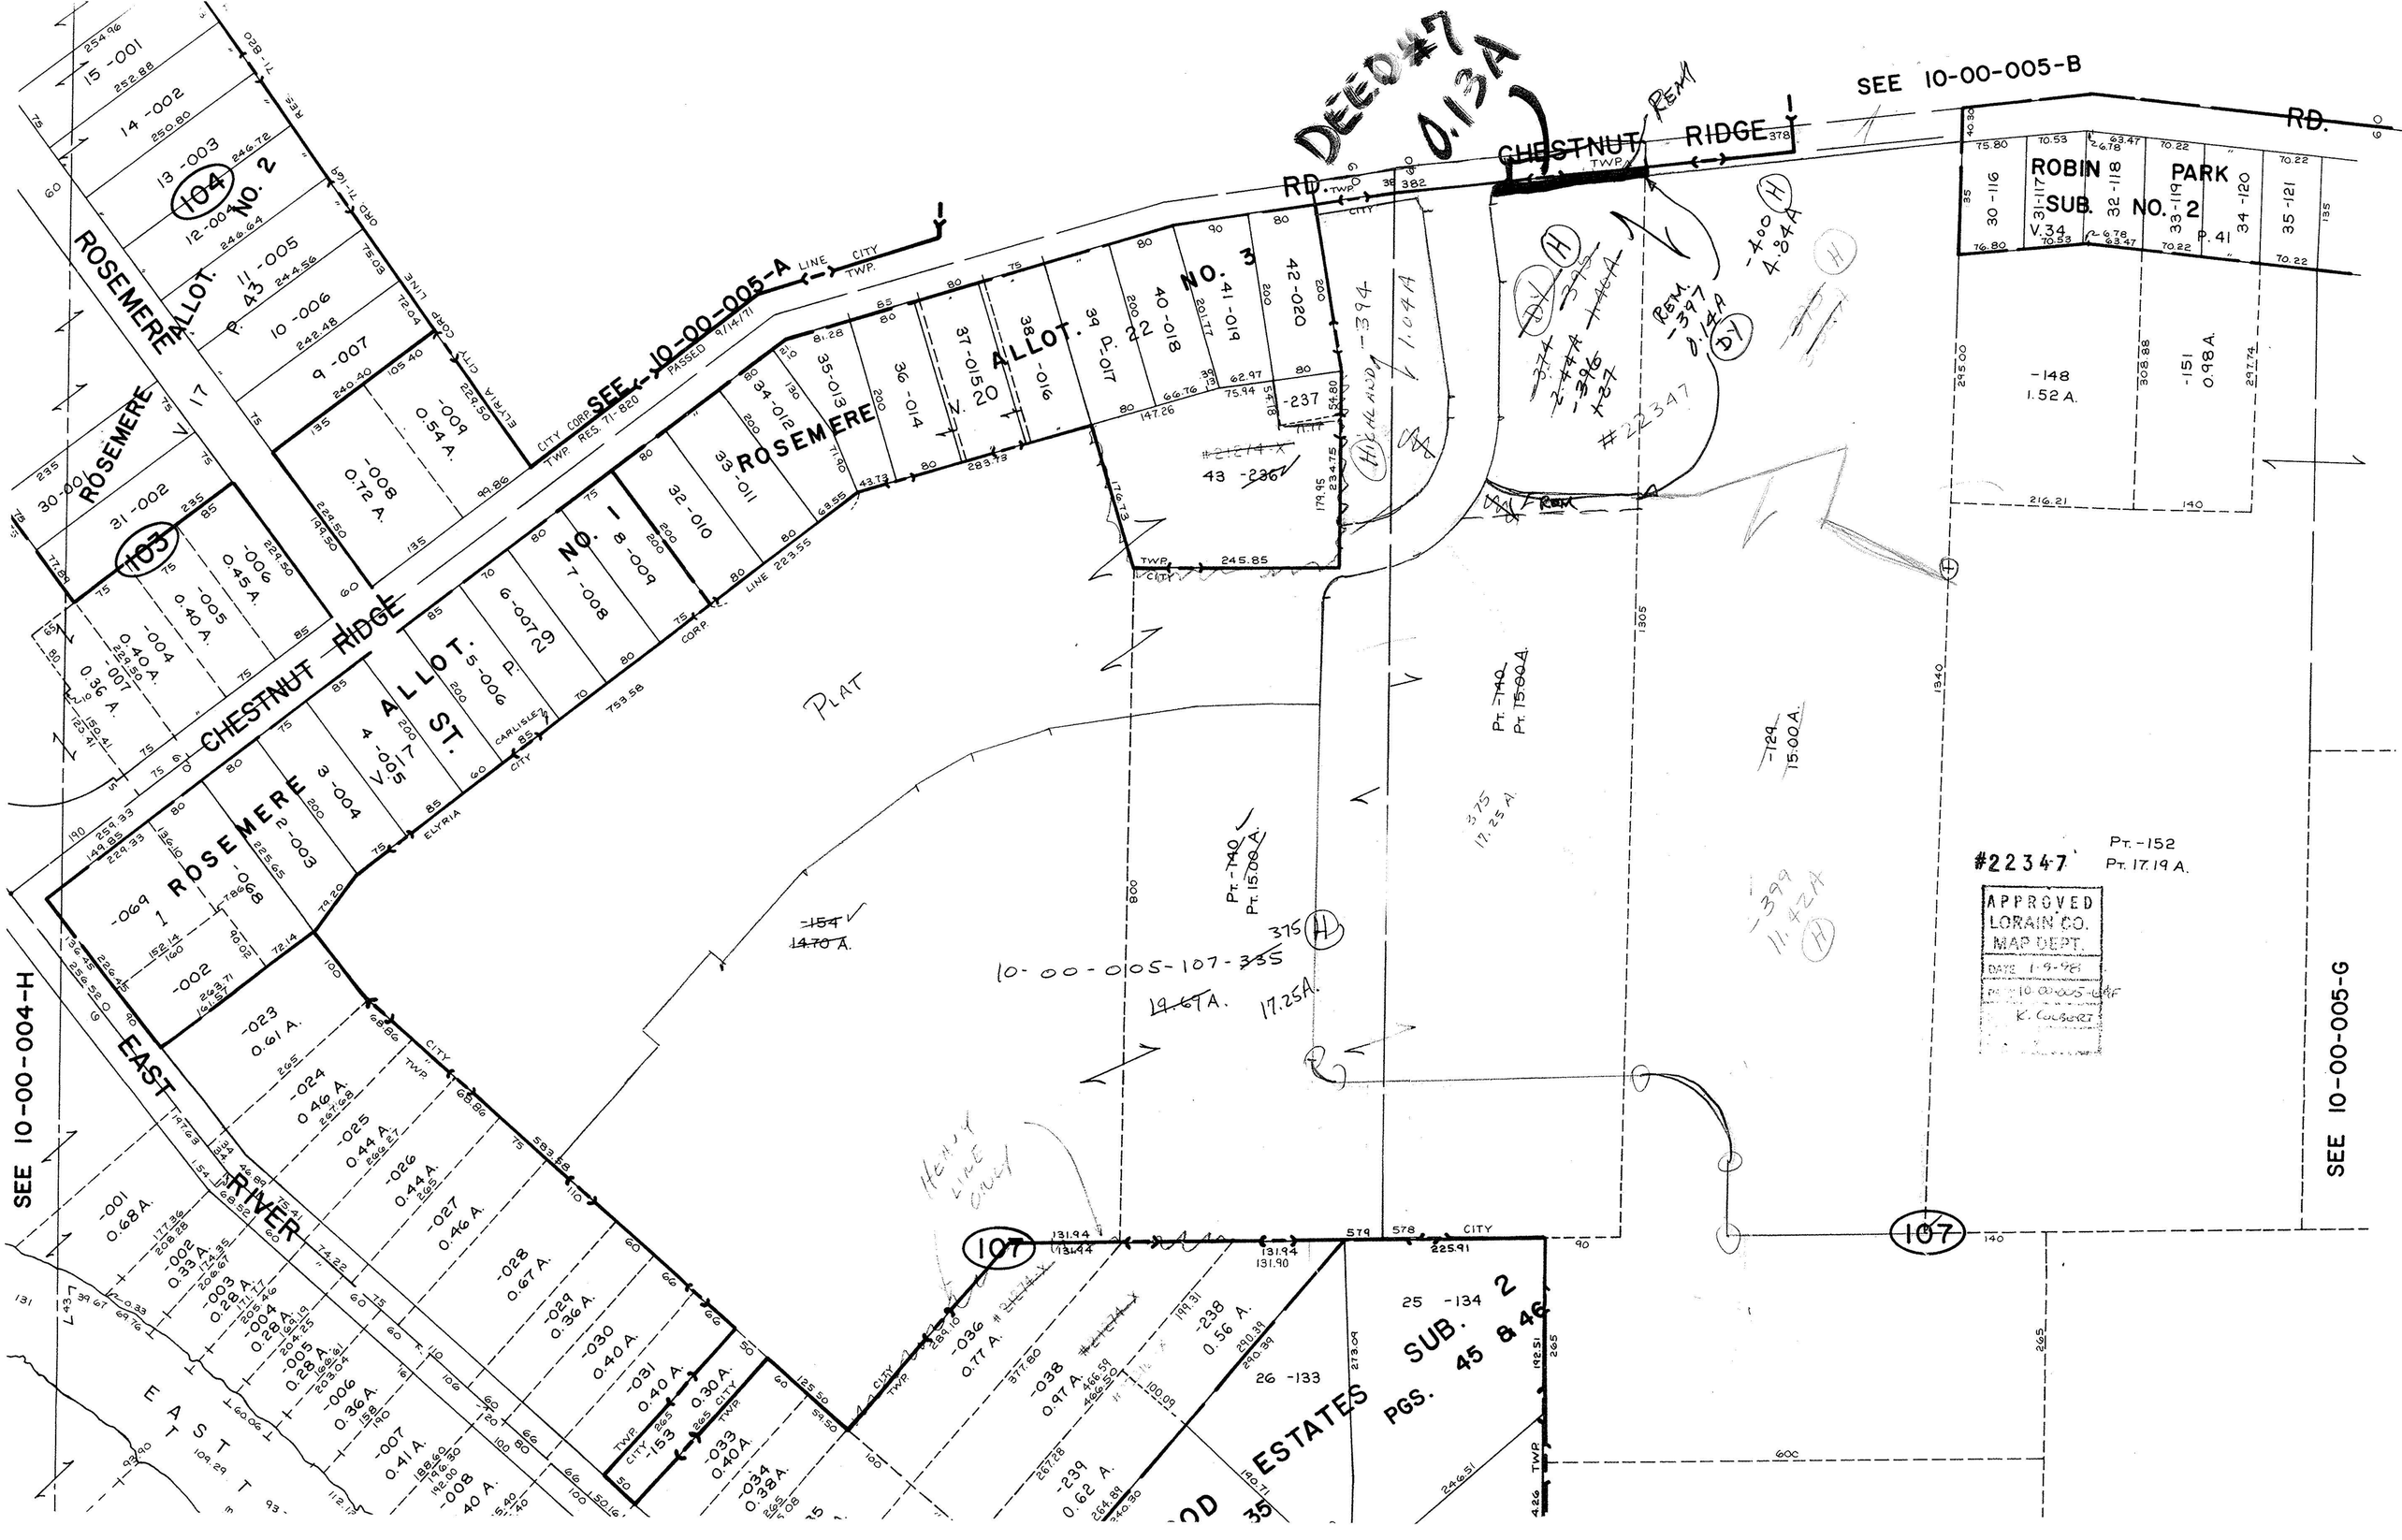

DEED #7
0.13A
SEE 10-00-005-B
CHESTNUT RIDGE RD.
ROBIN PARK SUB. NO. 2
V.34 P. 41
ROSEMERE ALLOT. NO. 2
ROSEMERE ALLOT. NO. 3
ROSEMERE ALLOT. NO. 1
CHESTNUT RIDGE
ROSEMERE ALLOT. ST.
EAST RIVER
SEE 10-00-004-H
SEE 10-00-005-G
SEE 10-00-005-A
PLAT
HIGHLAND
#22347
APPROVED LORAIN CO. MAP DEPT.
DATE 1-9-98
K. COLBERT
10-00-0105-107-335
17.25A.
Pt. -152
Pt. 17.19 A.
ESTATES SUB. 2
PGS. 45 & 46