


NORTH  
SCALE 1" = 50'

Man. Box  
STA. 7+34.54

Man. Box  
STA. 75+32.15

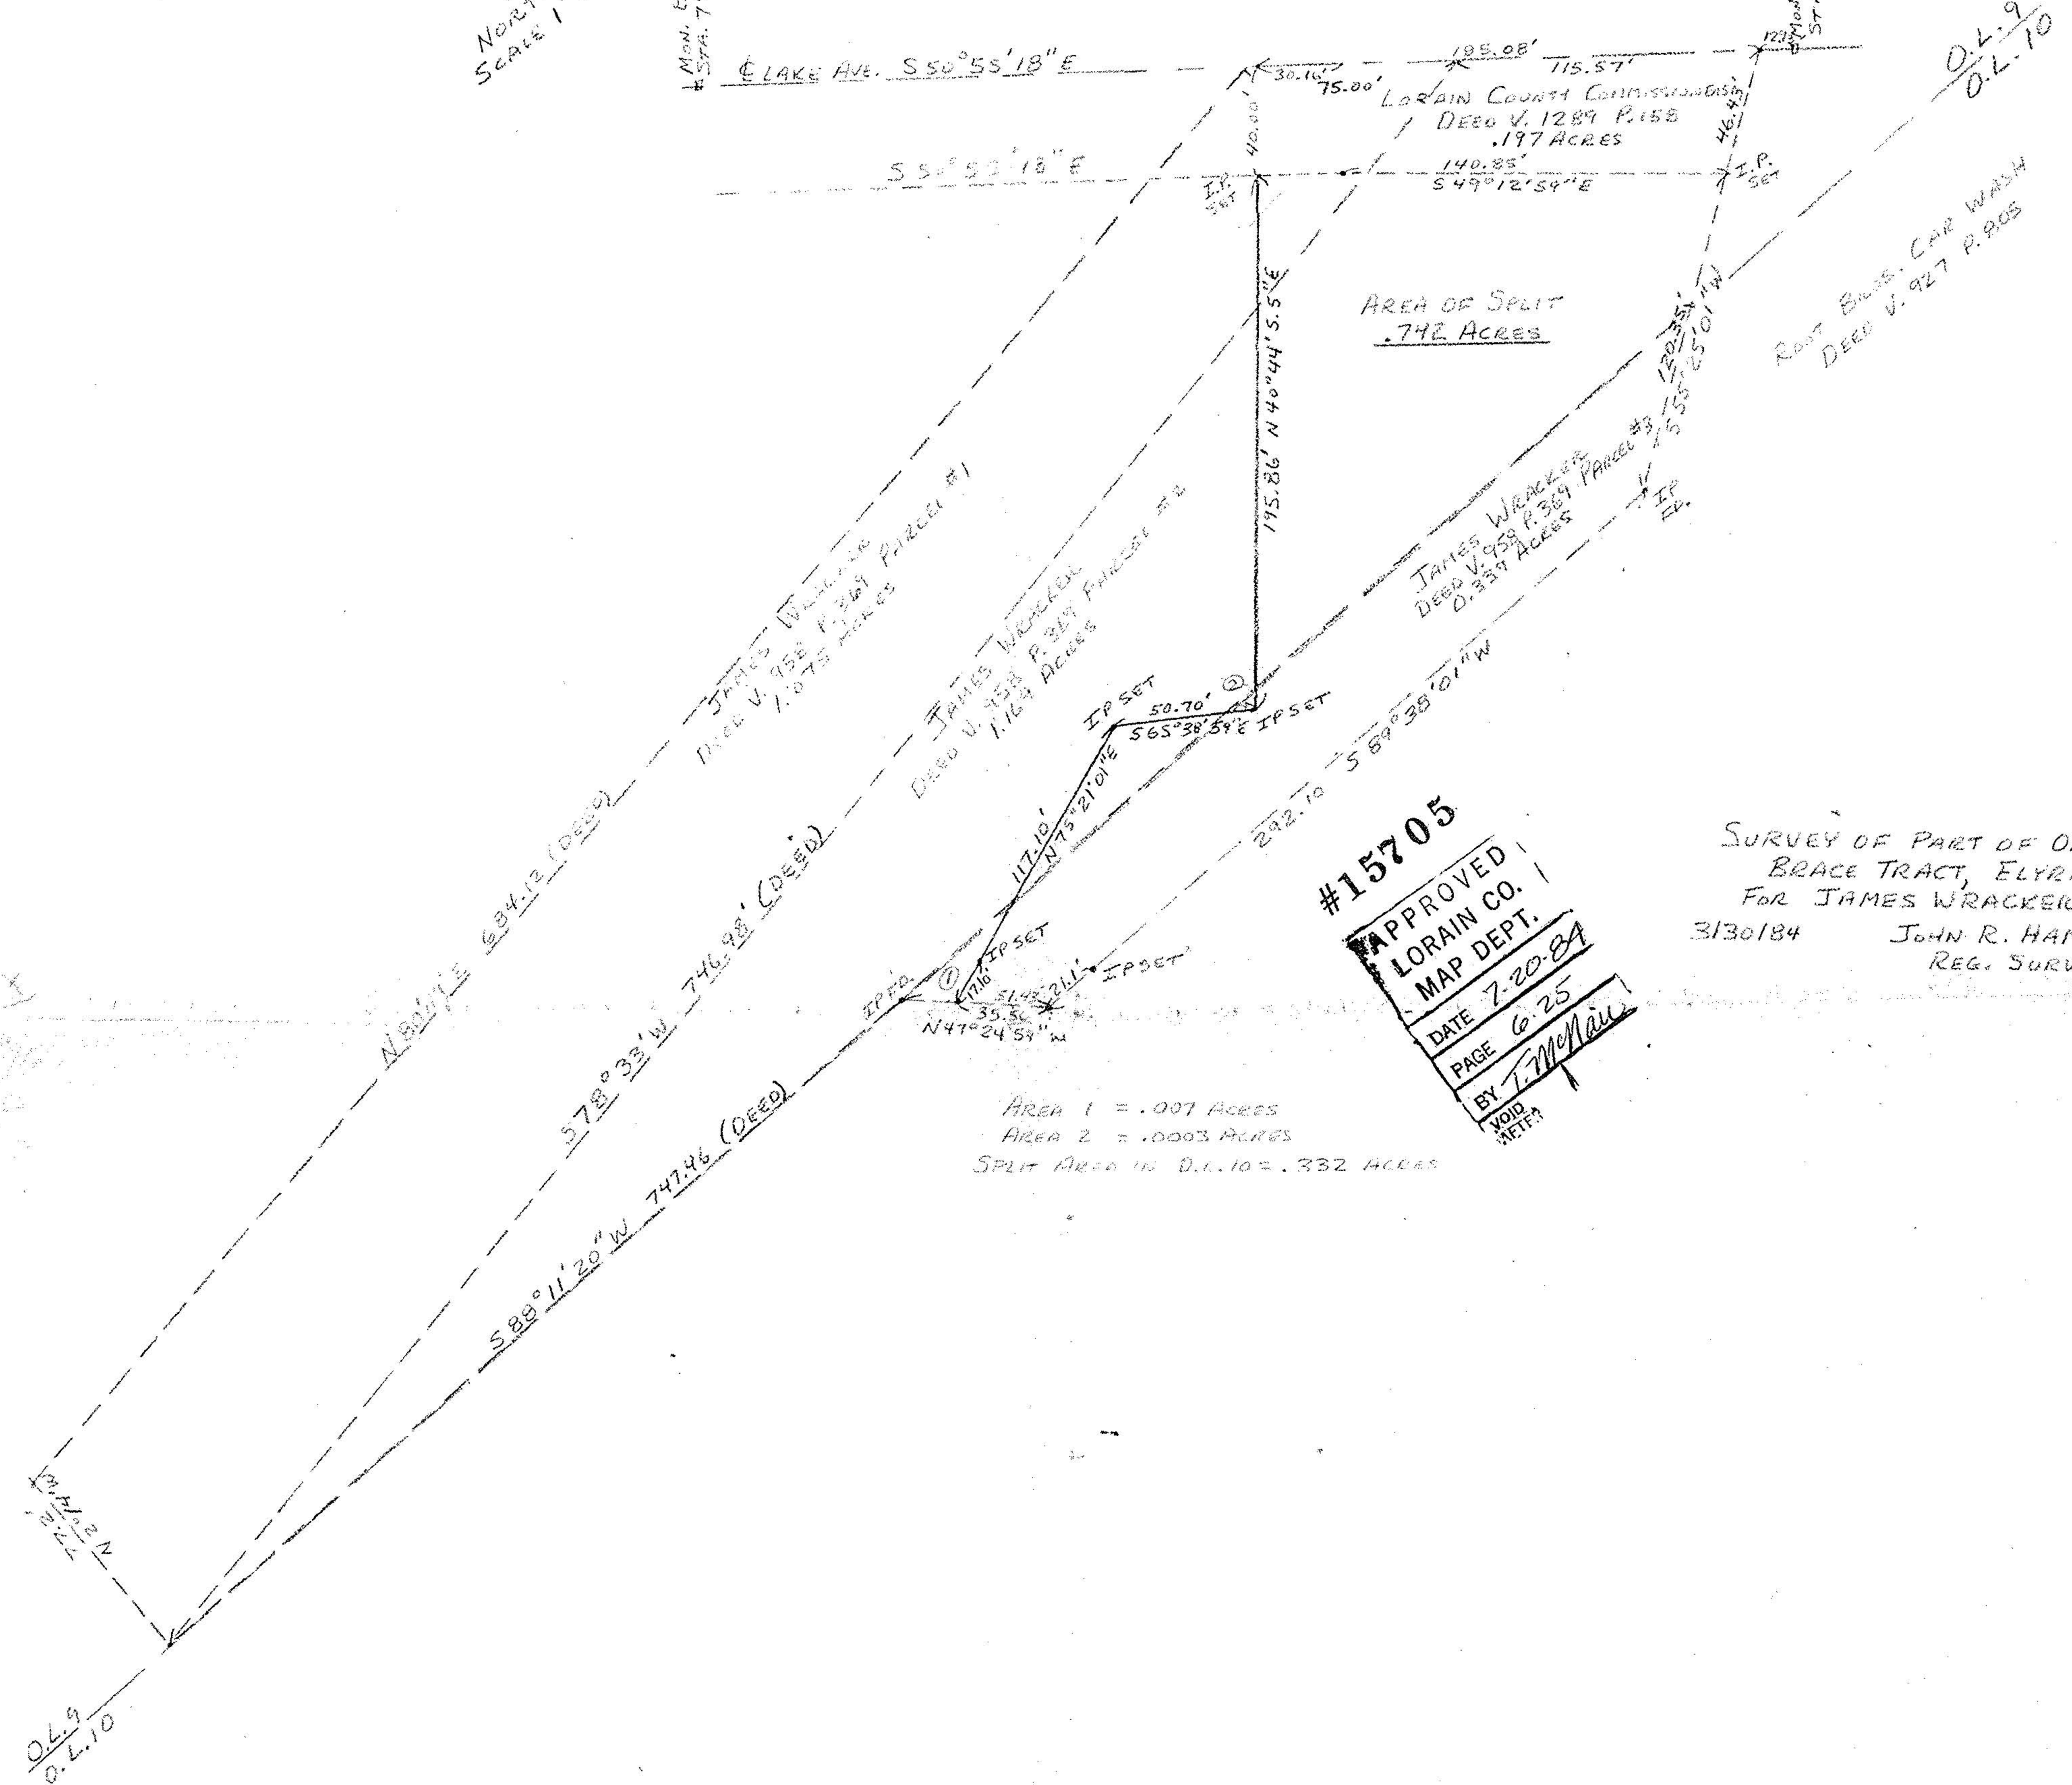

#15705  
APPROVED  
LORAIN CO.  
MAP DEPT.  
DATE 7-20-84  
PAGE 6-25  
BY T. McNeil  
VOID  
METER

SURVEY OF PART OF O.L. 9+10  
BRACE TRACT, ELYRIA TWP.  
FOR JAMES WRACKER  
3/30/84 JOHN R. HAMILTON  
REG. SURV. #6861

Area 1 = .007 Acres  
Area 2 = .0003 Acres  
SPLIT Area in O.L. 10 = .332 ACRES