9261
6-21

PLAT OF SURVEY FOR
MRS. ELIZABETH BREZNAI
ORIGINAL LOTS 2&3 - BRACE TRACT - EL RIA TWP.
LORAIN COUNTY - OHIO
SCALE: 1" = 100' MARCH - 19
Gary E. Penfound Reg. Surveyor N 4457

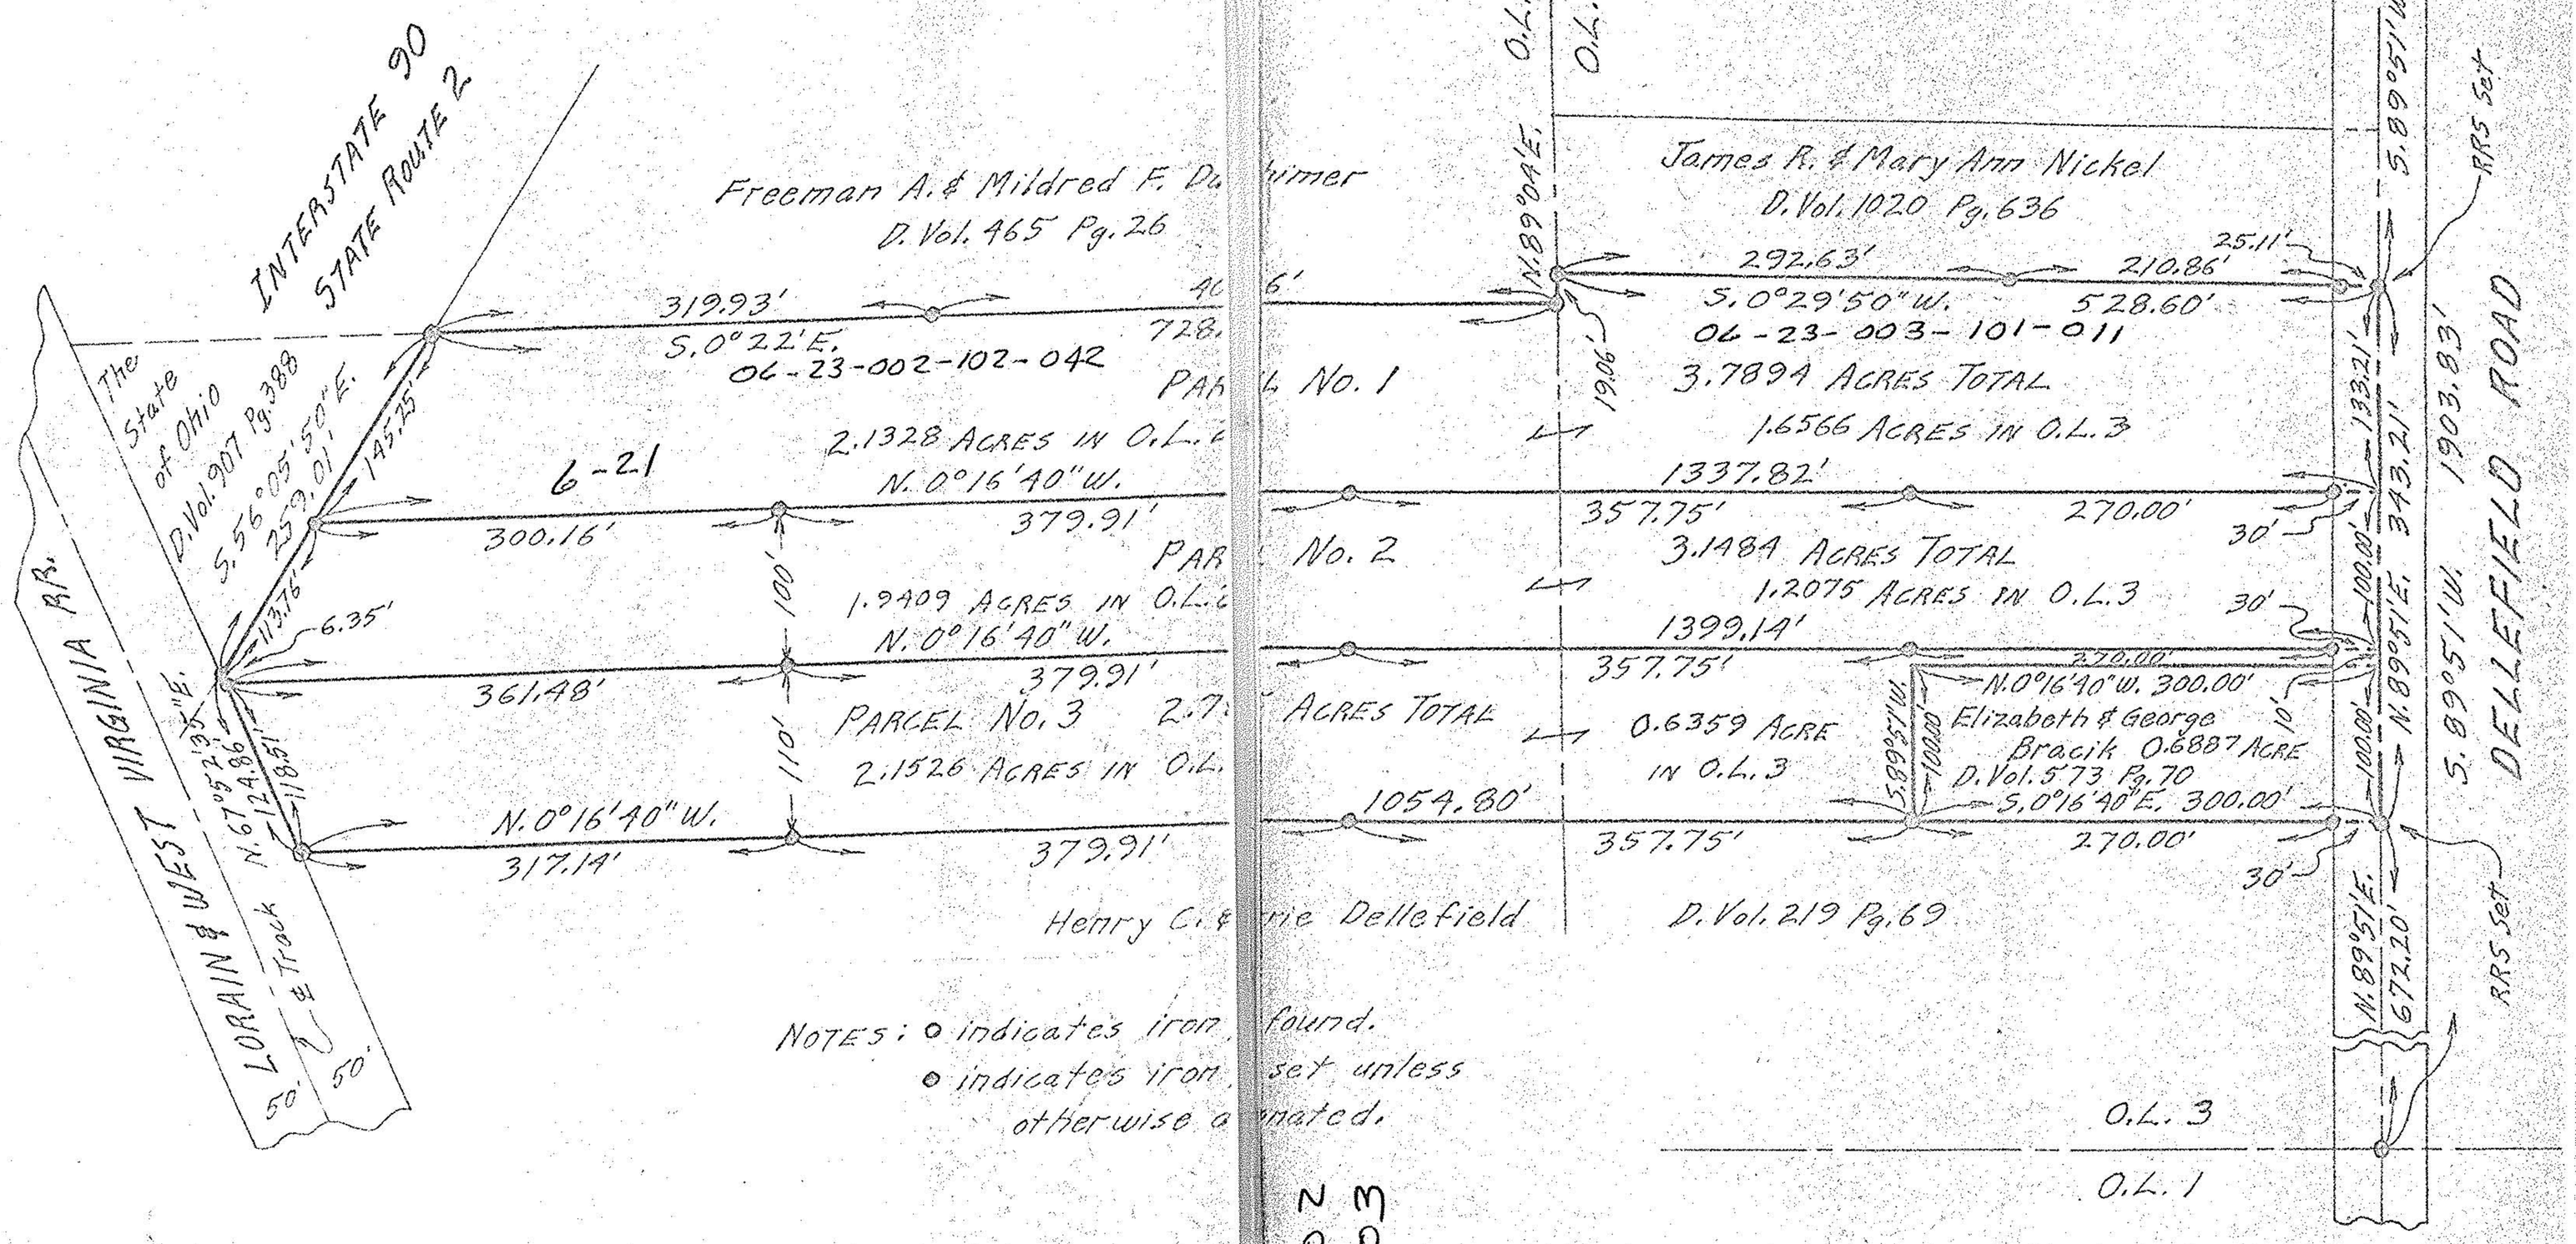

NOTES: ○ indicates iron found.
● indicates iron set unless otherwise a nated.

6-23-002
6-23-003