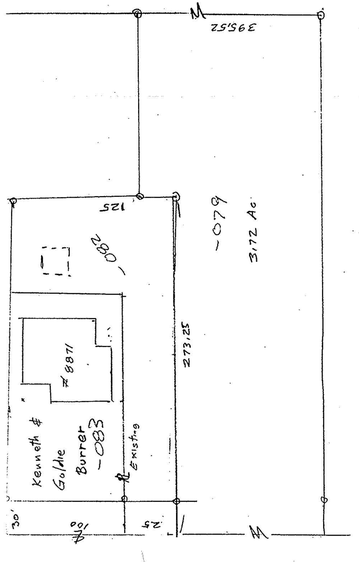

Building Locations on the
Gerald Burrer property
Original Elyria Township Lot 3
West of Black River
City of Elyria
Lorain County Ohio
Scale 1" = 60' Nov 7, 1998

For survey data see
Survey Record Vol. 35 Pg 23
o iron pipe set
John Pozywak
Reg Surveyor
5292

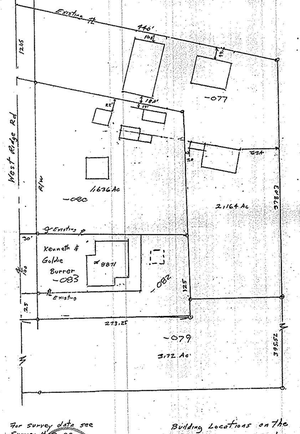

For survey data see
Survey Record Vol. 35 Pg 23
o iron pipe set
John Pozywak
Reg Surveyor
5292
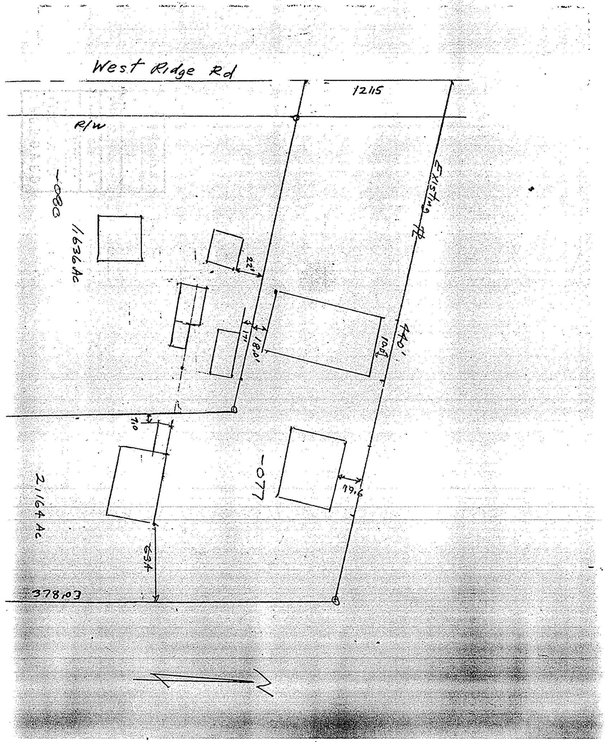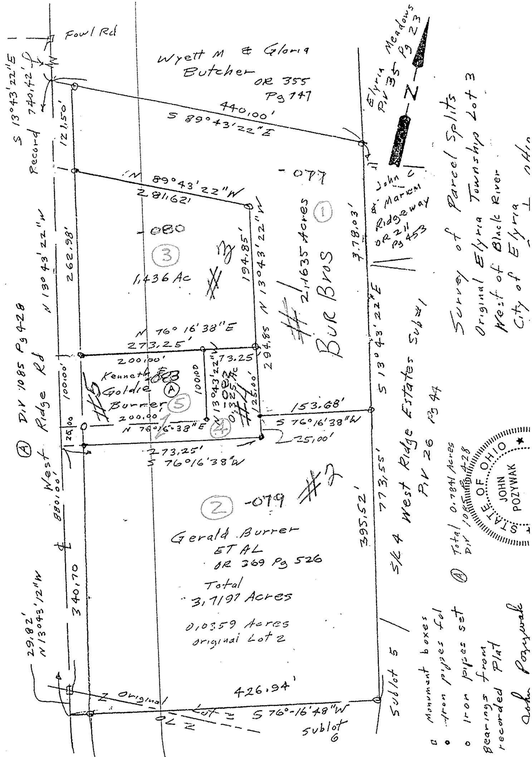
Building Locations on the
Gerald Burrer property
Original Elyria Township Lot 3
West of Black River
City of Elyria
Lorain County Ohio
Scale 1" = 60' Nov 7, 1998