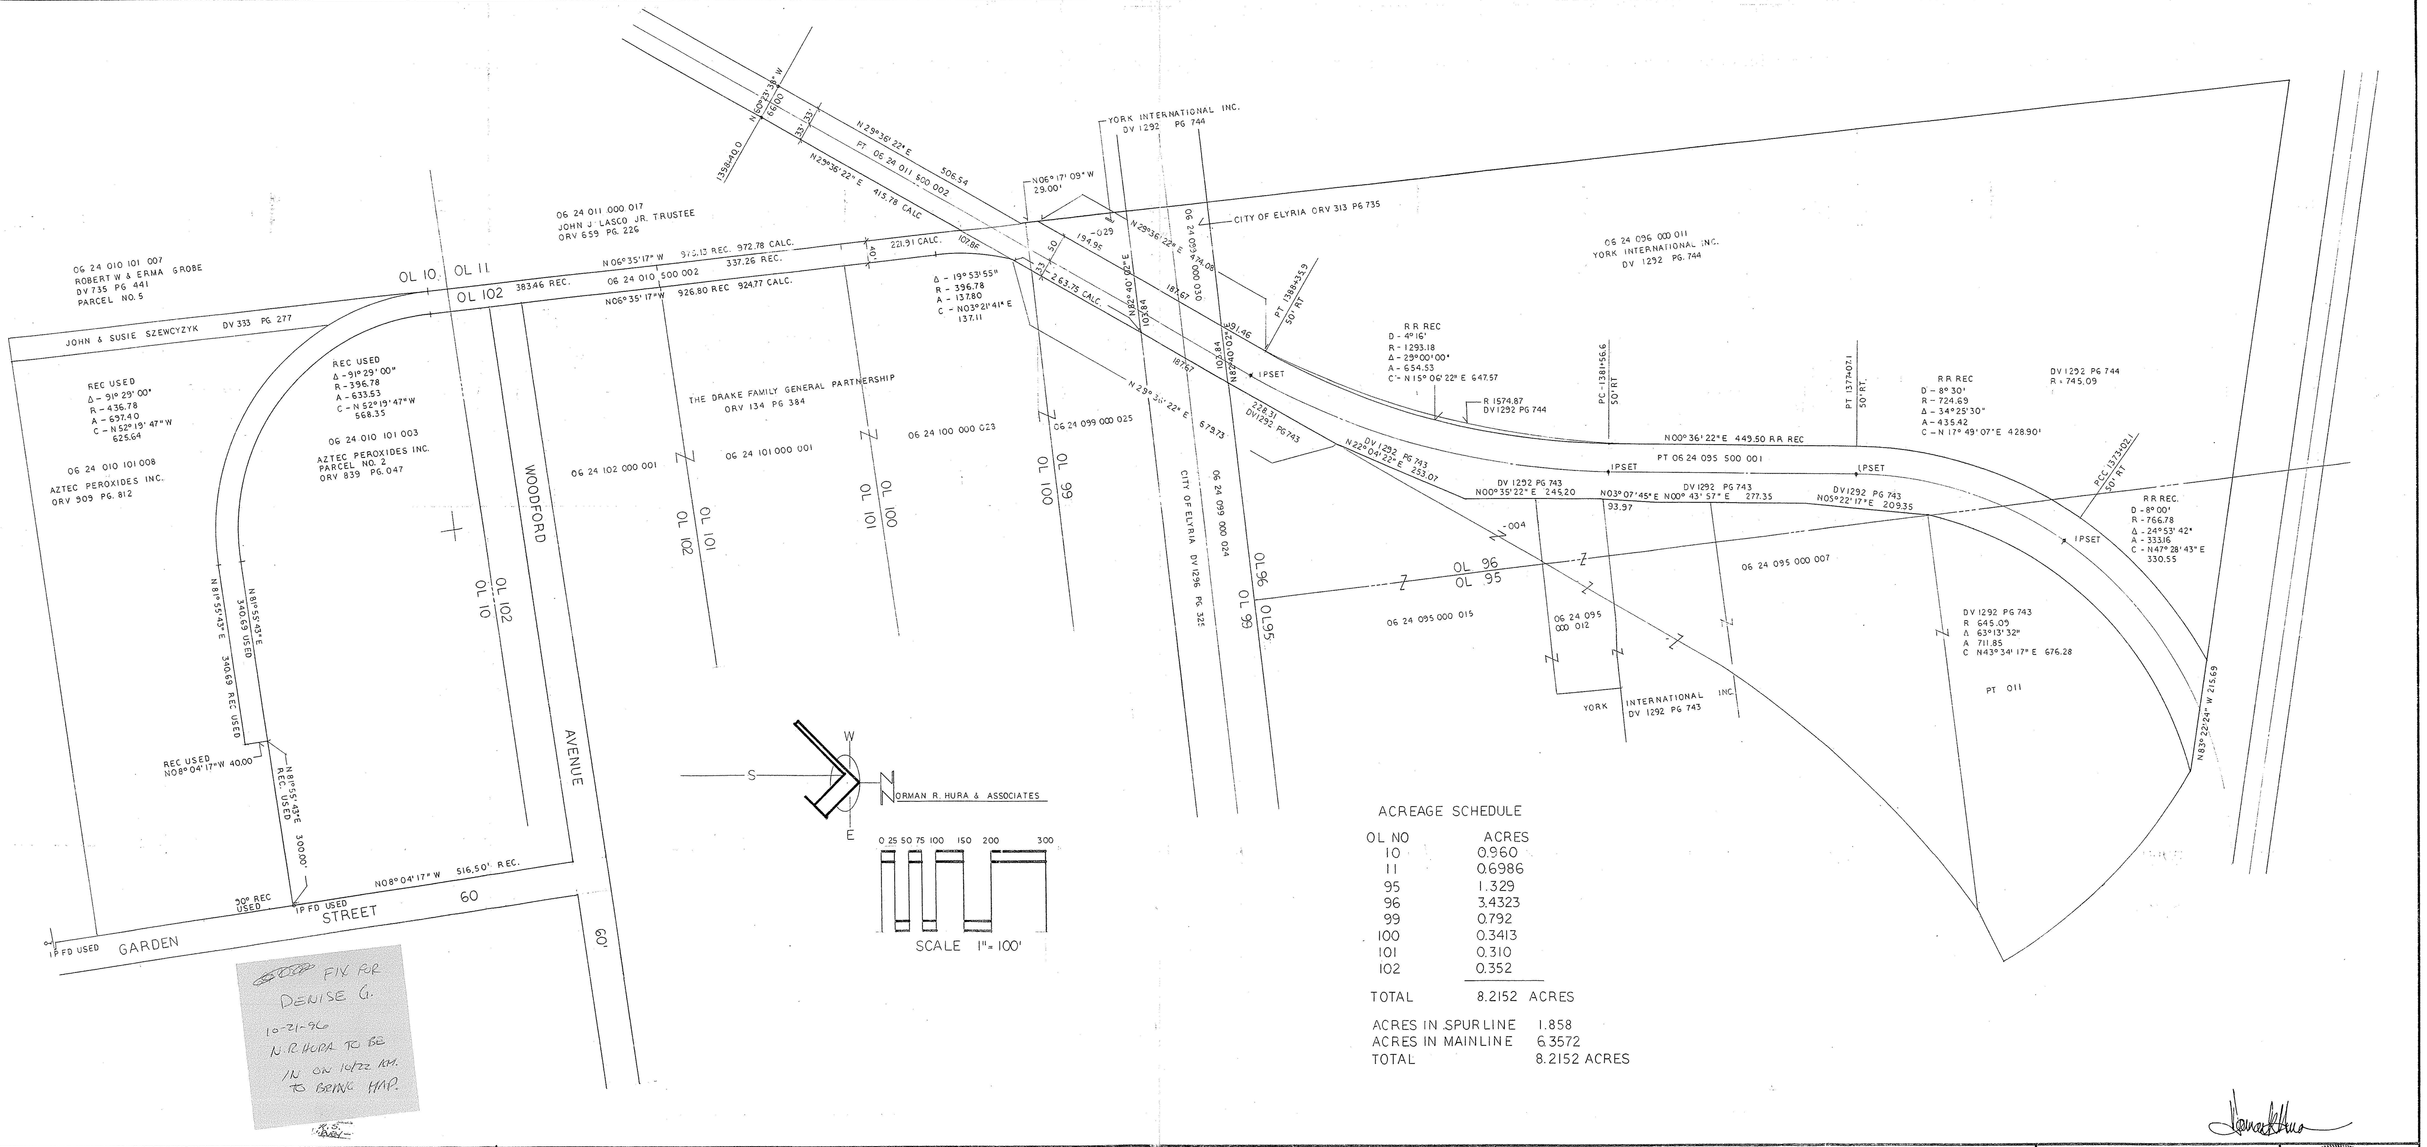

ACREAGE SCHEDULE

OL NO	ACRES
10	0.960
11	0.6986
95	1.329
96	3.4323
99	0.792
100	0.3413
101	0.310
102	0.352
TOTAL	8.2152 ACRES

ACRES IN SPUR LINE	1.858
ACRES IN MAINLINE	6.3572
TOTAL	8.2152 ACRES

LORAIN COUNTY METROPOLITAN PARK DISTRICT

PLAT OF SURVEY OF PARTS OF PPN NO'S 06-24-010-500-002, 06-24-011-500-002, 06-24-095-500-001

ORIGINAL LOTS NO'S 10-11-95-96-99-100-101-102
WEST OF THE WEST BRANCH OF BLACK RIVER
CITY OF ELYRIA - LORAIN COUNTY - OHIO

JULY 1995

STATE OF OHIO
N. R. HURA
S-5208
REGISTERED PROFESSIONAL SURVEYOR