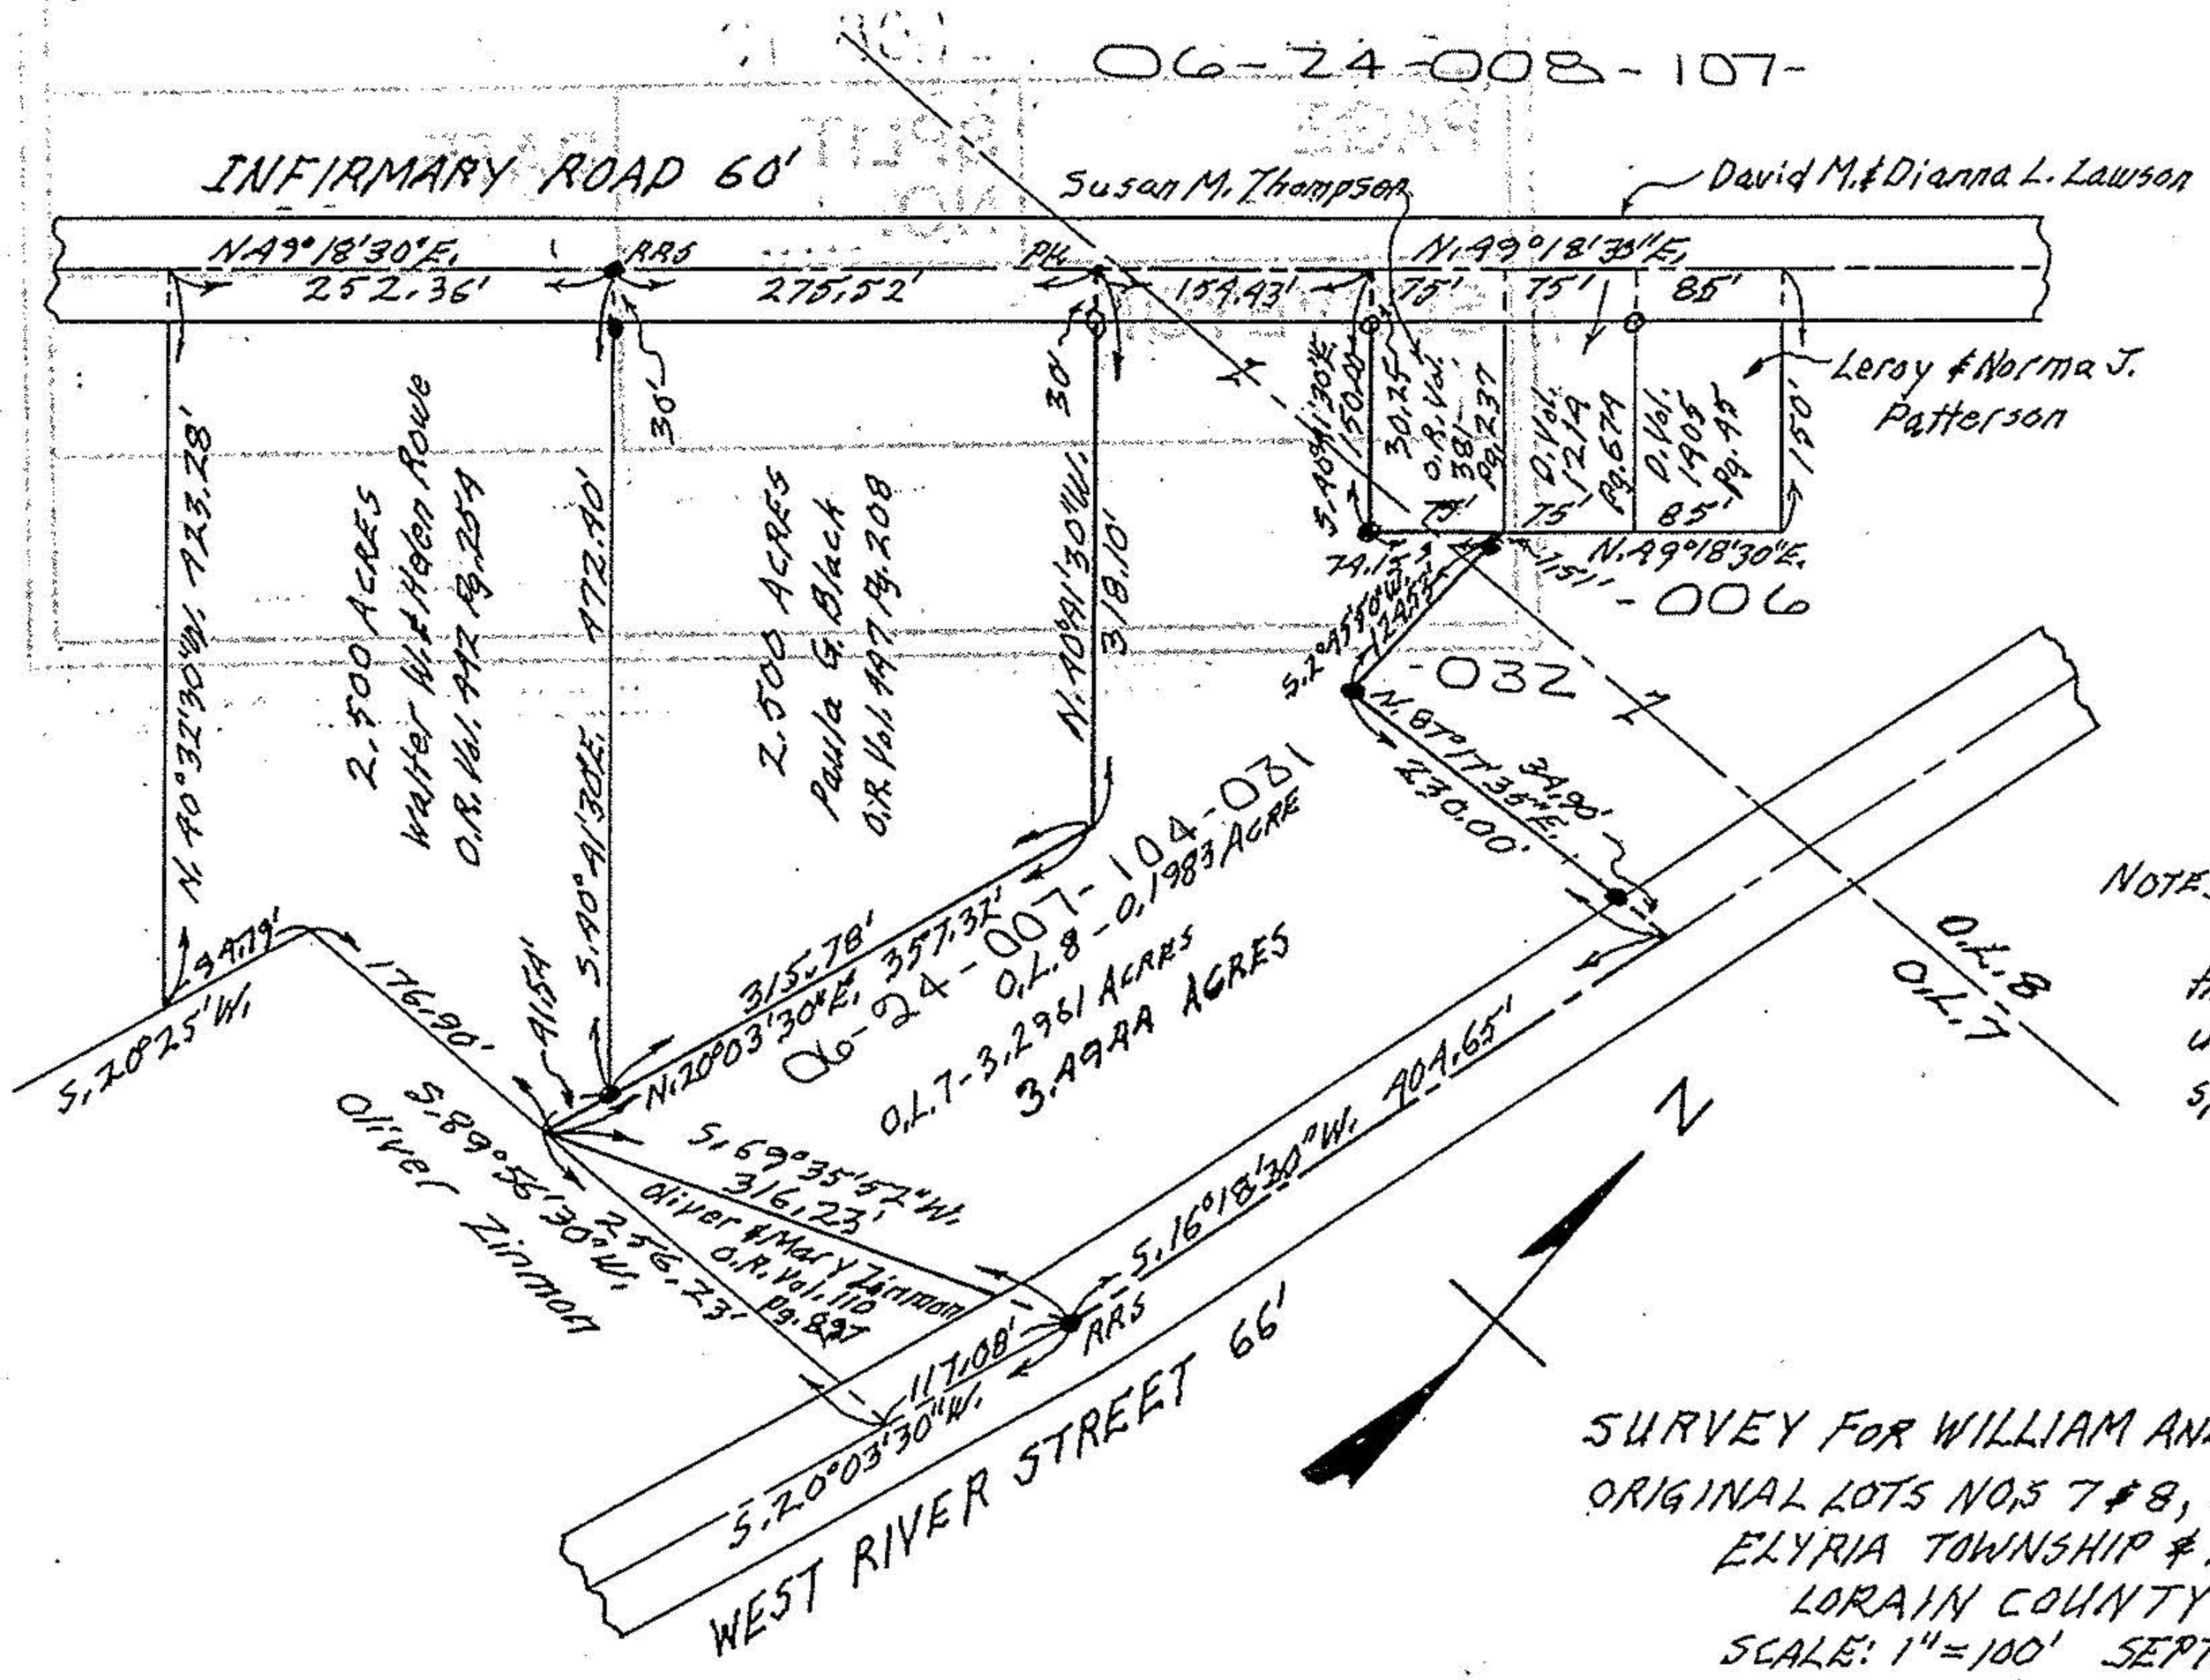

20760

APPROVED
LORAIN CO.
MAP DEPT.

DATE 3-15-94
PAGE 6-135
BY CAROLYN FRANCIS
VOID # 20760

NOTES: ○ indicates iron pin found.
● indicates iron pin set on this survey or in August of 1991 unless designated as railroad spike.
• indicates PK nail set.

SURVEY FOR WILLIAM AND FRED WALLHEAD
ORIGINAL LOTS NOS 7 & 8, WEST OF BLACK RIVER
ELYRIA TOWNSHIP & ELYRIA CITY
LORAIN COUNTY - OHIO
SCALE: 1" = 100' SEPTEMBER - 1993

Gary E. Penfound - Reg. Surveyor No. 4457

Scale of reduced map —
1" = 155' GEP