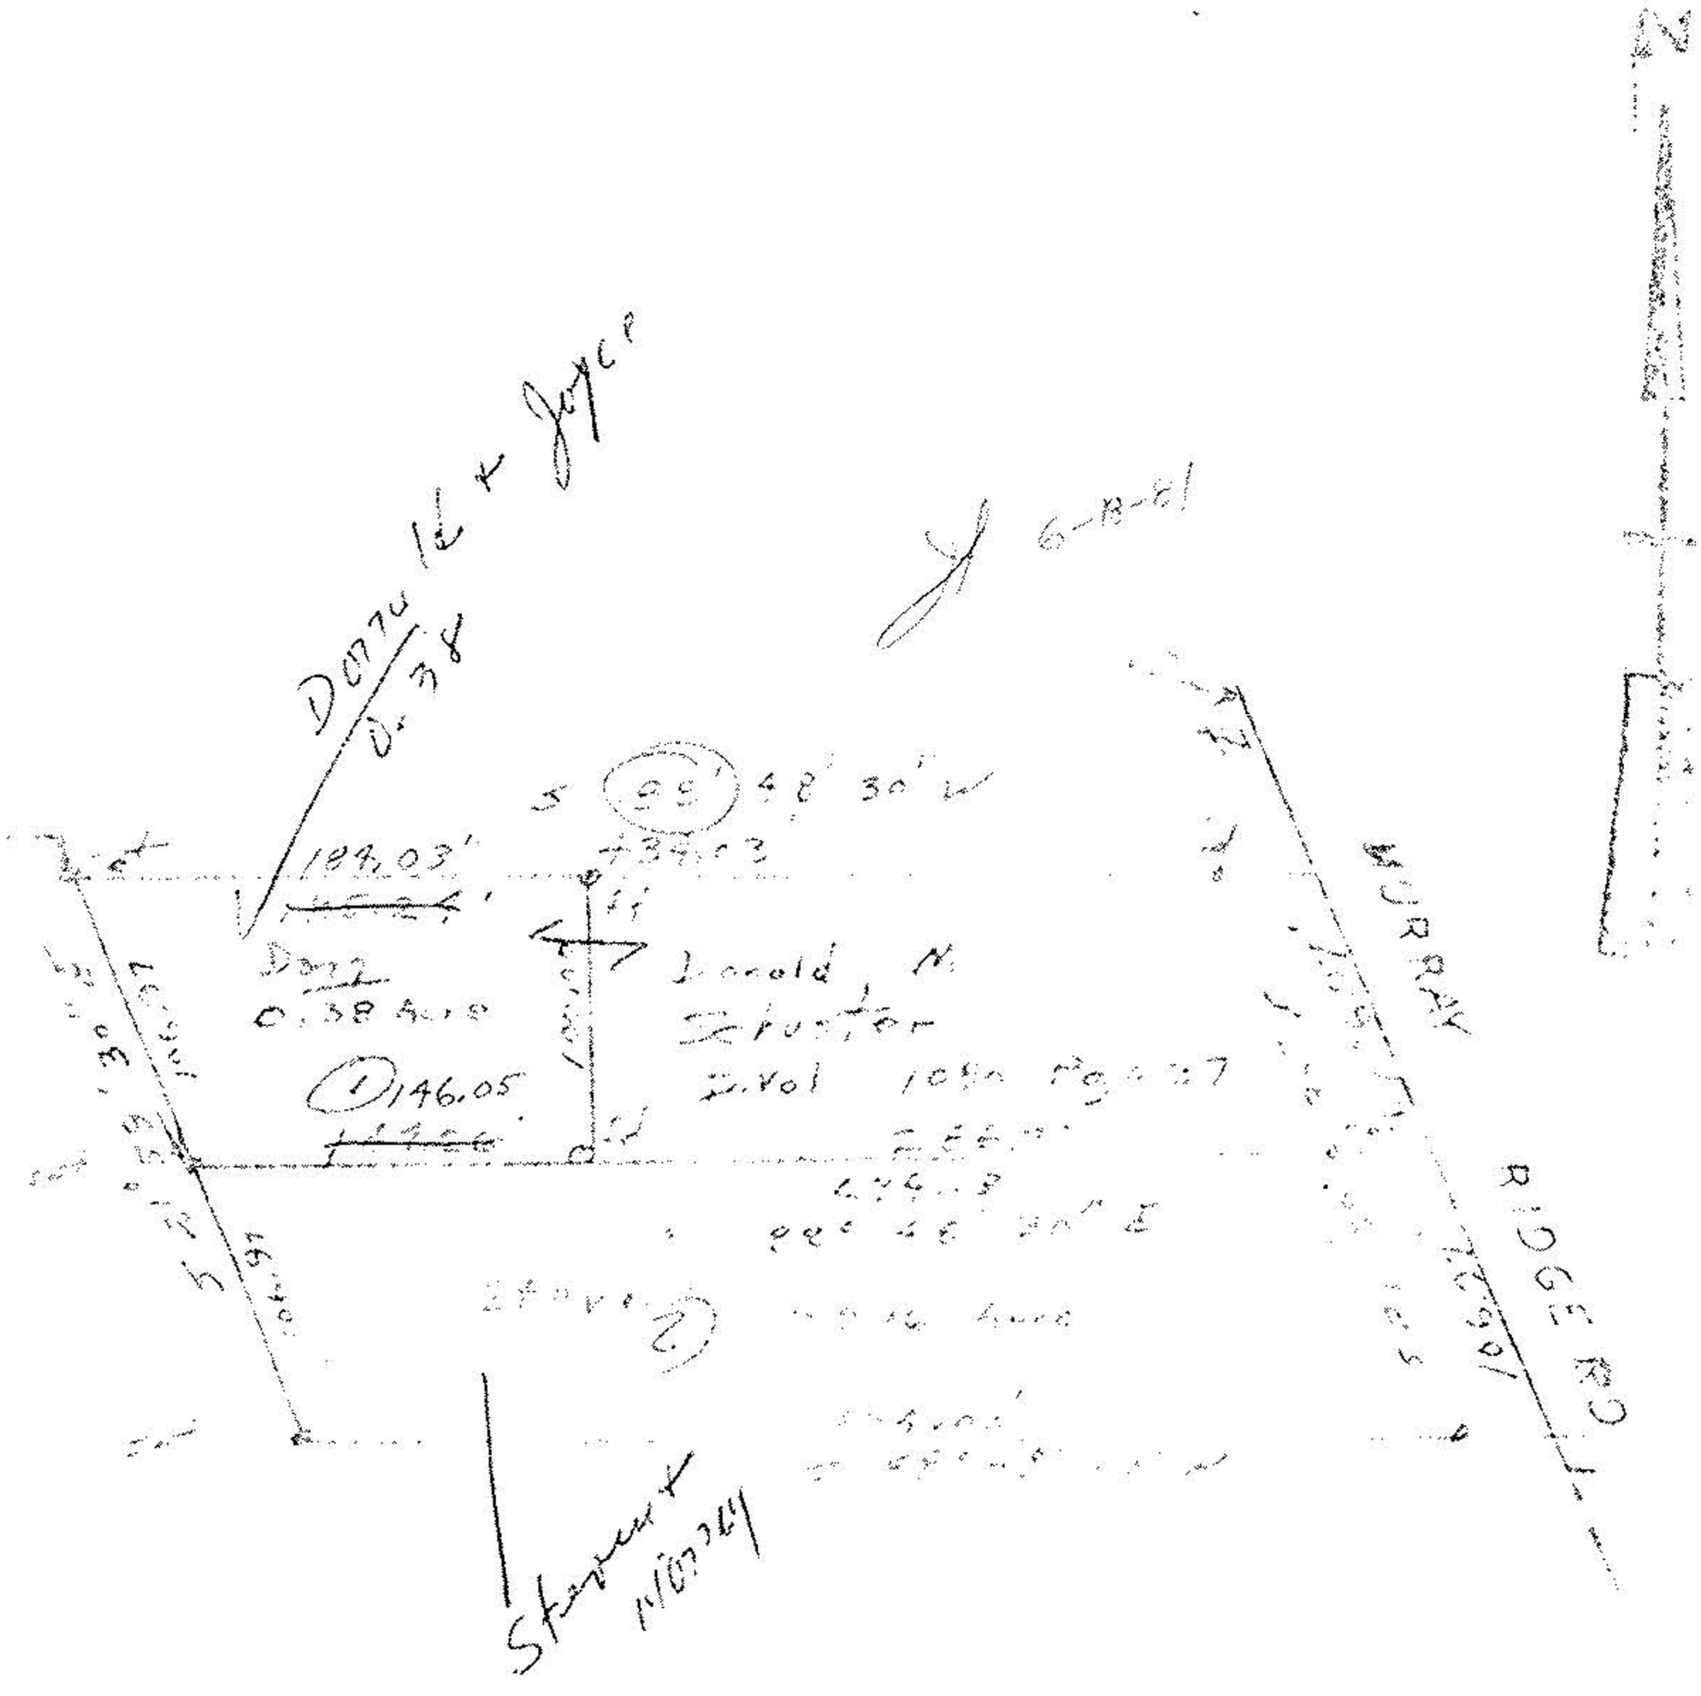
MURRAY
RIDGE RD
Donald Schuster
146.05
146.03'
APPROVED
LORAIN CO.
MAP DEPT.
6-18-31
C-112