


06-24-017-101

*17983

G-91

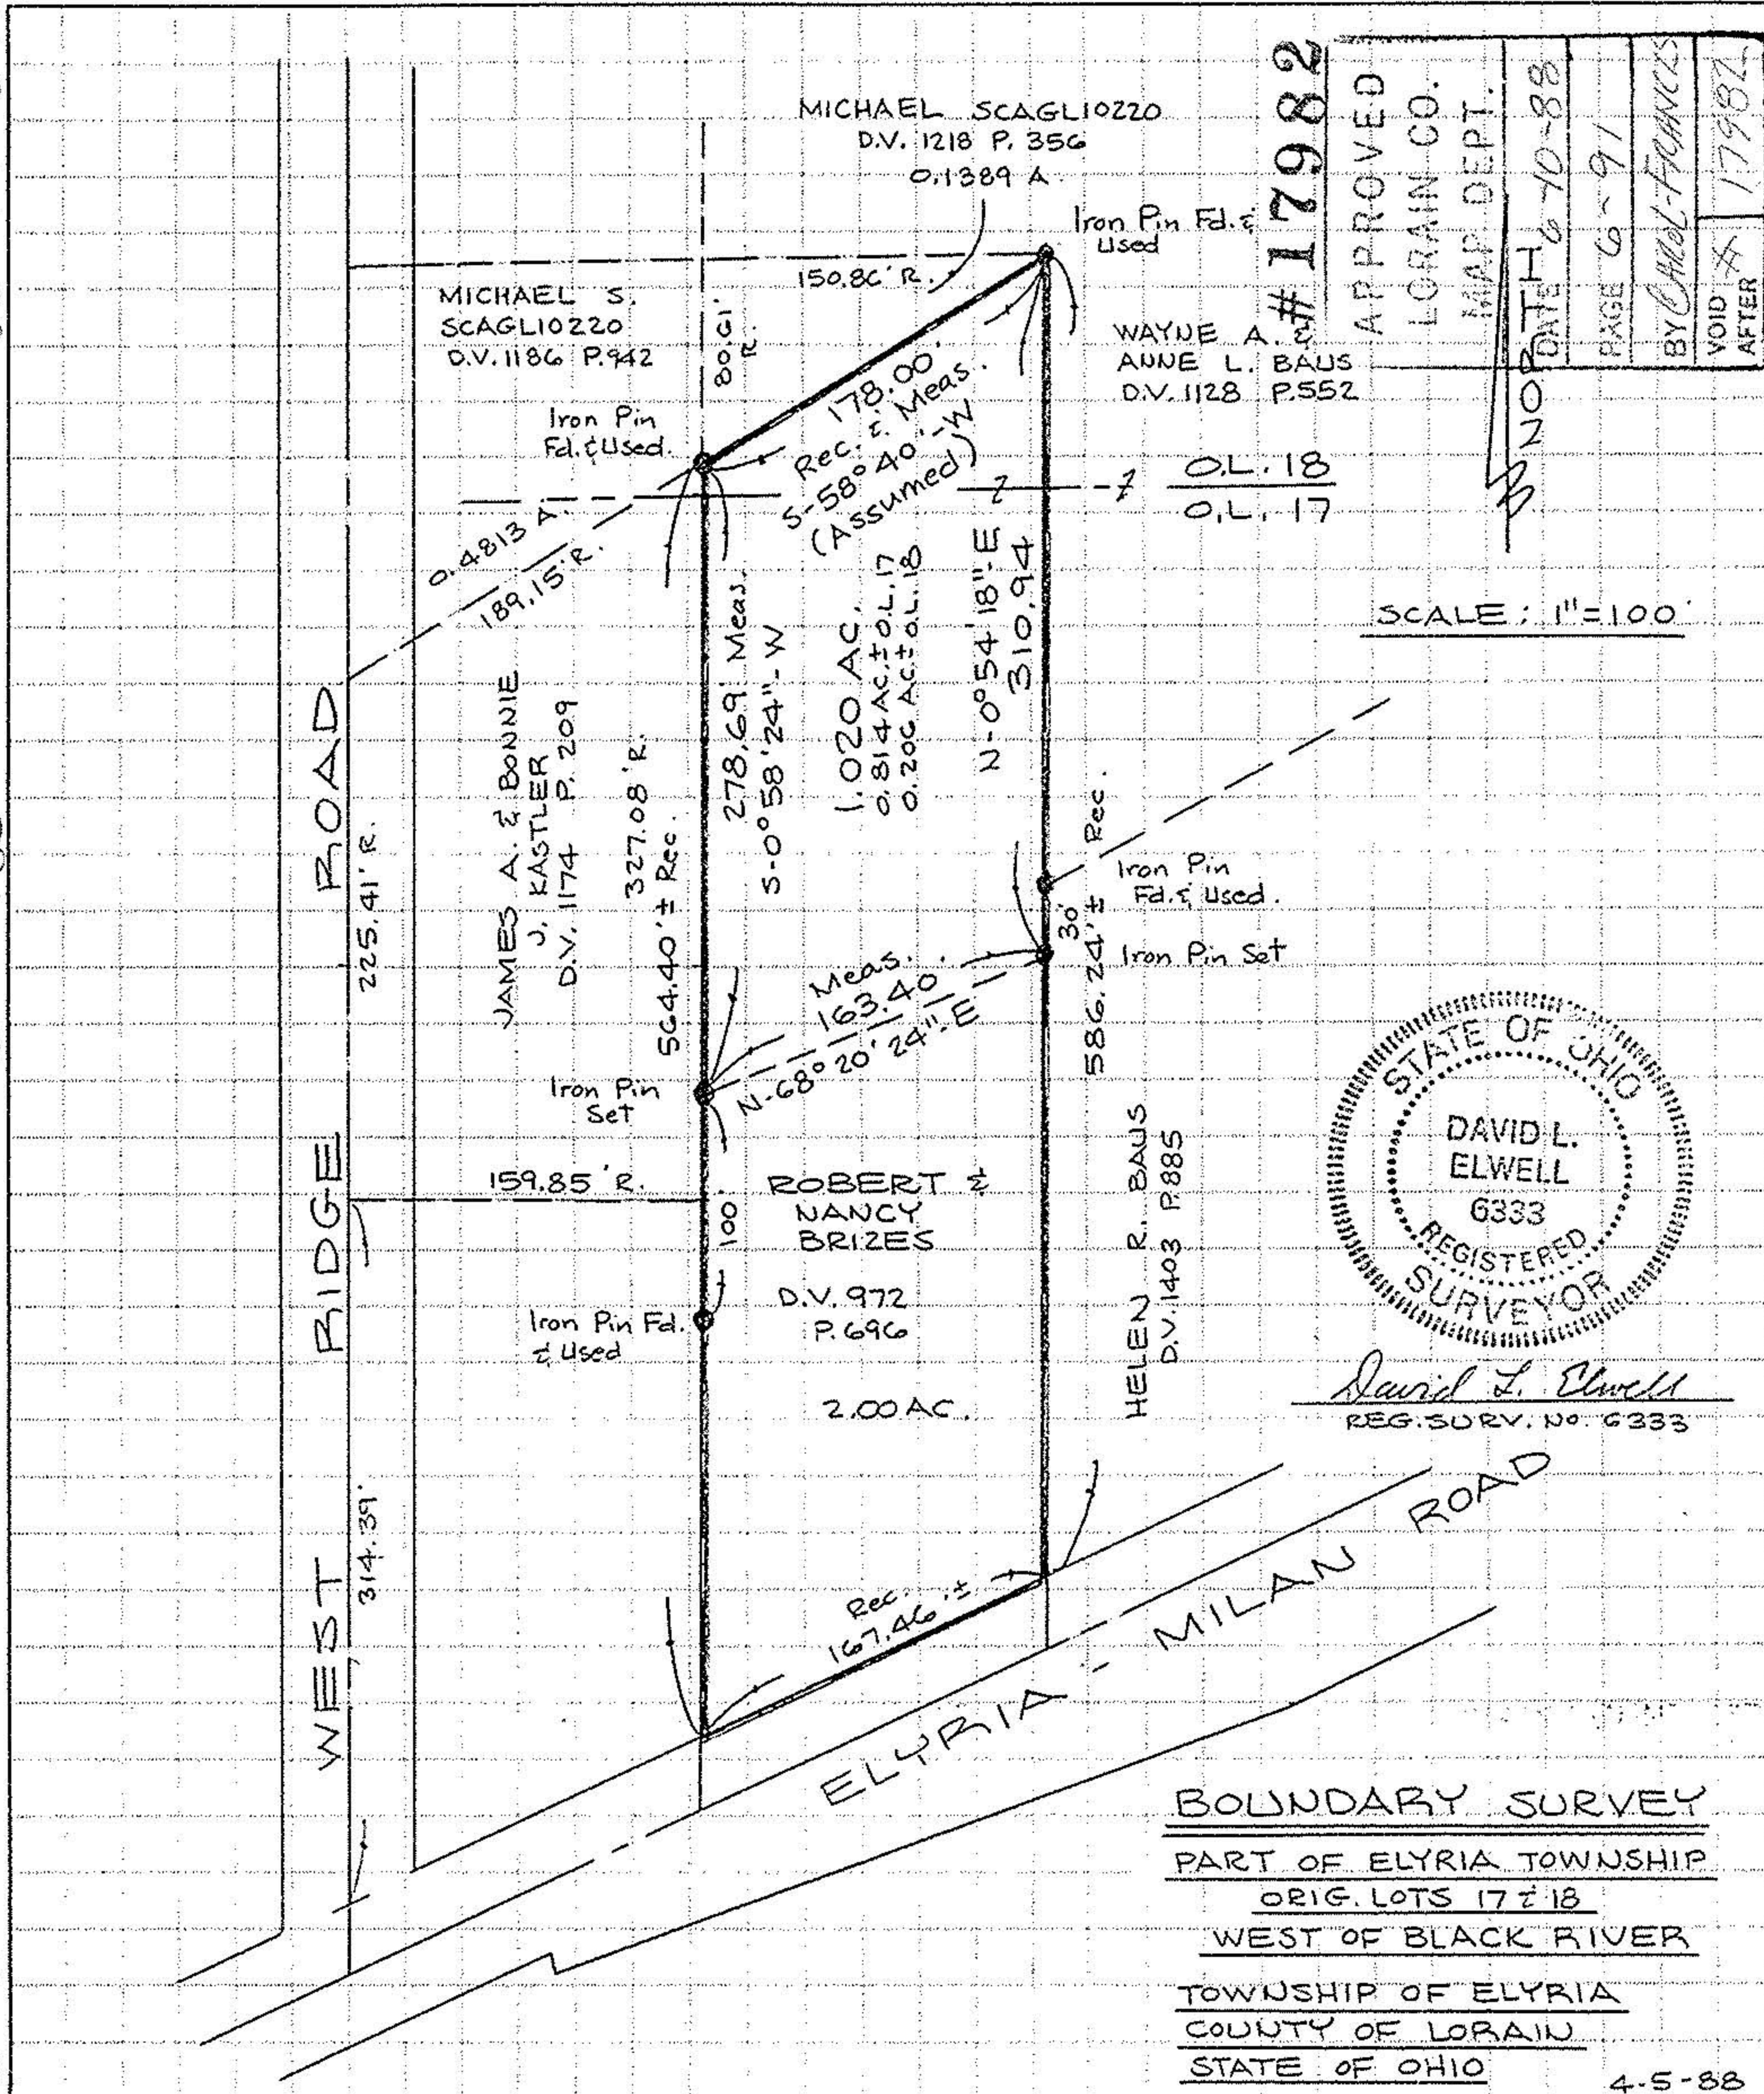

#17982

APPROVED
 LORAIN CO.
 MAP DEPT.
 DATE 6-10-88
 PAGE 6-91
 BY Carol-Francks
 VOID AFTER 17982

BOUNDARY SURVEY
PART OF ELYRIA TOWNSHIP
ORIG. LOTS 17 & 18
WEST OF BLACK RIVER
TOWNSHIP OF ELYRIA
COUNTY OF LORAIN
STATE OF OHIO

4-5-88