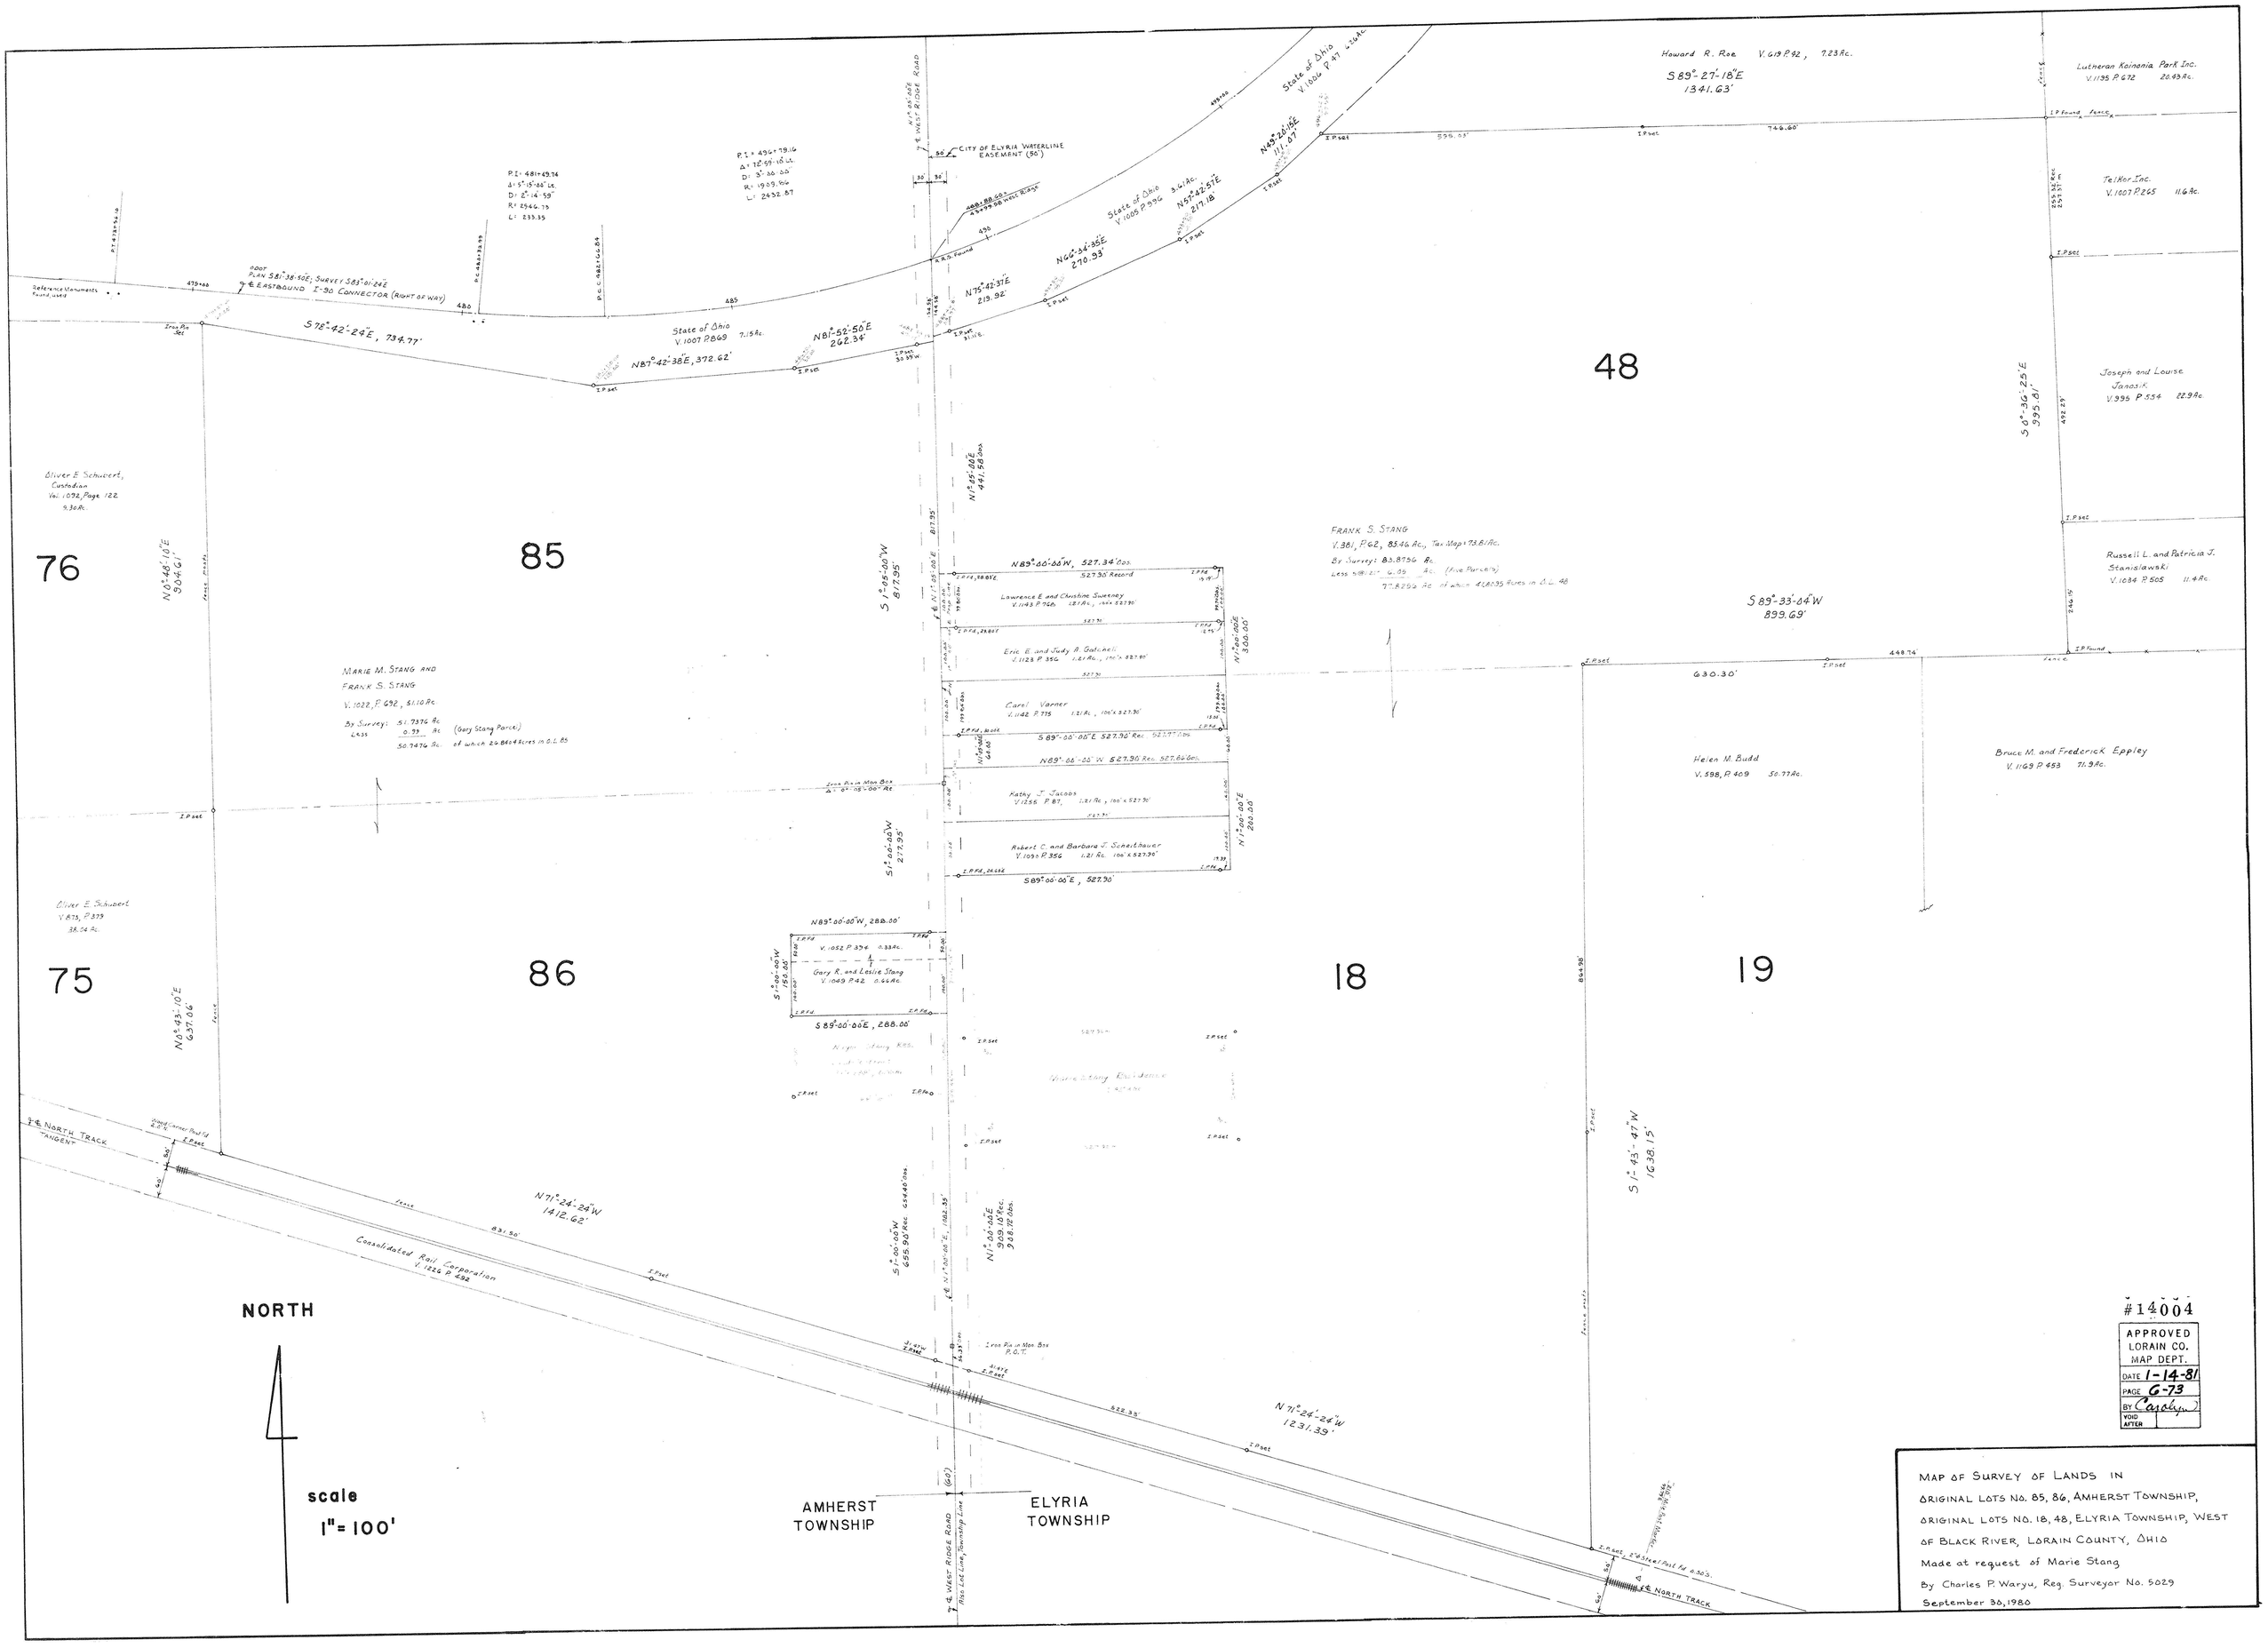


#14004

| APPROVED LORAIN CO. MAP DEPT. | |
|---|---|
| DATE | 1-14-81 |
| PAGE | G-73 |
| BY | Carolyn |
| VOID AFTER | |

MAP OF SURVEY OF LANDS IN
ORIGINAL LOTS NO. 85, 86, AMHERST TOWNSHIP,
ORIGINAL LOTS NO. 18, 48, ELYRIA TOWNSHIP, WEST
OF BLACK RIVER, LORAIN COUNTY, OHIO
Made at request of Marie Stang
By Charles P. Waryu, Reg. Surveyor No. 5029
September 30, 1980