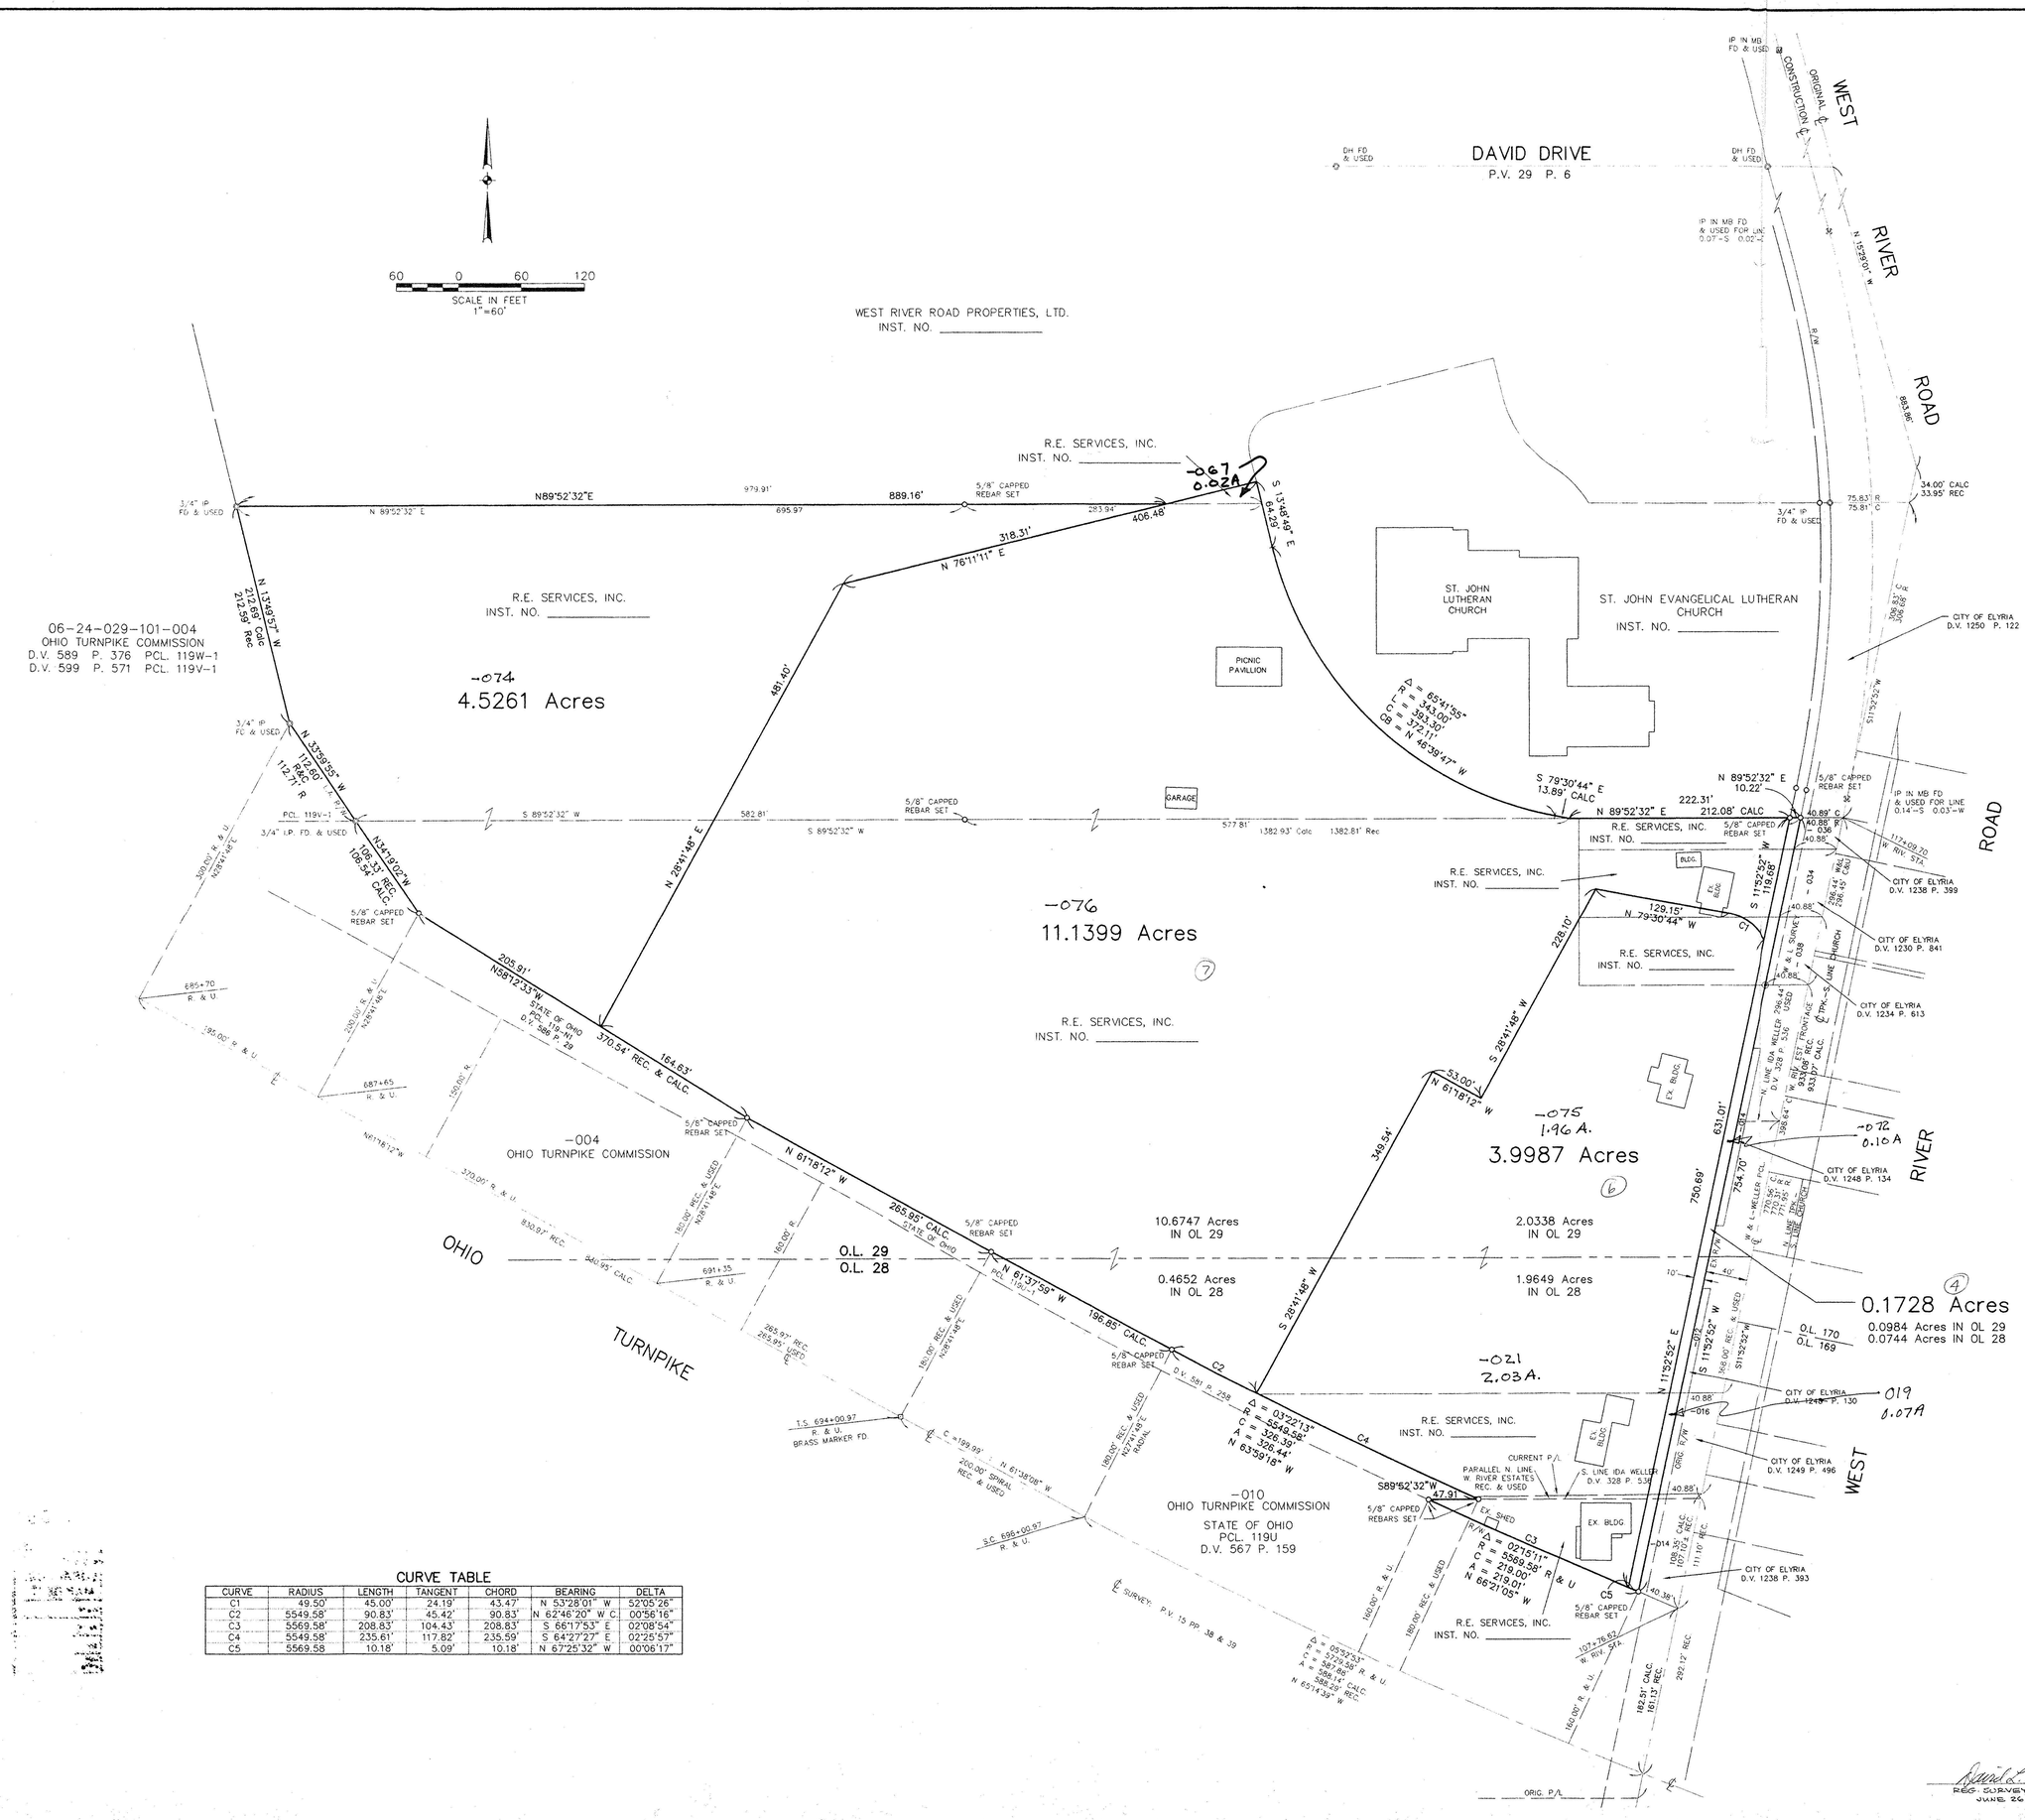

CURVE TABLE

CURVE	RADIUS	LENGTH	TANGENT	CHORD	BEARING	DELTA
C1	49.50'	45.00'	24.19'	43.47'	N 53°28'01" W	52°05'26"
C2	5549.58'	90.83'	45.42'	90.83'	N 62°46'20" W	00°56'16"
C3	5569.58'	208.83'	104.43'	208.83'	S 66°17'53" E	02°08'54"
C4	5549.58'	235.61'	117.82'	235.59'	S 64°27'27" E	02°25'57"
C5	5569.58	10.18'	5.09'	10.18'	N 67°25'32" W	00°06'17"

#22593
~~#22593~~
APPROVED
LORAIN CO.
MAP DEPT.
DATE 8-24-98
PAGE 6-65
BY TJS
NEW
AFTER 22593

David L. Elwell
REG. SURVEYOR NO. 6333
JUNE 26, 1998

STATE OF OHIO
DAVID L. ELWELL
6333
REGISTERED
SURVEYOR

REVISIONS

DATE: 06-26-98
DRAWN BY: ABR
CHK'D BY:
F.B.
DWG. NAME: 95326-SRV1-SPLIT01

SHEET 1 OF 1
JOB NO. 95326-S9

ENGINEERS/SURVEYORS
KS ASSOCIATES INCORPORATED

KS ASSOCIATES, INC.
ENGINEERS/SURVEYORS
424 Lake Avenue
P.O. Box 89
Elyria, Ohio 44036
PHONE (440) 322-6317 * FAX (440) 284-0623

MIDWAY MARKET SQUARE
SURVEY MAP & PARCEL SPLIT
PART OF
ORIGINAL ELYRIA TOWNSHIP LOTS NO. 28 & 29
WEST OF THE BLACK RIVER
CITY OF ELYRIA COUNTY OF LORAIN STATE OF OHIO