#14053

APPROVED
LORAIN CO.
MAP DEPT.
DATE 2-23-81
6-59 6-60
Carolyn F.
VOID AFTER 14053

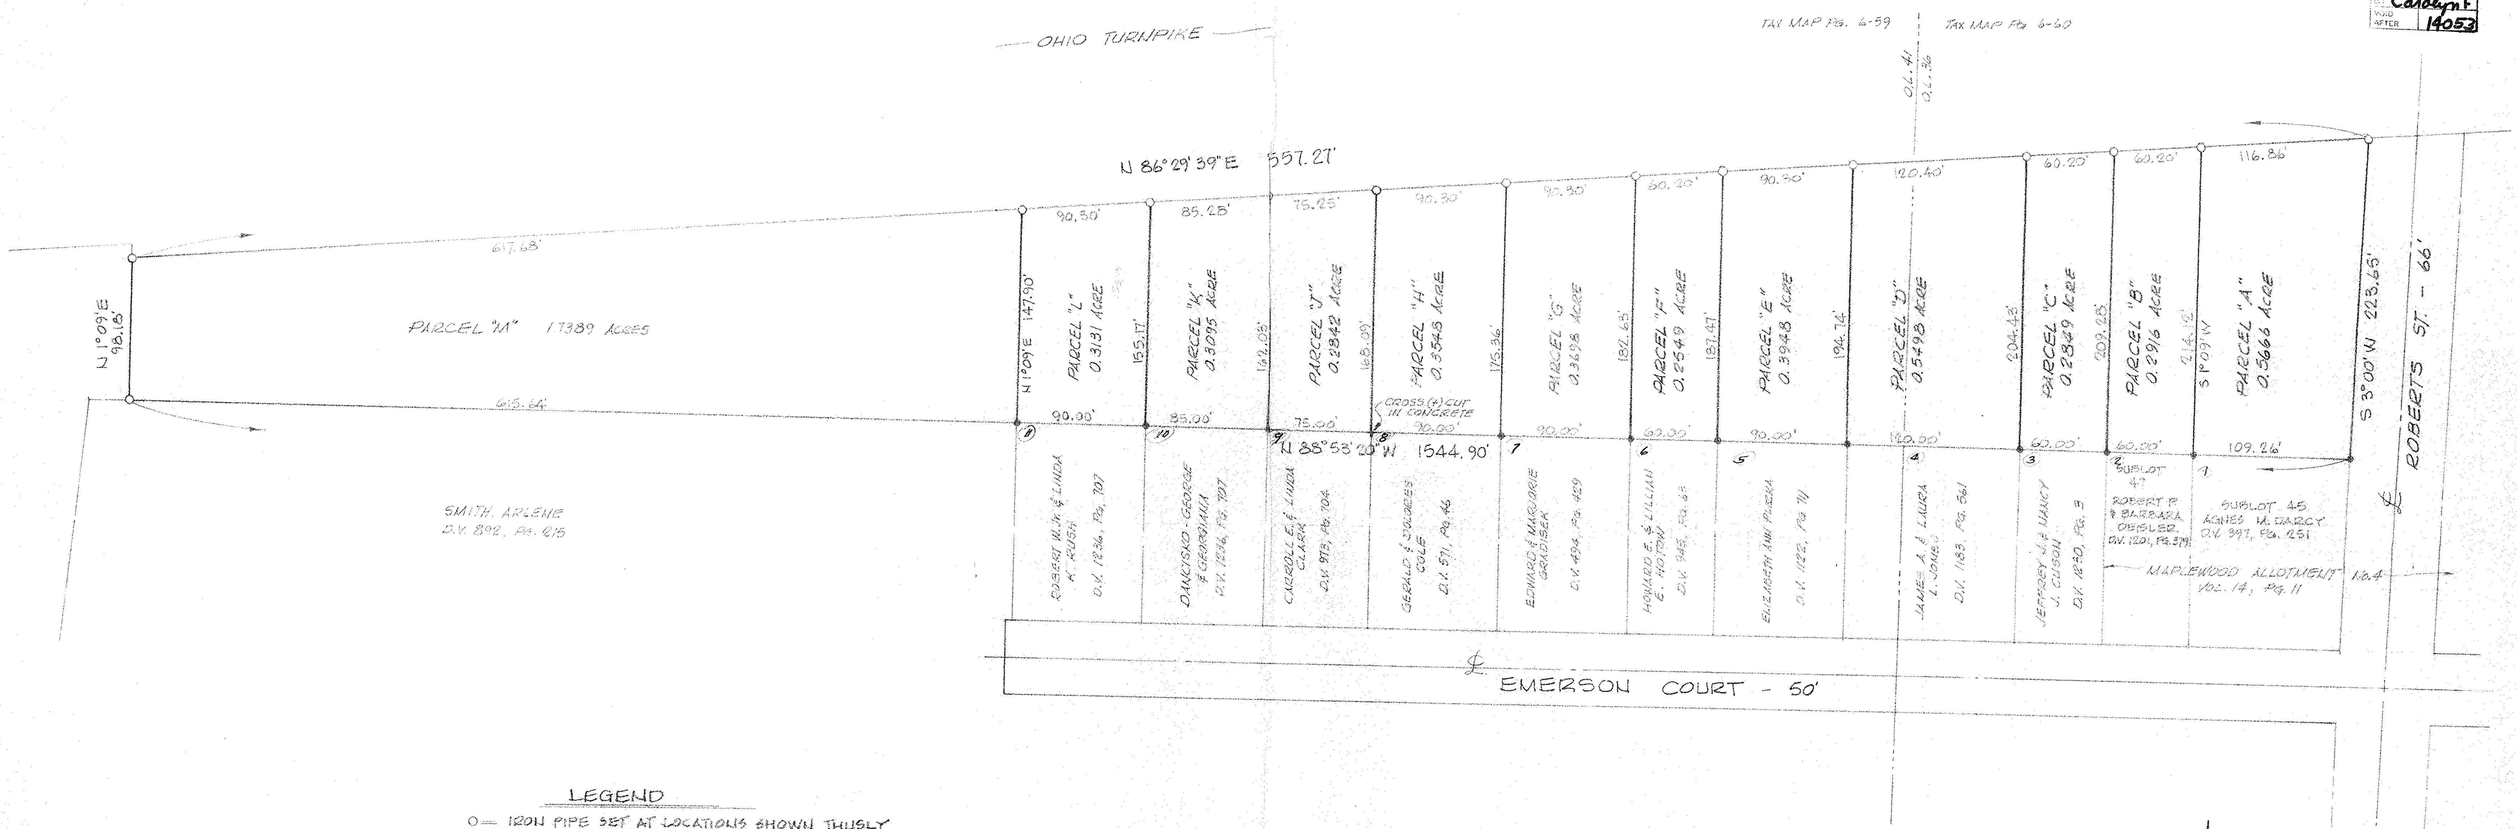


LEGEND

O — IRON PIPE SET AT LOCATIONS SHOWN THUSLY

● — IRON PIN FOUND AT LOCATIONS SHOWN THUSLY

# MAP of SURVEY and PROPOSED PARCEL SPLIT

PREPARED FOR "FAMILY LOAN Co." PER REQUEST OF CHICAGO TITLE INSURANCE COMPANY

PART of ORIGINAL ELYRIA TOWNSHIP LOTS No. 36 and 41, WEST of BLACK RIVER.

TOWNSHIP of ELYRIA, LORAIN COUNTY OHIO

NORTH

SCALE: 1" = 50'

NOTE: PROPOSED SPLIT OUT OF ORIG. P.P. # 06-24-041-000-044

prepared by:

McGLINCHY and ASSOCIATES INC.
PROFESSIONAL ENGINEER and SURVEYORS
110½ MIDDLE AVE. ELYRIA, OHIO
FEBRUARY, 1981 #816641