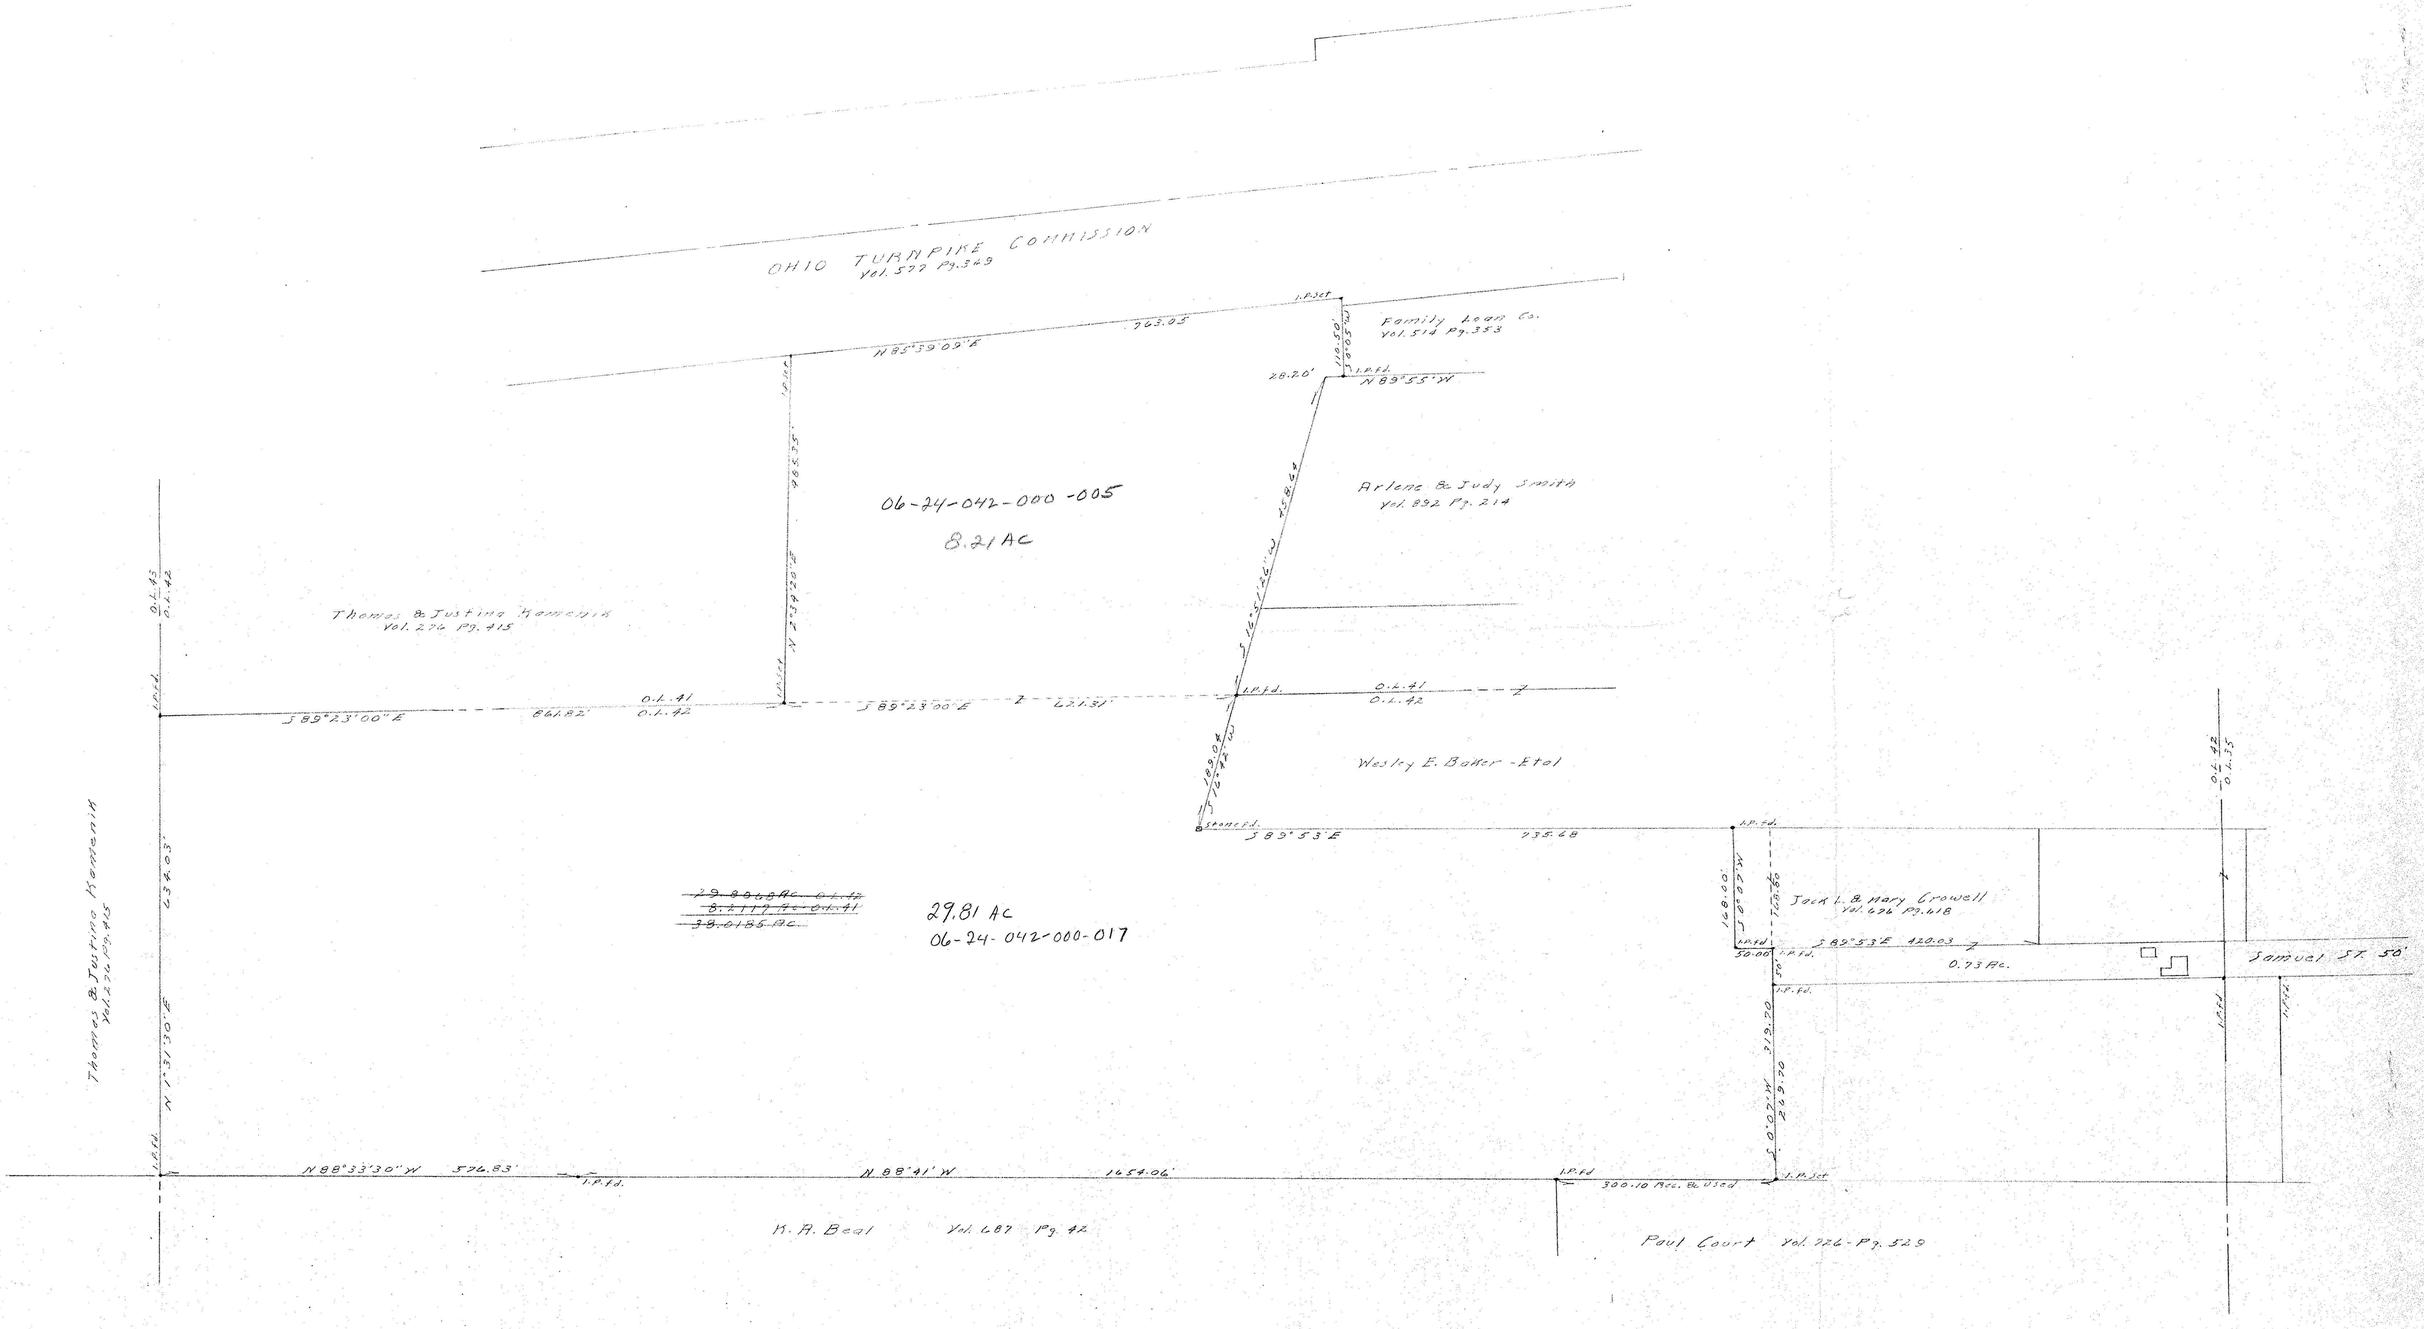
OHIO TURNPIKE COMMISSION
Vol. 577 Pg. 349
I.P.Set
Family Loan Co.
Vol. 514 Pg. 353
N85°39'02"E
263.03
110.50'
S 0°05'00"W
28.20'
I.P.Fd.
N89°55'W
06-24-042-000-005
8.21 AC
Arlene & Judy Smith
Vol. 892 Pg. 214
458.44
S 16°51'46"W
Thomas & Justina Kamenik
Vol. 276 Pg. 415
0.L.43
0.L.42
N 2°34'28"E
48.53'
I.P.Fd.
0.L.41
0.L.42
S 89°23'00"E
861.82'
S 89°23'00"E
621.31'
Wesley E. Baker - Etal
183.04'
S 16°42'00"W
Stone Fd.
S 89°53'E
735.68
Thomas & Justina Kamenik
Vol. 276 Pg. 415
~~29.8048 Ac 0.L.42~~
~~8.4119 Ac 0.L.41~~
~~38.0185 Ac~~
29.81 Ac
06-24-042-000-017
0.L.42
0.L.35
Jack L. & Mary Crowell
Vol. 626 Pg. 618
168.00'
S 0°05'00"W
120.50
S 89°53'E 420.03
50.00
0.73 Ac.
Samuel St. 50'
N 1°31'30"E
639.03'
319.70
S 0°07'W
289.70
N 88°33'30"W 576.83'
N 88°41'W
1654.06'
300.10 Acc. Be Used
K. A. Beal Vol. 687 Pg. 42
Paul Court Vol. 926 - Pg. 529