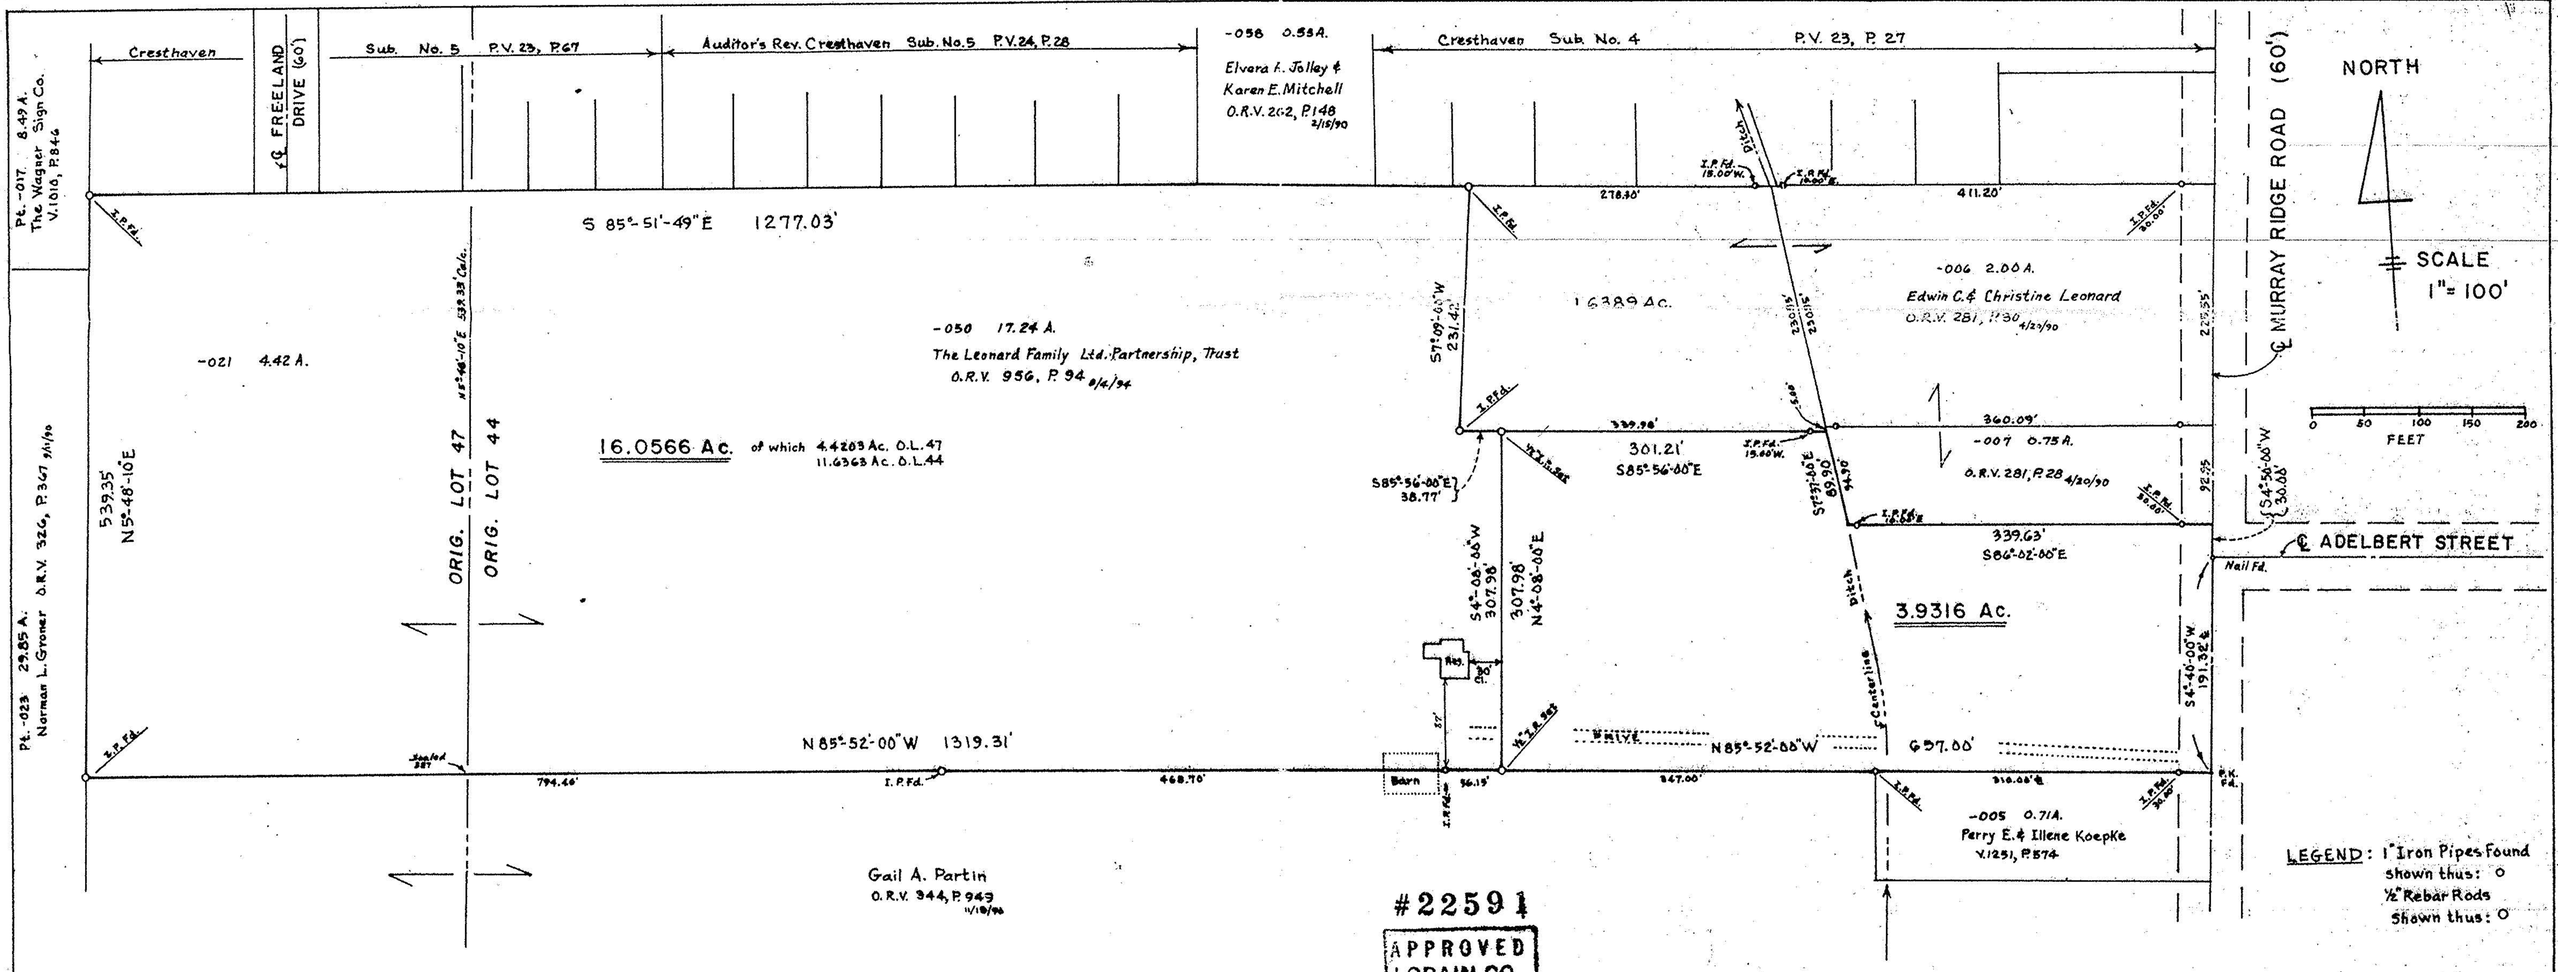
Cresthaven
℄ FREELAND DRIVE (60')
Sub. No. 5 P.V. 23, P.67
Auditor's Rev. Cresthaven Sub. No.5 P.V.24, P.28
-058 0.58A.
Elvera A. Jolley & Karen E. Mitchell
O.R.V. 262, P.148 2/15/90
Cresthaven Sub. No. 4 P.V. 23, P. 27
℄ MURRAY RIDGE ROAD (60')
NORTH
SCALE 1"= 100'
0 50 100 150 200
FEET
Pt. -017 8.49 A. The Wagner Sign Co. V.1018, P.846
Pt. -023 29.85 A. Norman L. Groner O.R.V. 326, P.367 9/1/90
S 85°-51'-49"E 1277.03'
-021 4.42 A.
539.35' N5°-48'-10"E
ORIG. LOT 47
ORIG. LOT 44
-050 17.24 A.
The Leonard Family Ltd. Partnership, Trust
O.R.V. 956, P. 94 8/4/94
16.0566 Ac. of which 4.4203 Ac. O.L.47
11.6363 Ac. O.L.44
1.6389 Ac.
-006 2.00 A.
Edwin C.& Christine Leonard
O.R.V. 281, P.30 4/23/90
S7°-09'-00"W 231.42'
278.30'
411.20'
339.96'
360.09'
301.21' S85°-56'-00"E
S85°-56'-00"E 38.77'
-007 0.75 A.
O.R.V. 281, P.28 4/20/90
339.63' S86°-02'-00"E
3.9316 Ac.
S4°-08'-00"W 307.98'
N4°-08'-00"E 307.98'
S4°-40'-00"W 191.32'
Nail Fd.
℄ ADELBERT STREET
Pitch
℄ Centerline
Reg.
Barn
N85°-52'-00"W 1319.31'
794.46'
I. P. Fd.
468.70'
56.15'
847.00'
657.00'
316.06'
-005 0.71A.
Perry E.& Illene Koepke
V.1251, P.874
Gail A. Partin
O.R.V. 344, P.949 11/10/98
I.P.Fd.
I.P.Pd. 18.00'W.
I.P.Fd. 18.00'E.
I.P.Fd. 30.00'
I.P.Pd.
I.P.Fd. 19.00'W.
I.P.Fd. 18.65'E
I.P.Fd. 30.00'
I.P.Fd.
P.K. Fd.
S4°-56'-00"W 30.08'
92.55'
227.55'
230.01'
229.01'
5.69'
94.90'
89.90'
S7°-37'-00"E
