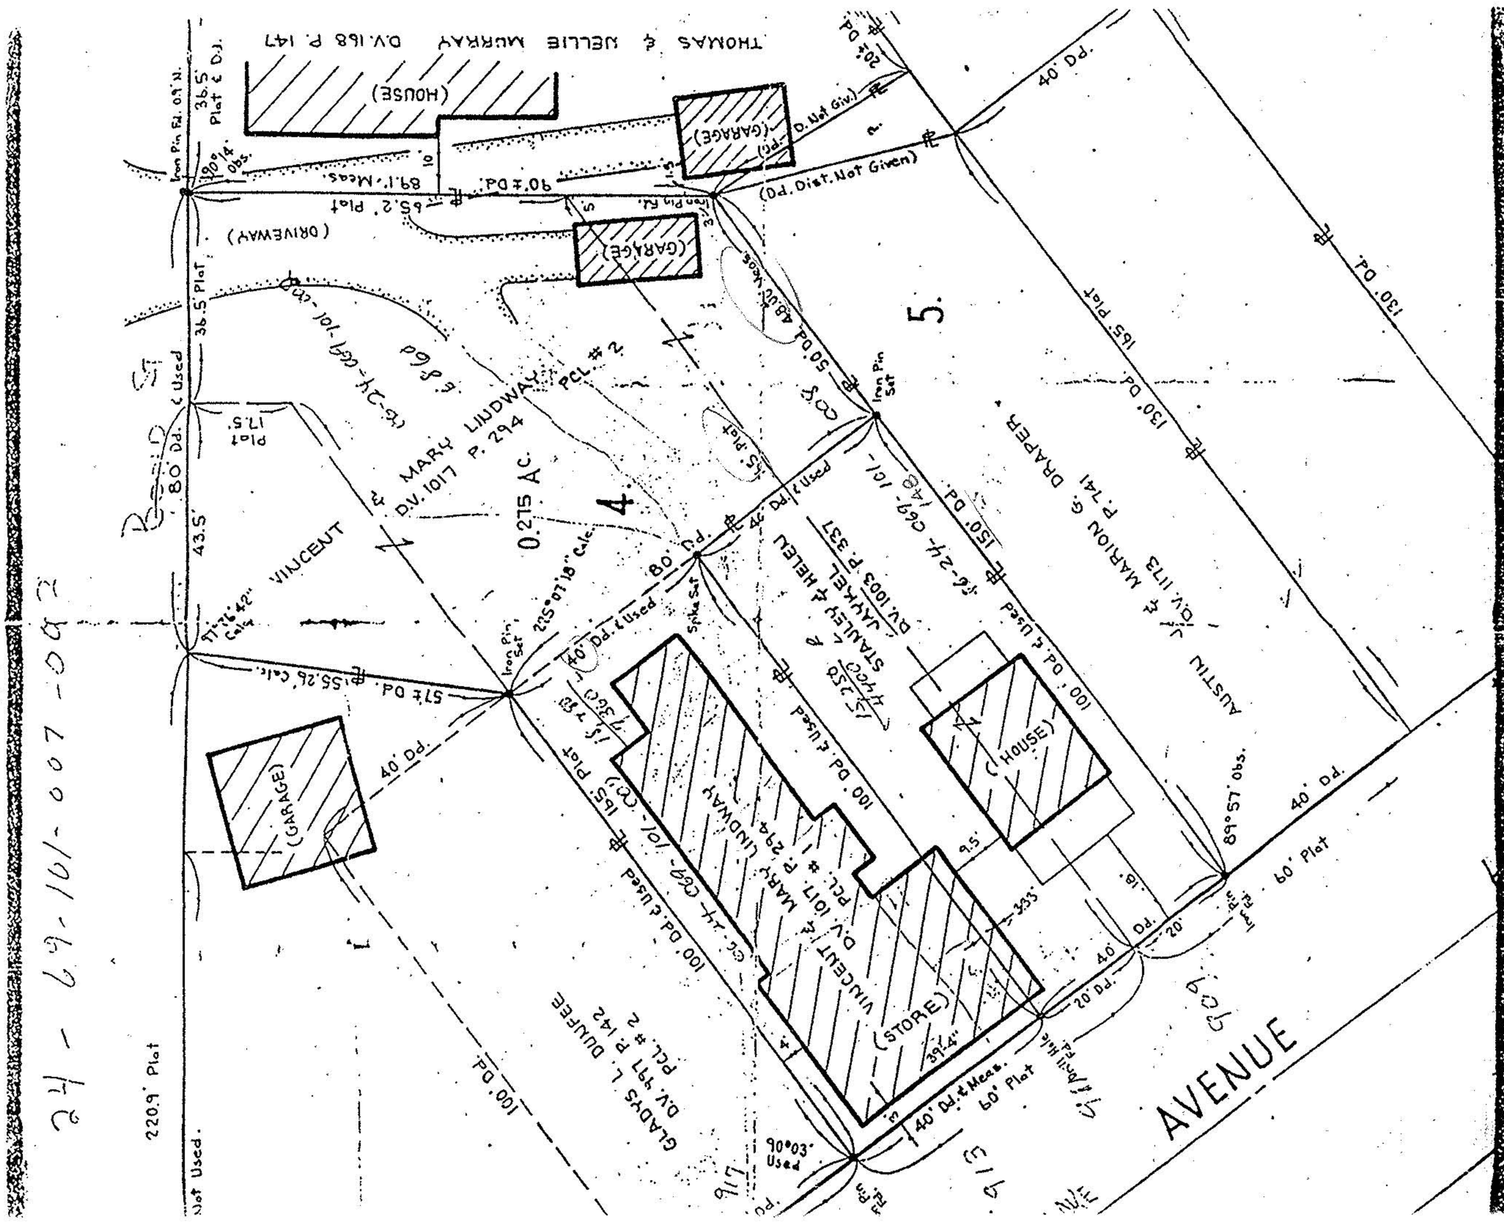
THOMAS & NELLIE MURRAY D.V.188 P. 147
(HOUSE)
(GARAGE)
(GARAGE)
(DRIVEWAY)
Iron Pin Fd. on li.
36.5' Plat & D.
Iron Pin Fd.
89.1' Meas.
90.7 D.
65.2' plat
(Dd. Dist. Not Given)
D. Not Giv.
20.2' D.
40' Dd.
36.5' Plat
Used
80 Dd. & Used
Plat 17.5'
43.5'
MARY LUDWAY D.V.1017 P. 294
PCL #2
0.275 AC.
4.
5.
VINCENT
Iron Pin Set
Spike Set
205°07'18" Calc
80' D.
40' Dd. & Used
STANLEY & HELEN JANKEL DV. 1003 P. 337
150' PD.
100' PD.
AUSTIN & MARION G. DRAPER DV. 1113 P. 741
130' PD.
165' Plat
(HOUSE)
(GARAGE)
40' Dd.
89°55' Calc.
517 D.
155.26' Calc.
MARY LUDWAY D.V. 1017 + P. 294 PCL. # 1
VINCENT
(STORE)
39.4'
9.5'
3.3'
1.8'
4.0'
20'
20' Dd.
60' Plat
Iron Pin Fd.
40' Dd. & Meas. 60' Plat
90°03' Used
AVENUE
GLADYS L. DUUFEE DV. 991 P. 142 PCL. # 2
2209' Plat
Not Used.
100' PD.
Iron Pin Fd.
Iron Pin Set
Spike Set
Used
Used
Used