LAUNDON . SIMON . CAHL & ASSOC. INC.
CONSULTING ENGINEERS & SURVEYORS
219 COURT ST. ELYRIA, OHIO 44035

SURVEY FOR:

GEORGE COOK
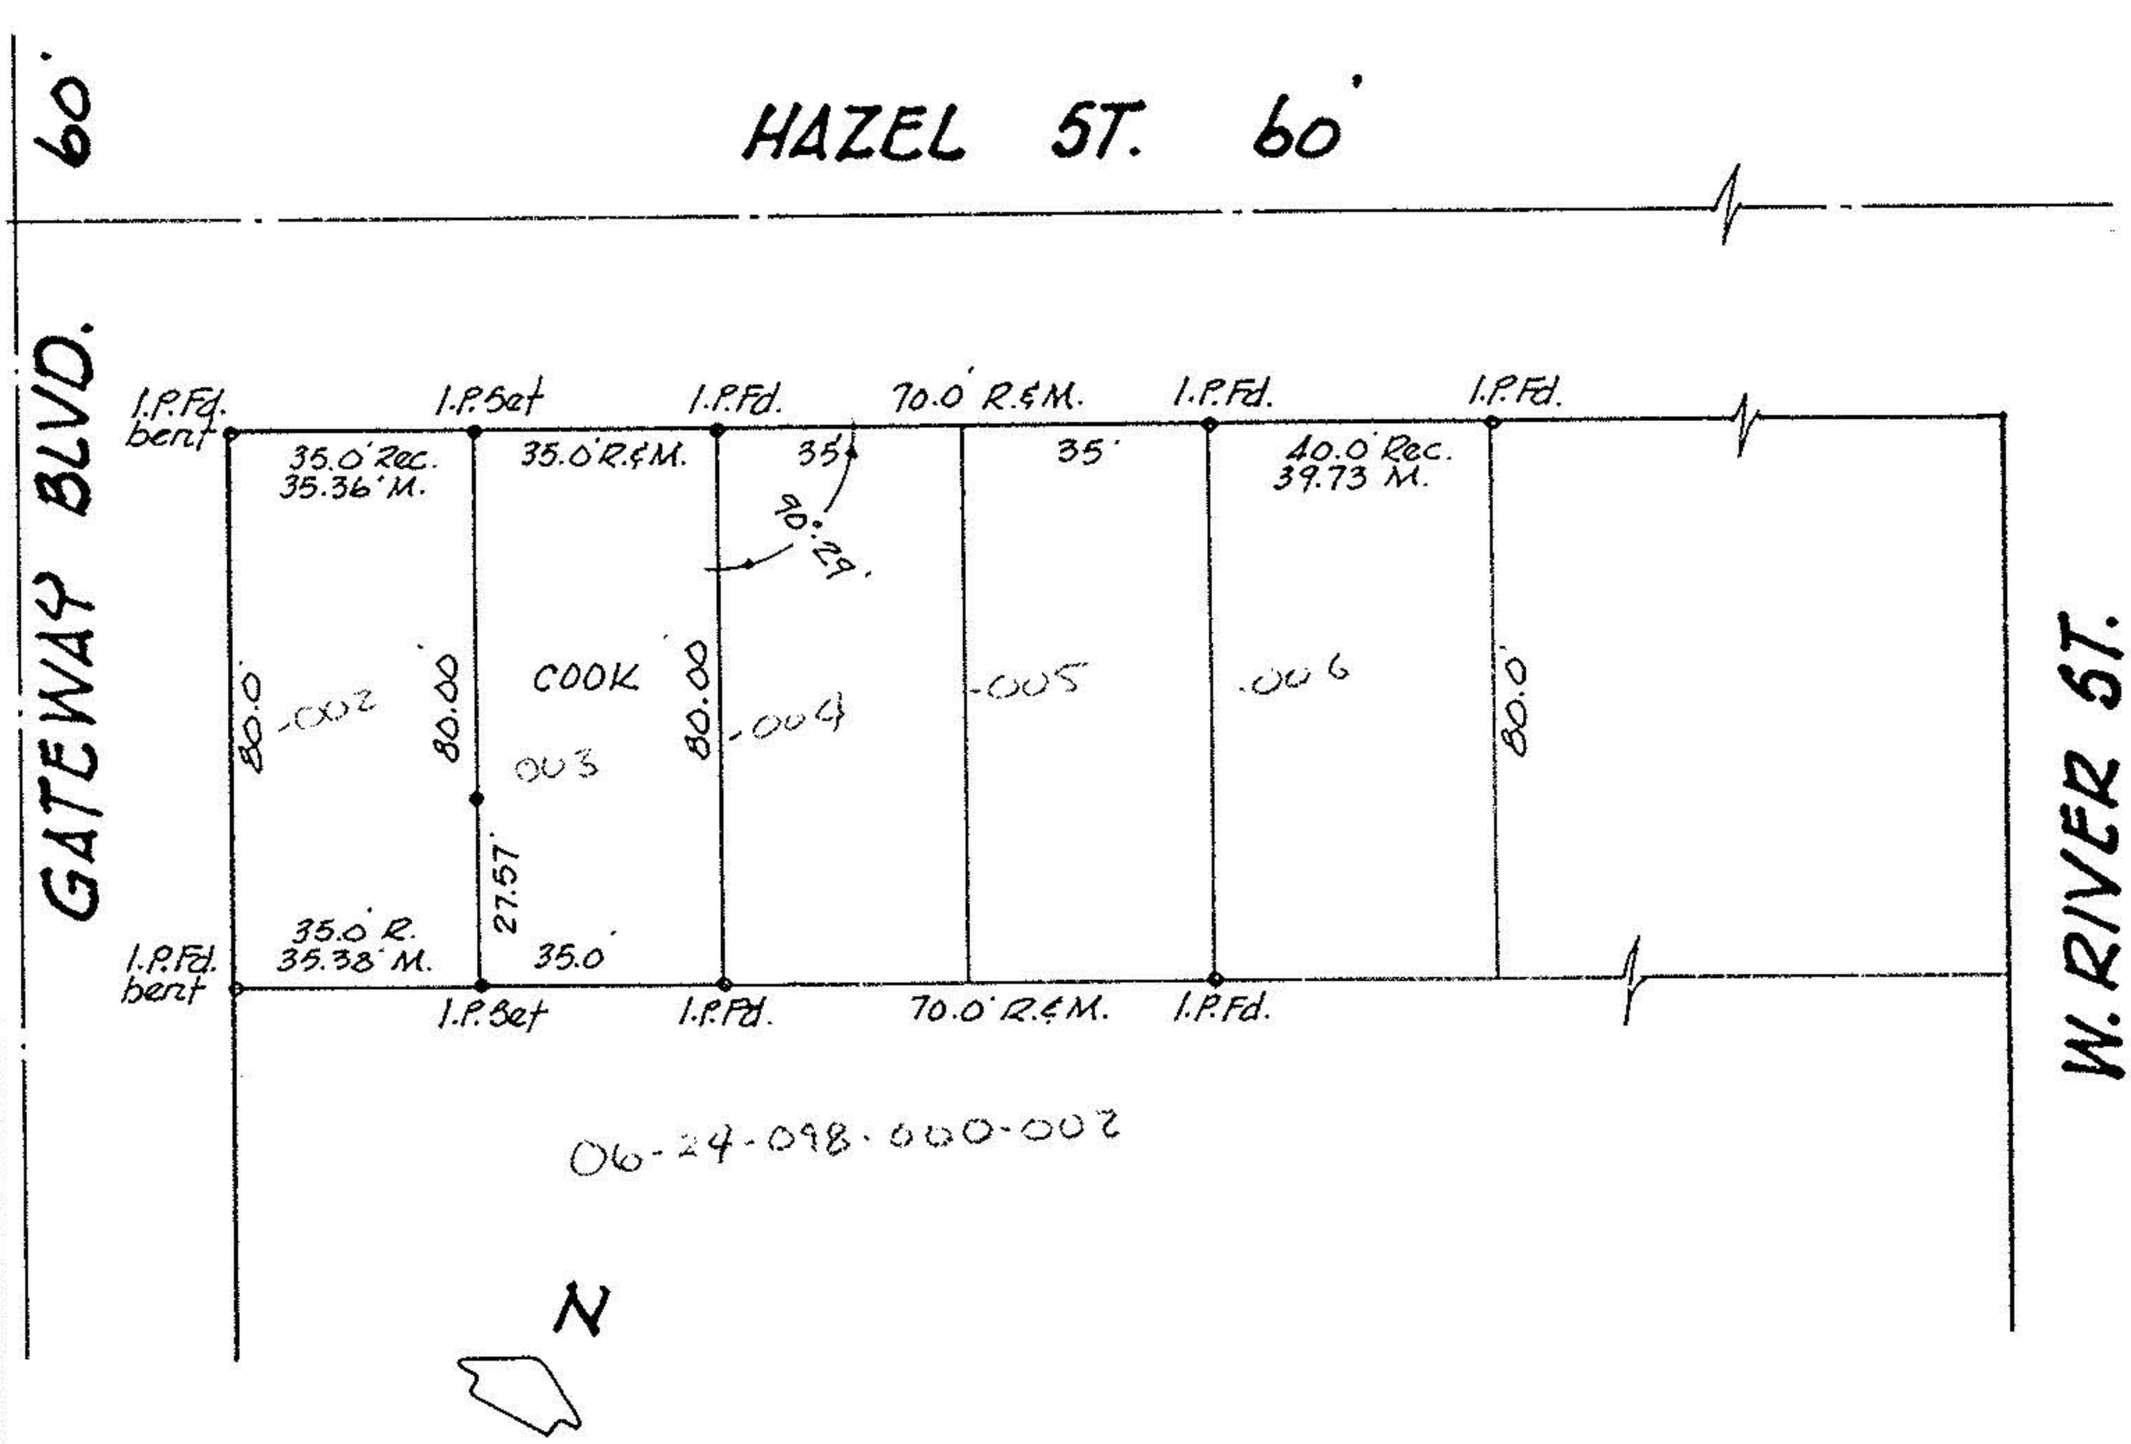
Orig. Lot 98	City of ELYRIA	Date 5-7-86 Scale 1"=40'
Orig. Sec	Village of	Dwn. by R.G.S Chkd. by C.J.
Tract WEST OF RIVER	County of LORAIN	Job No. 86-1488 F.B. No
Township of ELYRIA	State of OHIO	Printed