

Subject(s) 10 & 11

Subdiv TATTERSALL'S SUBD.  
 P.V. 7 P. 26.

Township ELYRIA 123 Tract WEST OF BLACK RIVER  
 Orig. Lot(s) 123 Soc. State of Ohio  
 County of LORAIN State of Ohio  
 Corporation \_\_\_\_\_


APPROVED  
 LORAIN CO.

MAP DEPT.

DATE 12-3-80

PAGE 6-100

BY Carolyn  
 VOID AFTER 13955

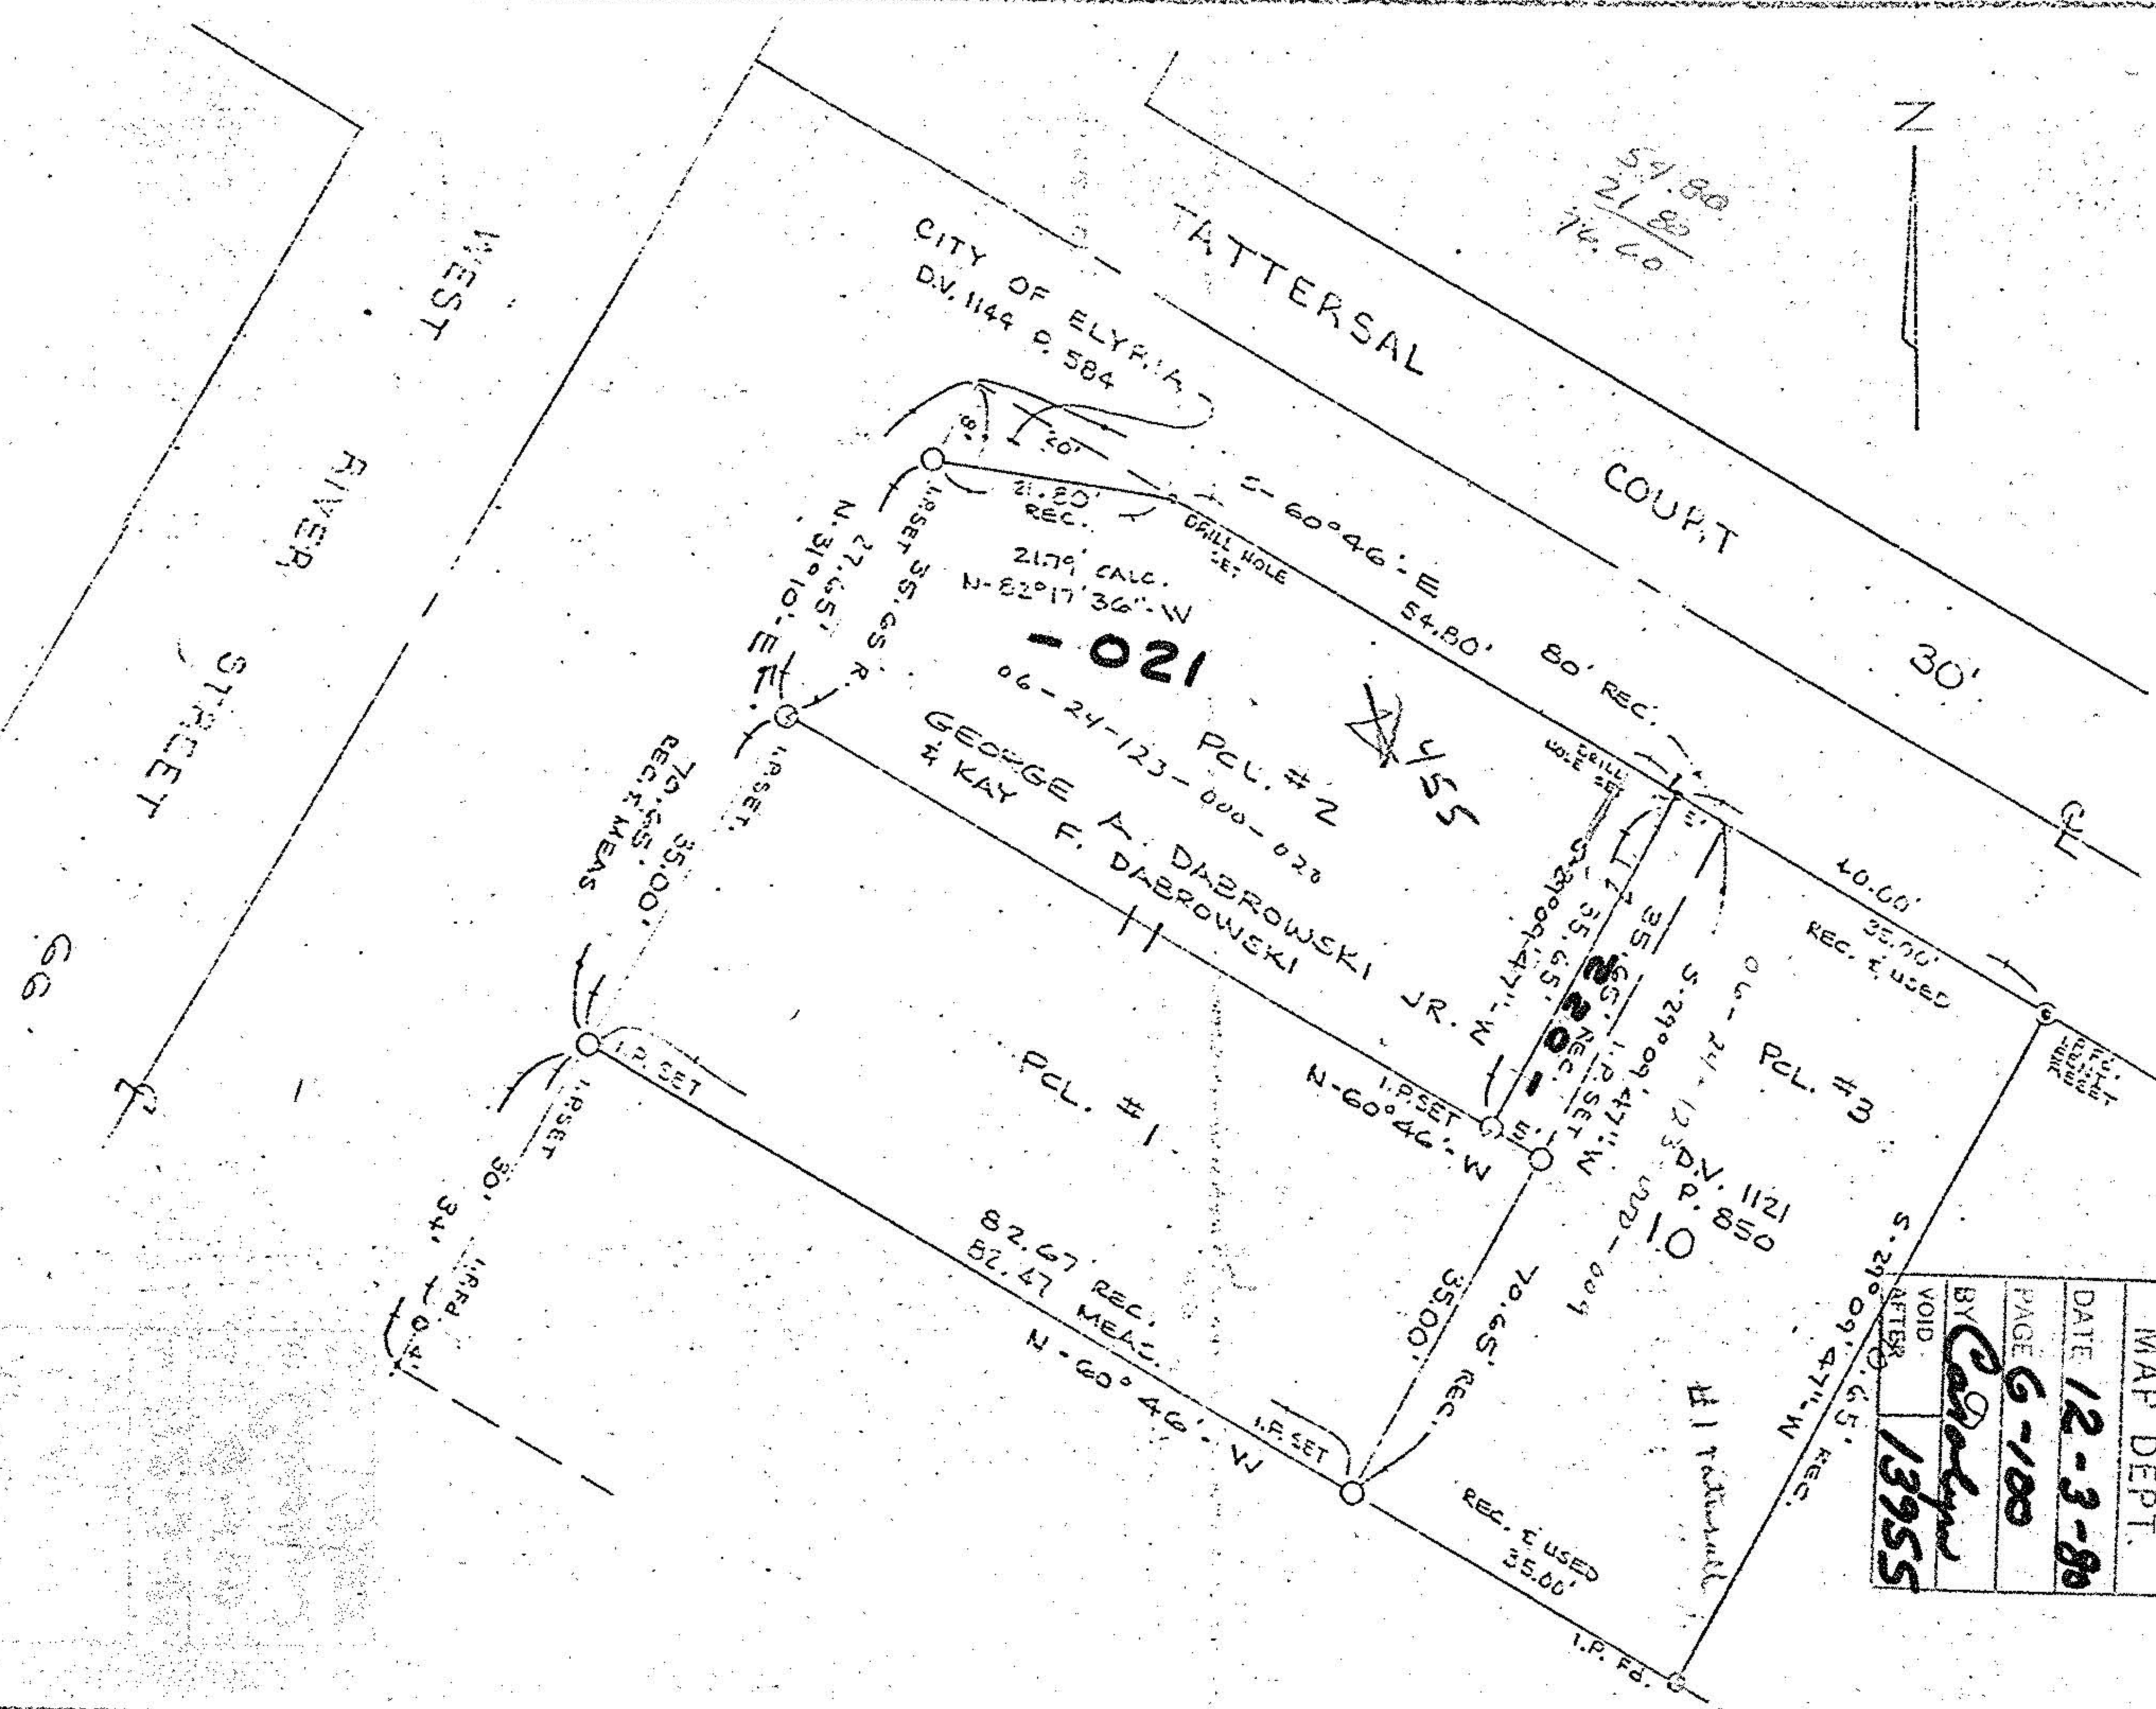

Prepared for: GEORGE DABROWSKI 529 EAST ST. AMHERST, OH.

Scale: 1" = 20' Date: 9.25.78 Dr. by: \_\_\_\_\_ Job No 78-272