06-24-009
010
102-029,031

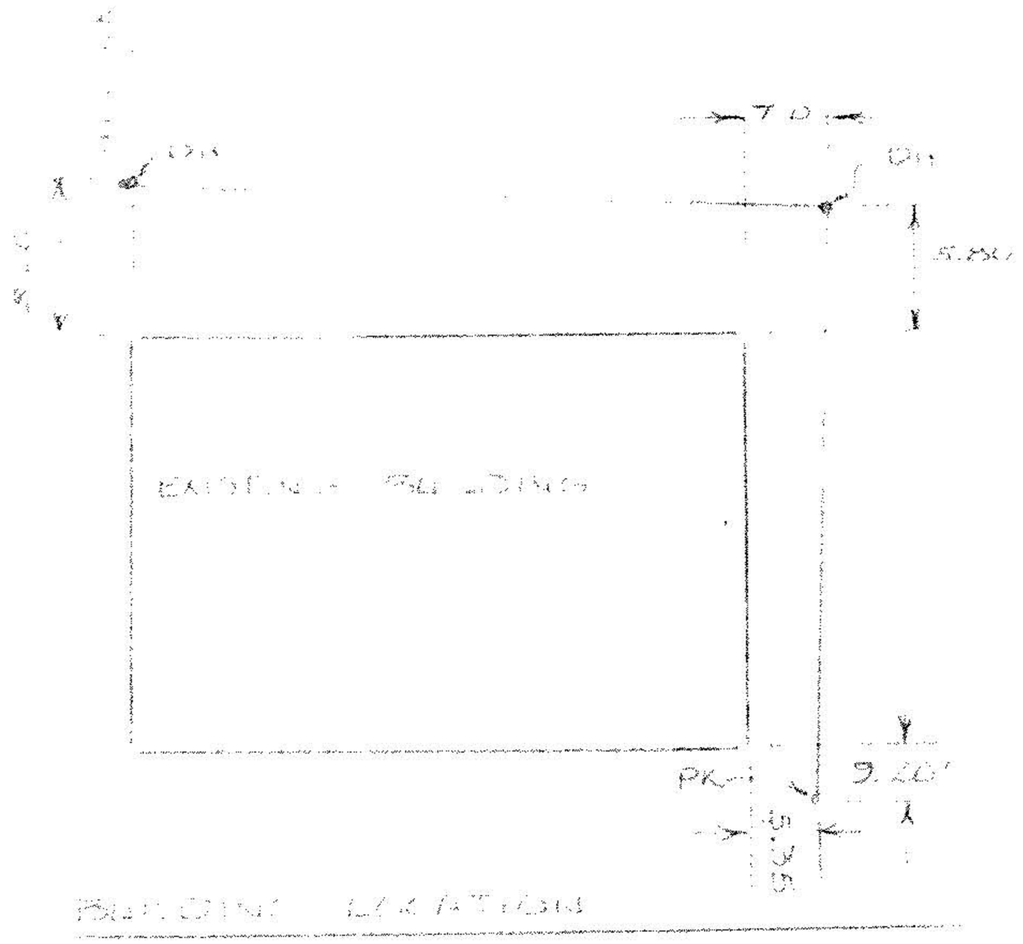

BOUNDARY SURVEY [illegible]
PART OF [illegible] 9, 0 & 102
WEST OF BLACK RIVER
CITY OF [illegible]
COUNTY OF LORAIN
STATE OF OHIO

Carl R. Anderson
CARL R. ANDERSON P.S. #6582

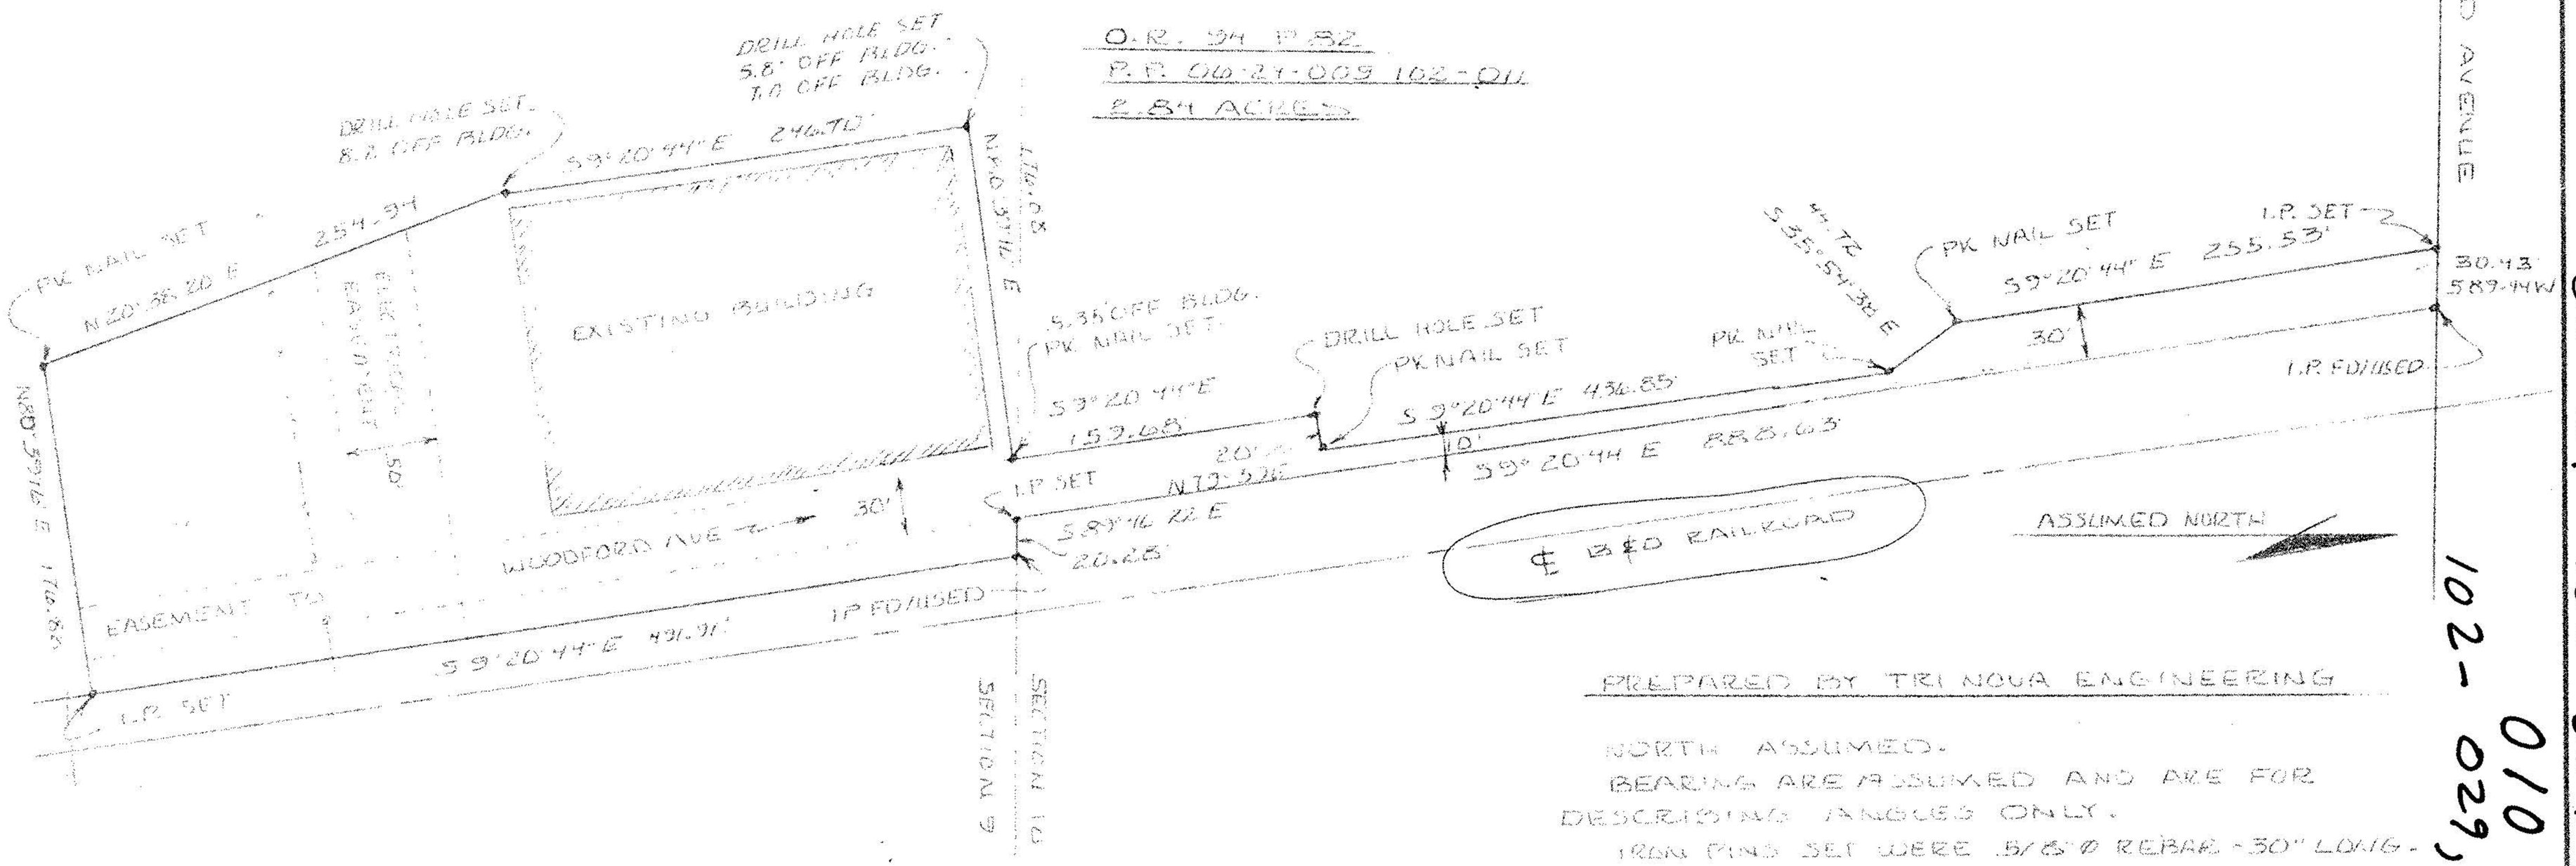

PREPARED BY TRI NOVA ENGINEERING

NORTH ASSUMED.
BEARING ARE ASSUMED AND ARE FOR DESCRIBING ANGLES ONLY.
IRON PINS SET WERE 5/8"Ø REBAR - 30" LONG.
NOT TO SCALE.