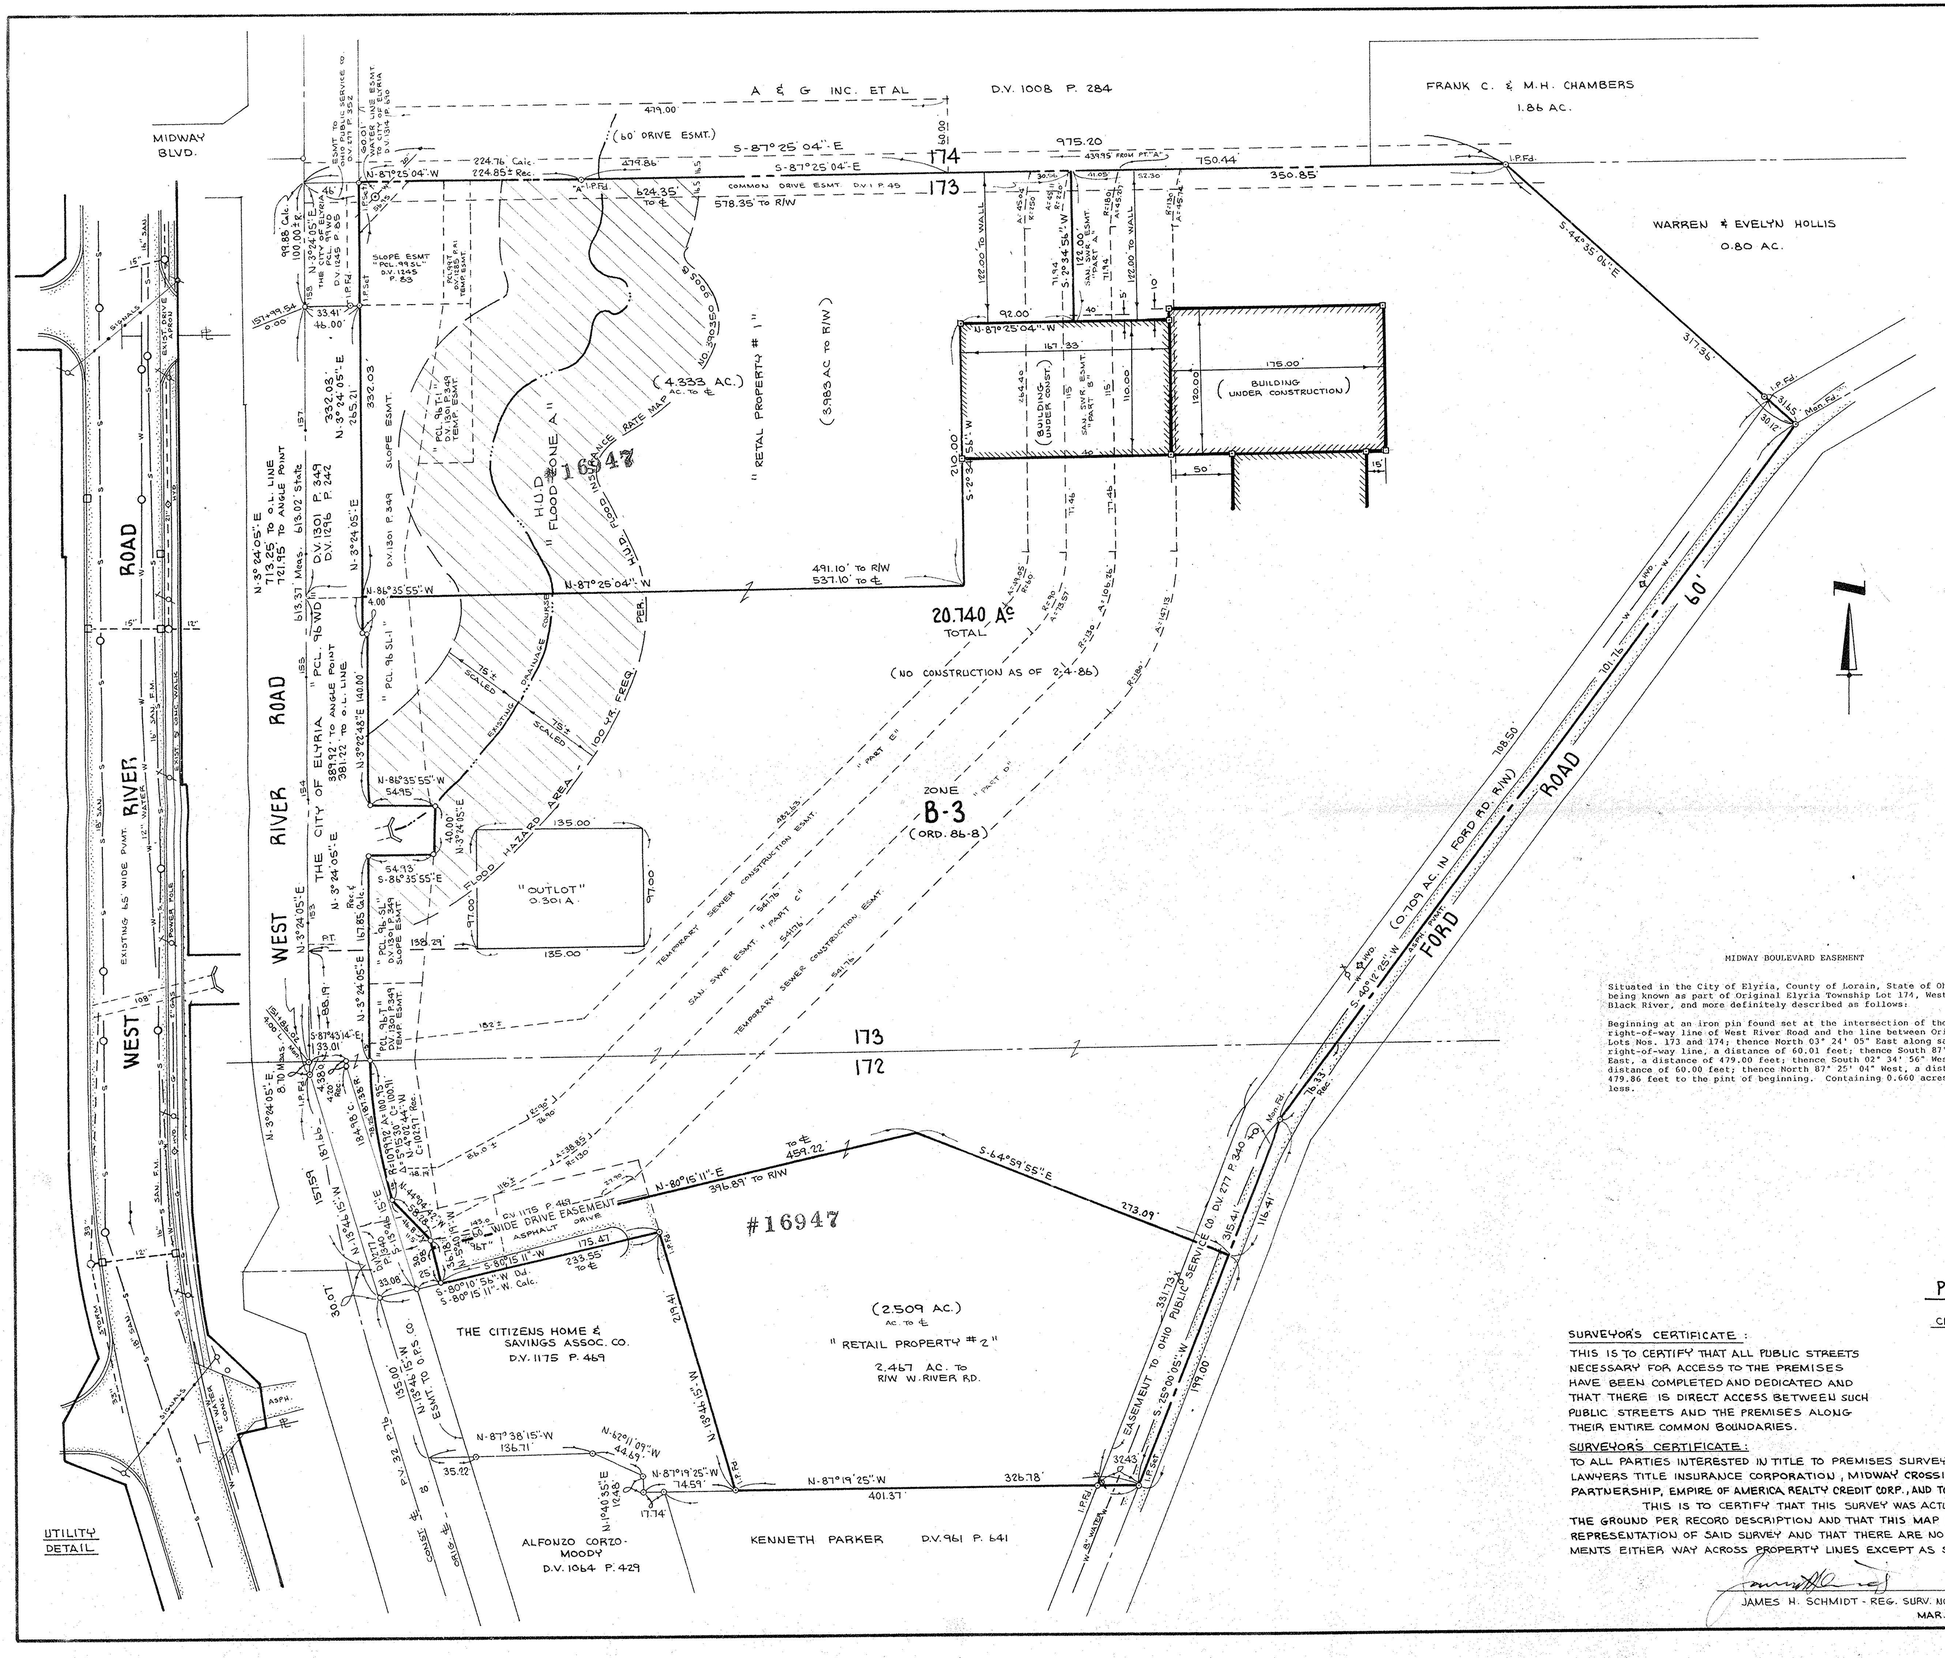
A & G INC. ET AL D.V. 1008 P. 284
FRANK C. & M.H. CHAMBERS
1.86 AC.
WARREN & EVELYN HOLLIS
0.80 AC.
MIDWAY BLVD.
WEST RIVER ROAD
WEST RIVER ROAD
FORD ROAD
S-87°25'04"-E
N-87°25'04"-W
S-42°35'06"-E
N-3°24'05"-E
N-87°25'04"-W
S-2°34'56"-W
N-87°25'04"-W
S-2°34'56"-W
N-87°25'04"-W
N-86°35'55"-W
N-3°24'05"-E
N-3°24'05"-E
N-3°24'05"-E