
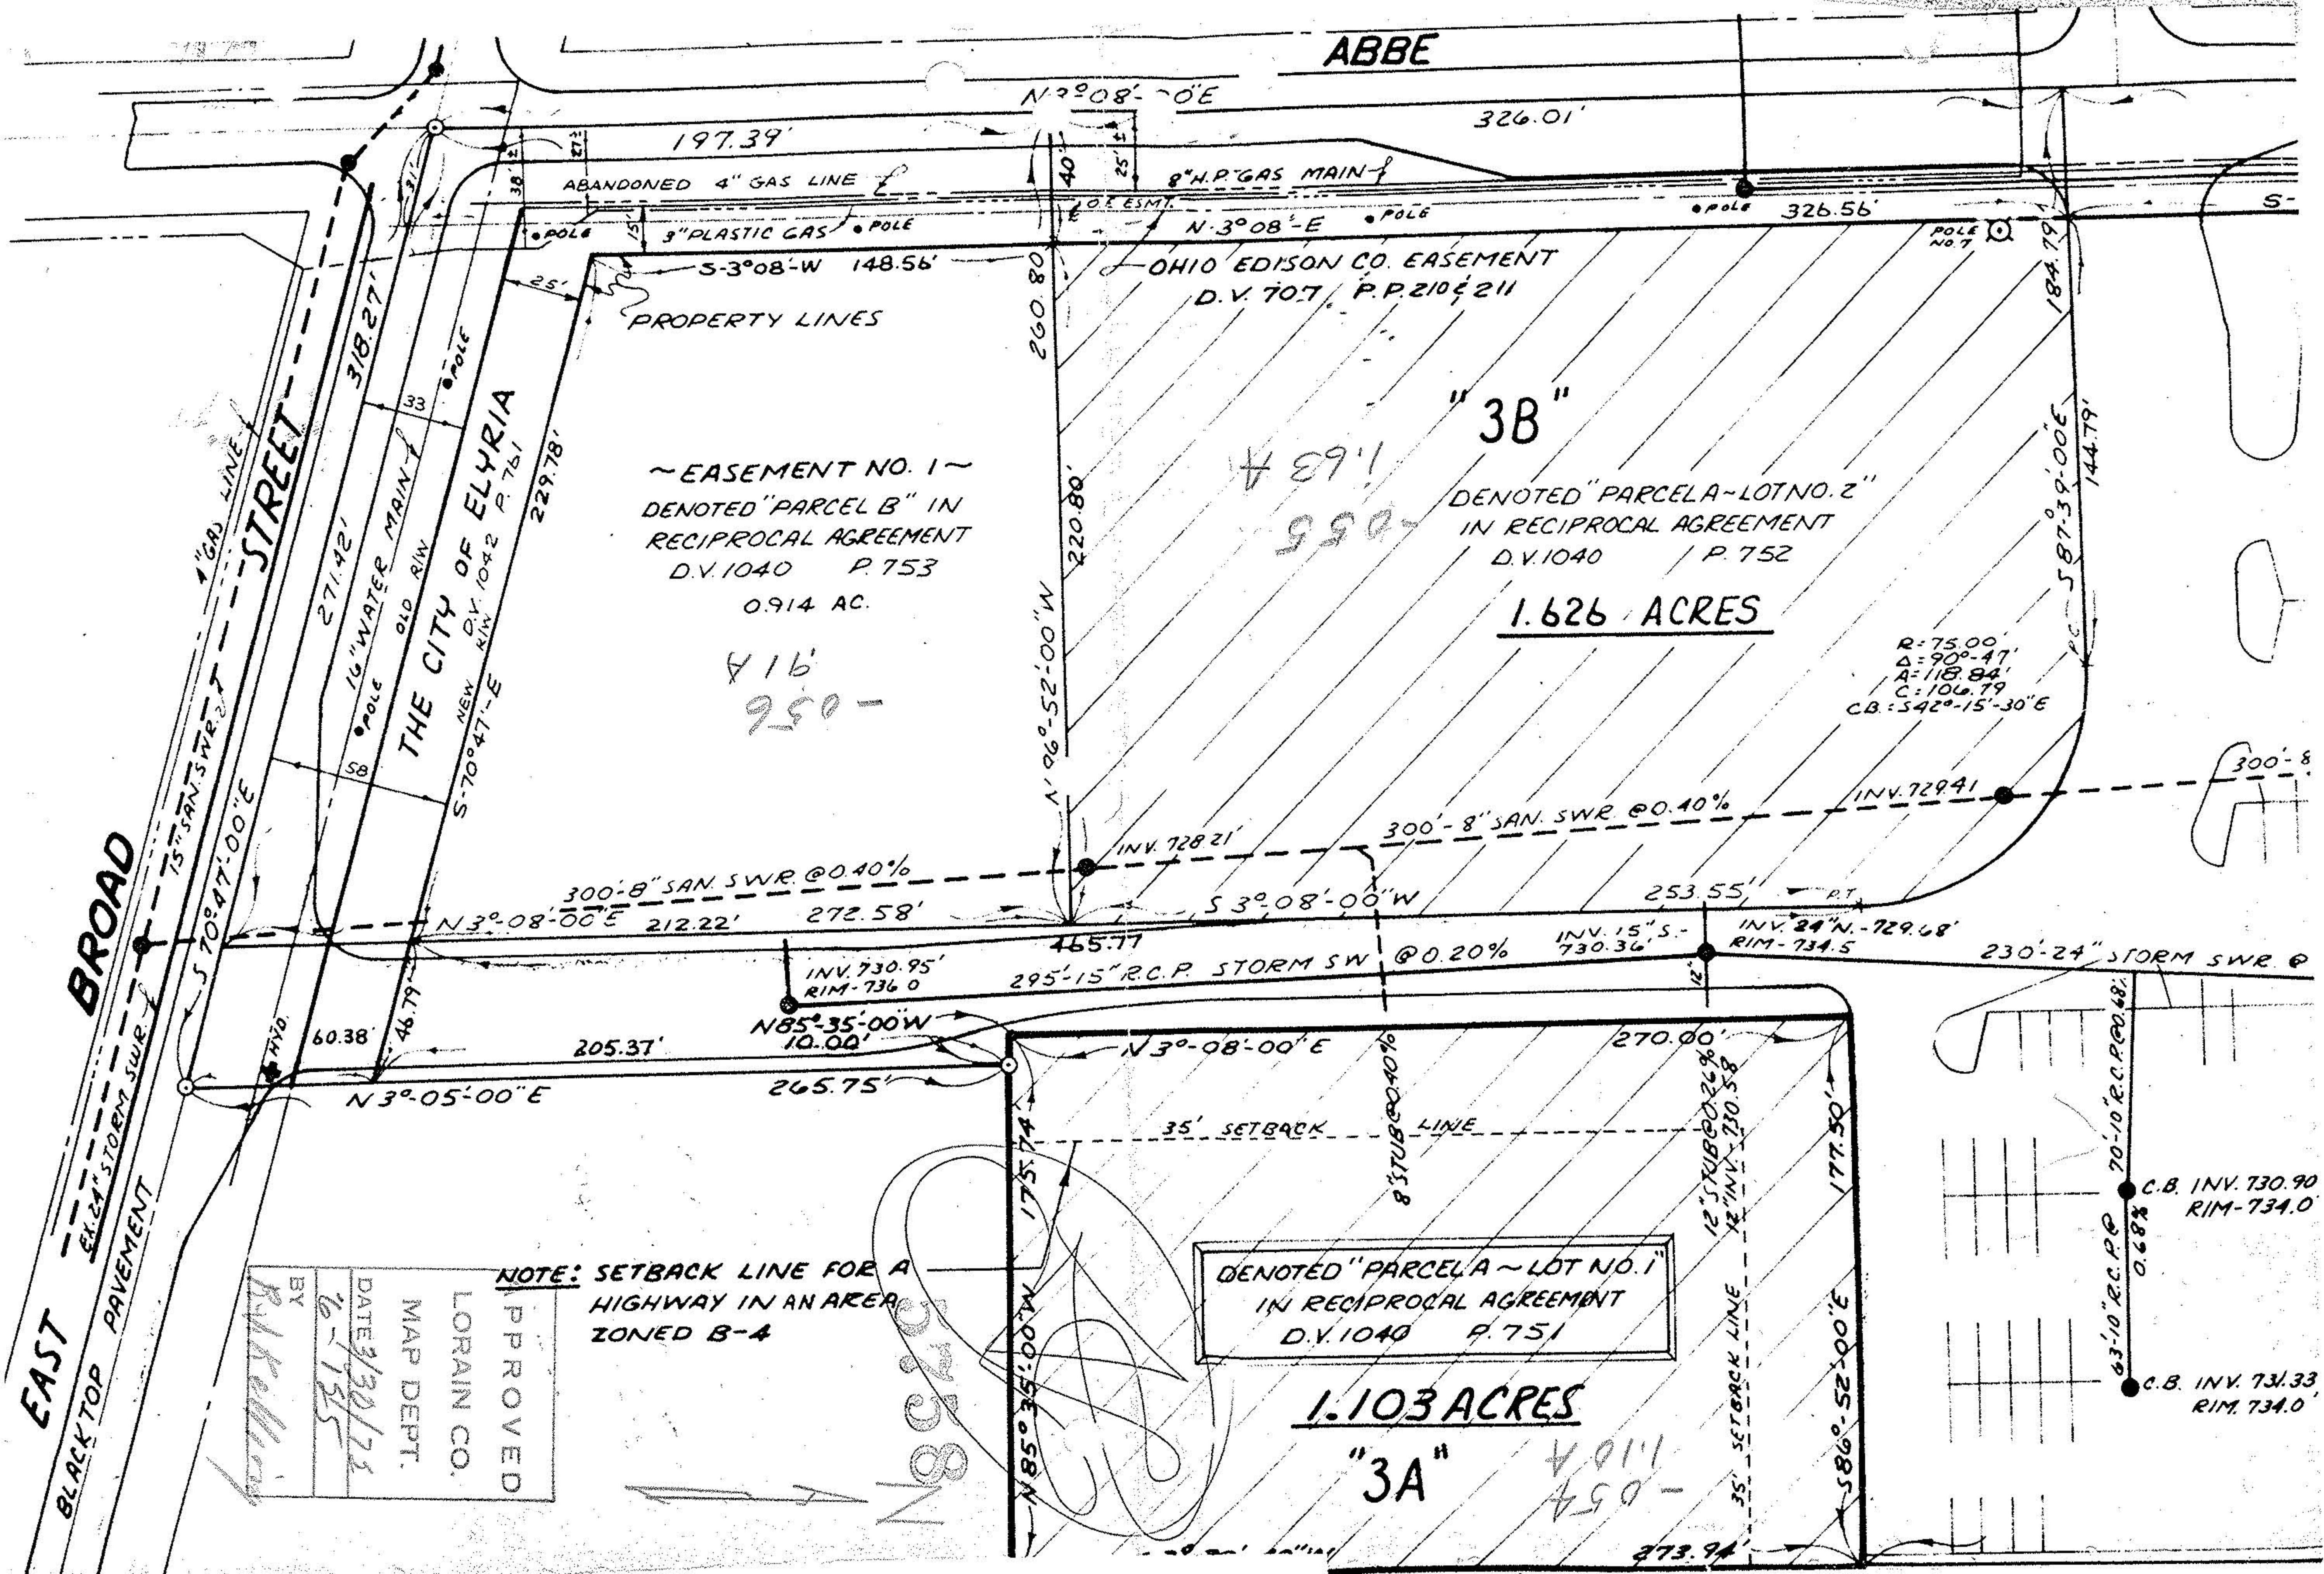
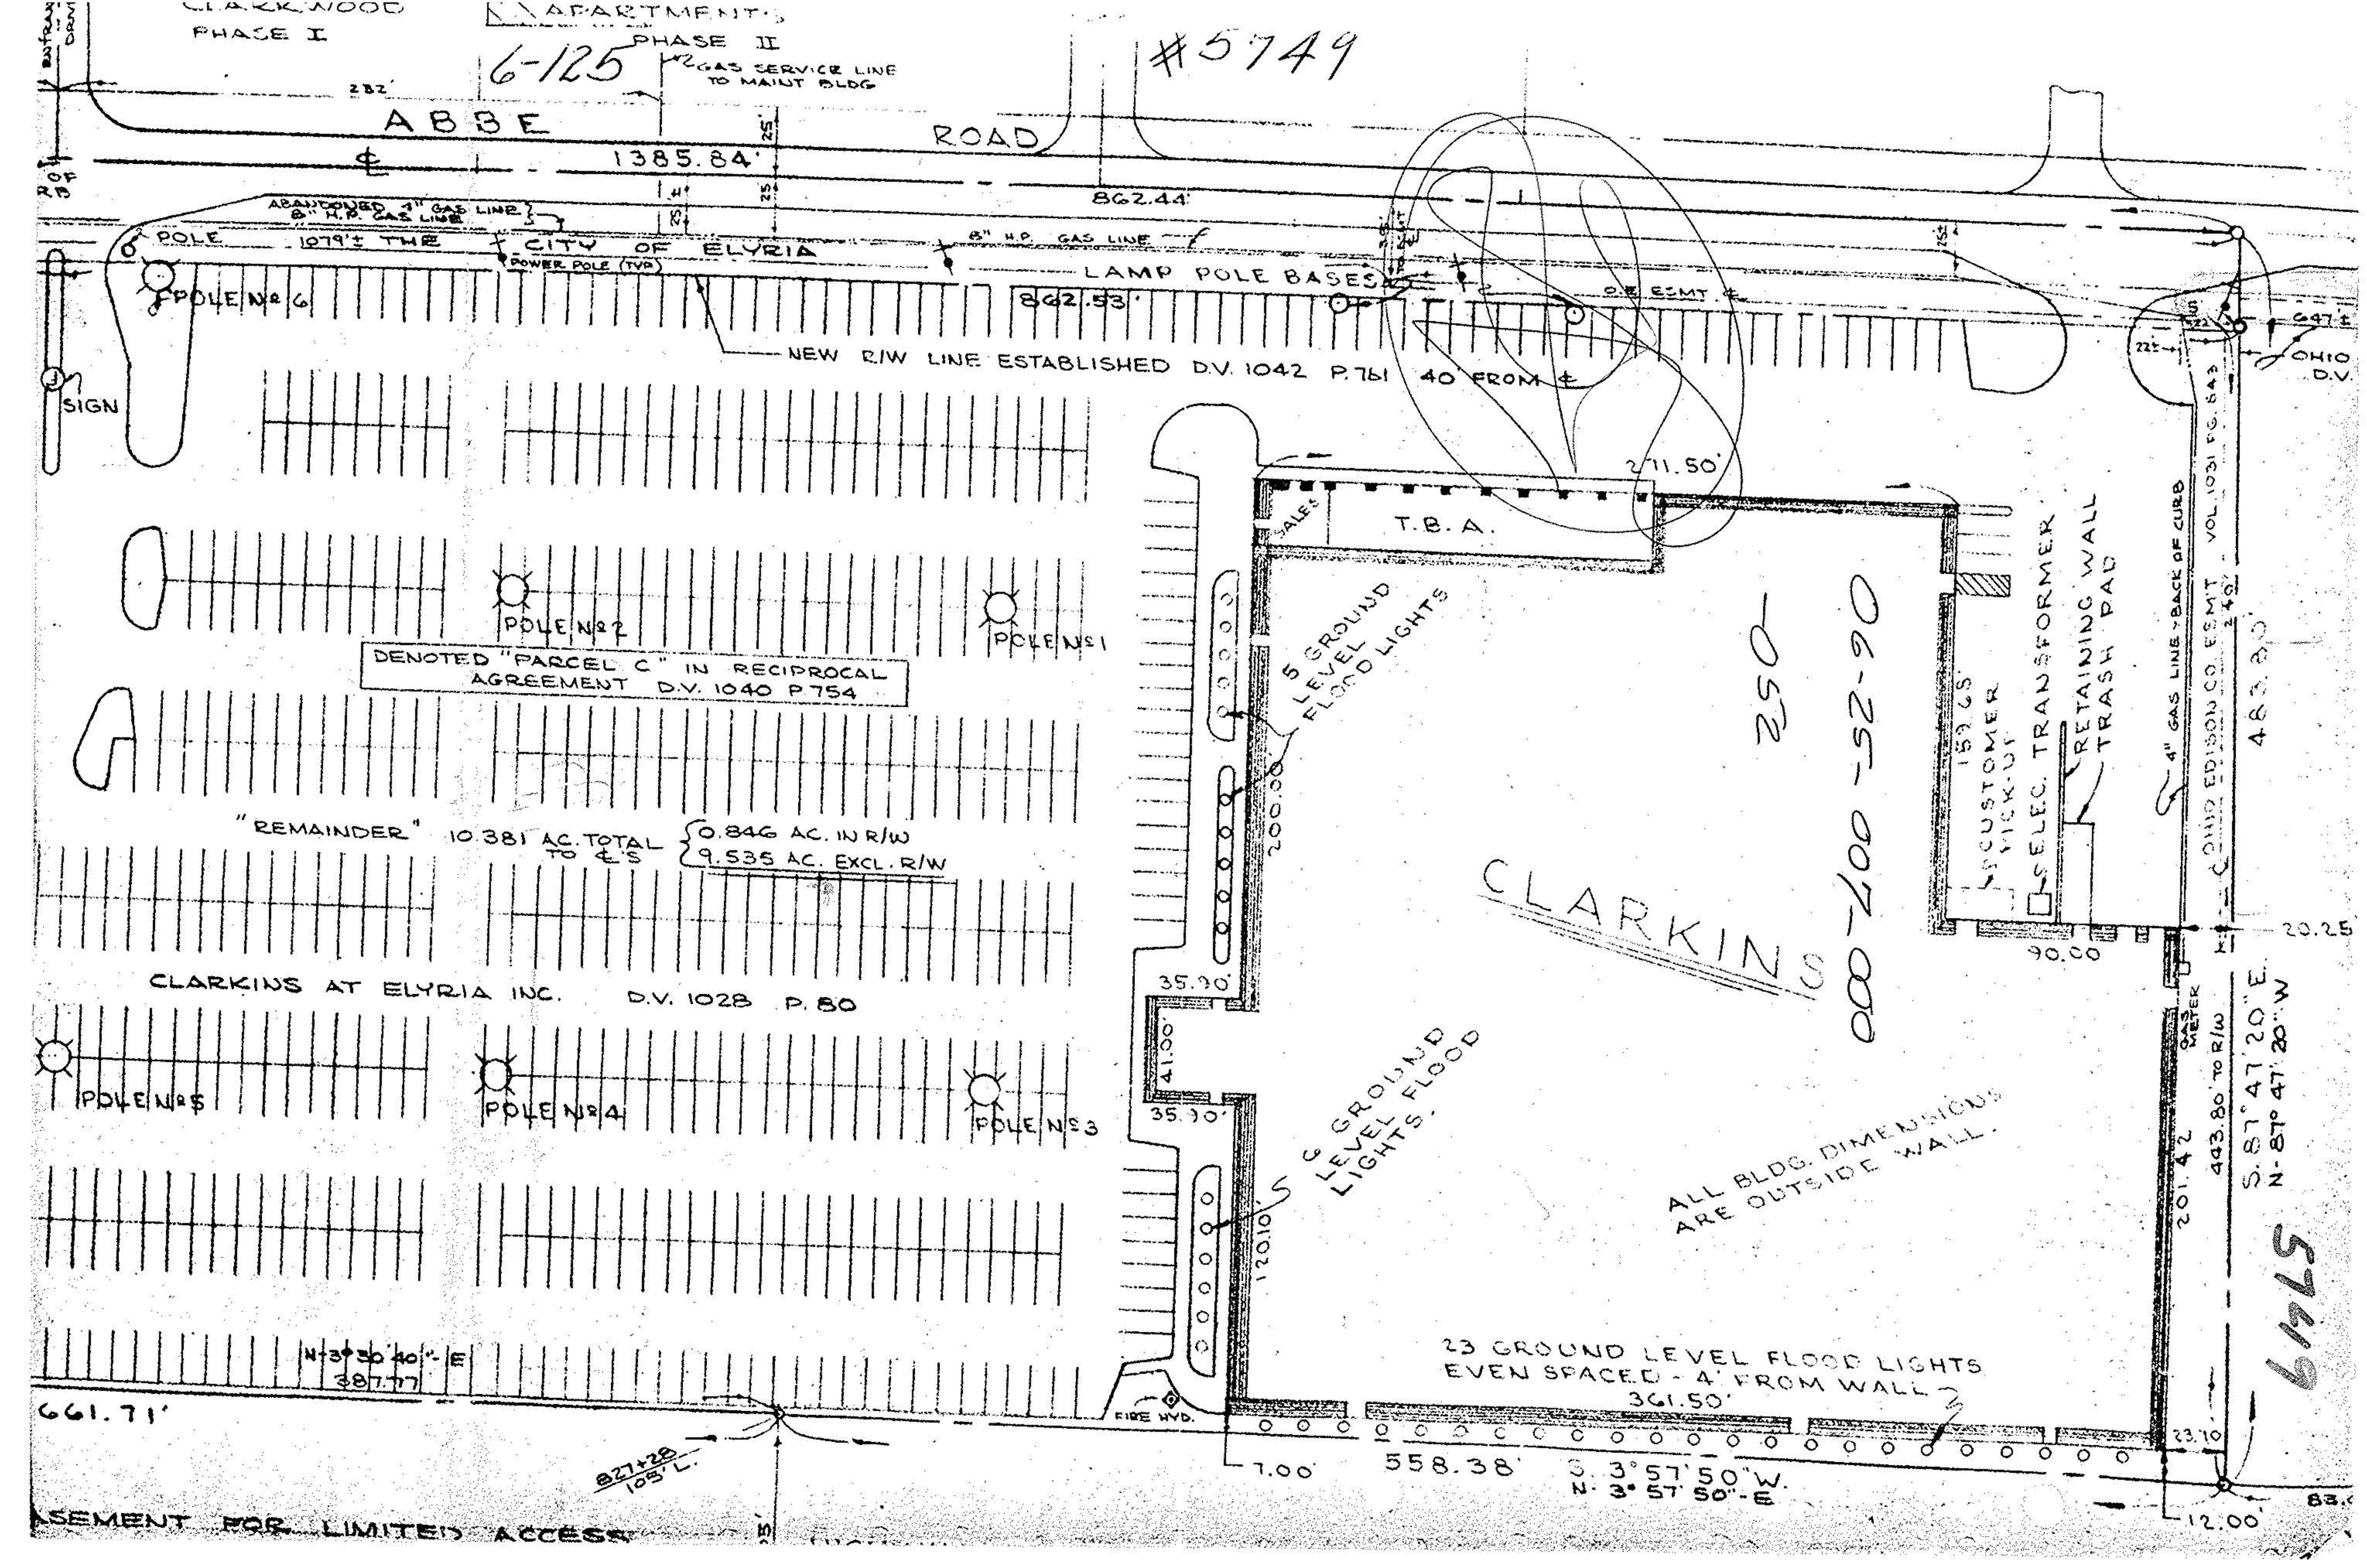


6-125

#5749

06-25-007-000-055

CLARKWOOD PHASE I

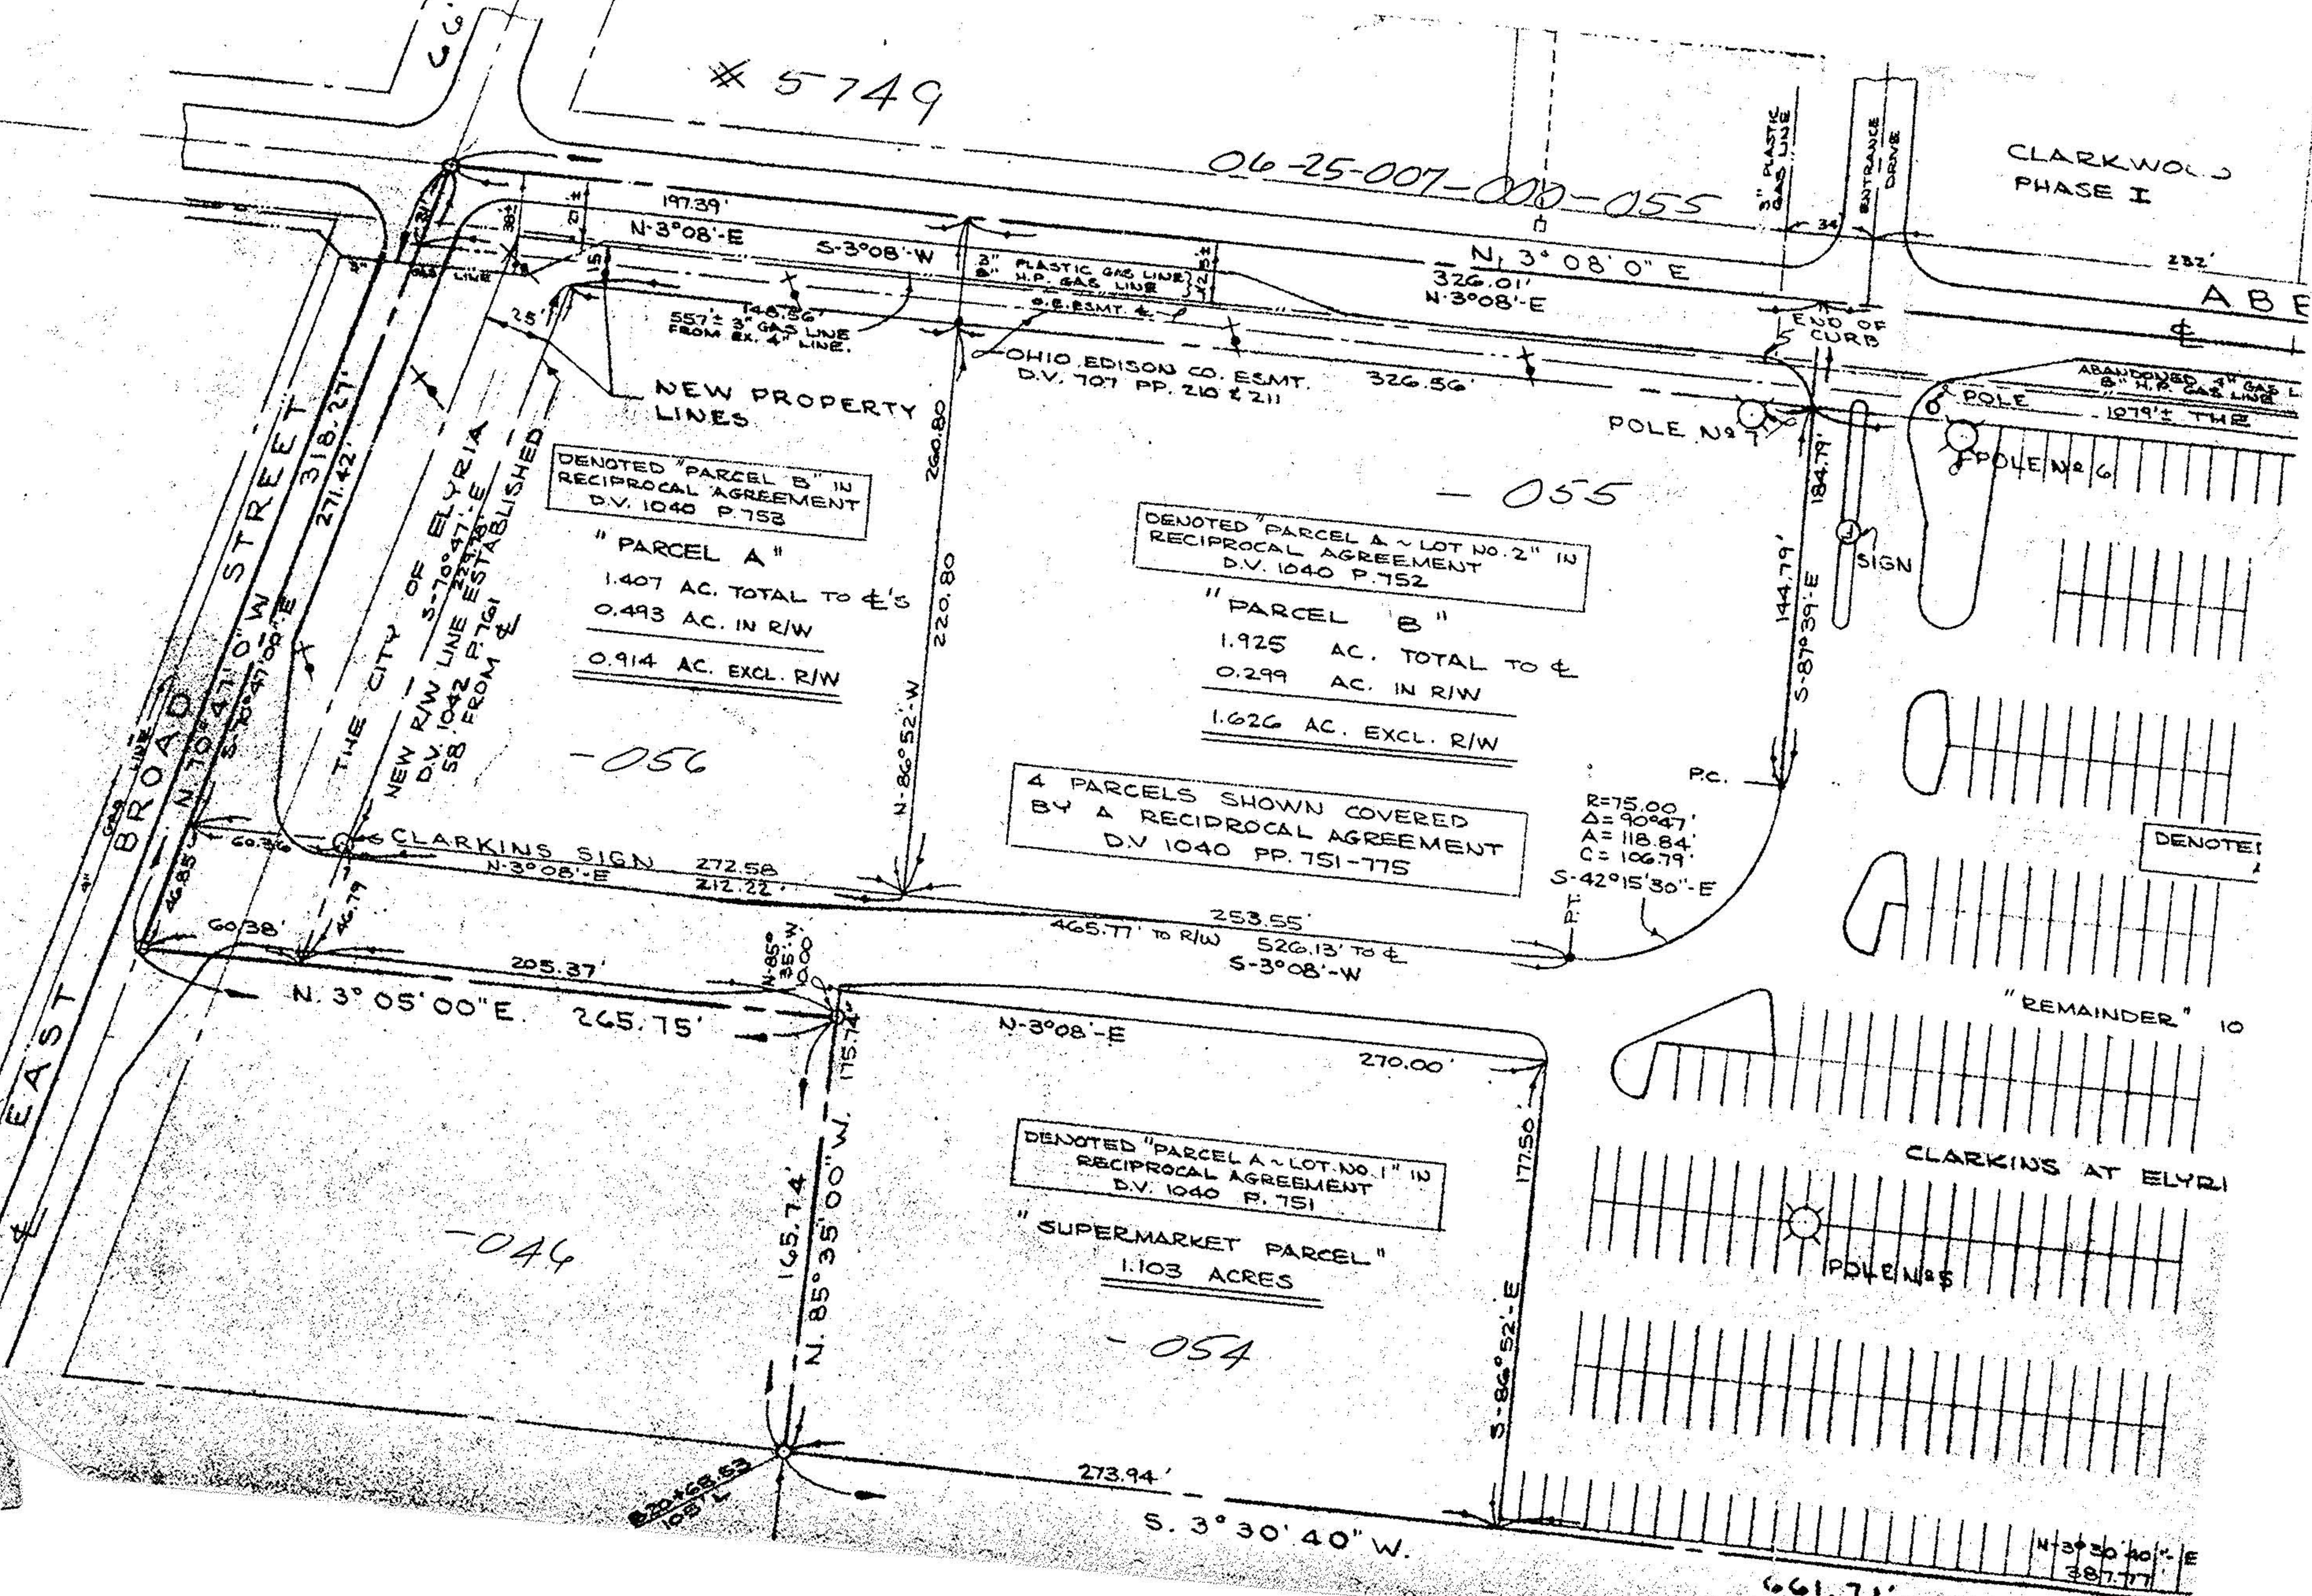

NOTE: SETBACK LINE FOR A HIGHWAY IN AN AREA ZONED B-4

APPROVED	DATE	BY
MAP DEPT.		