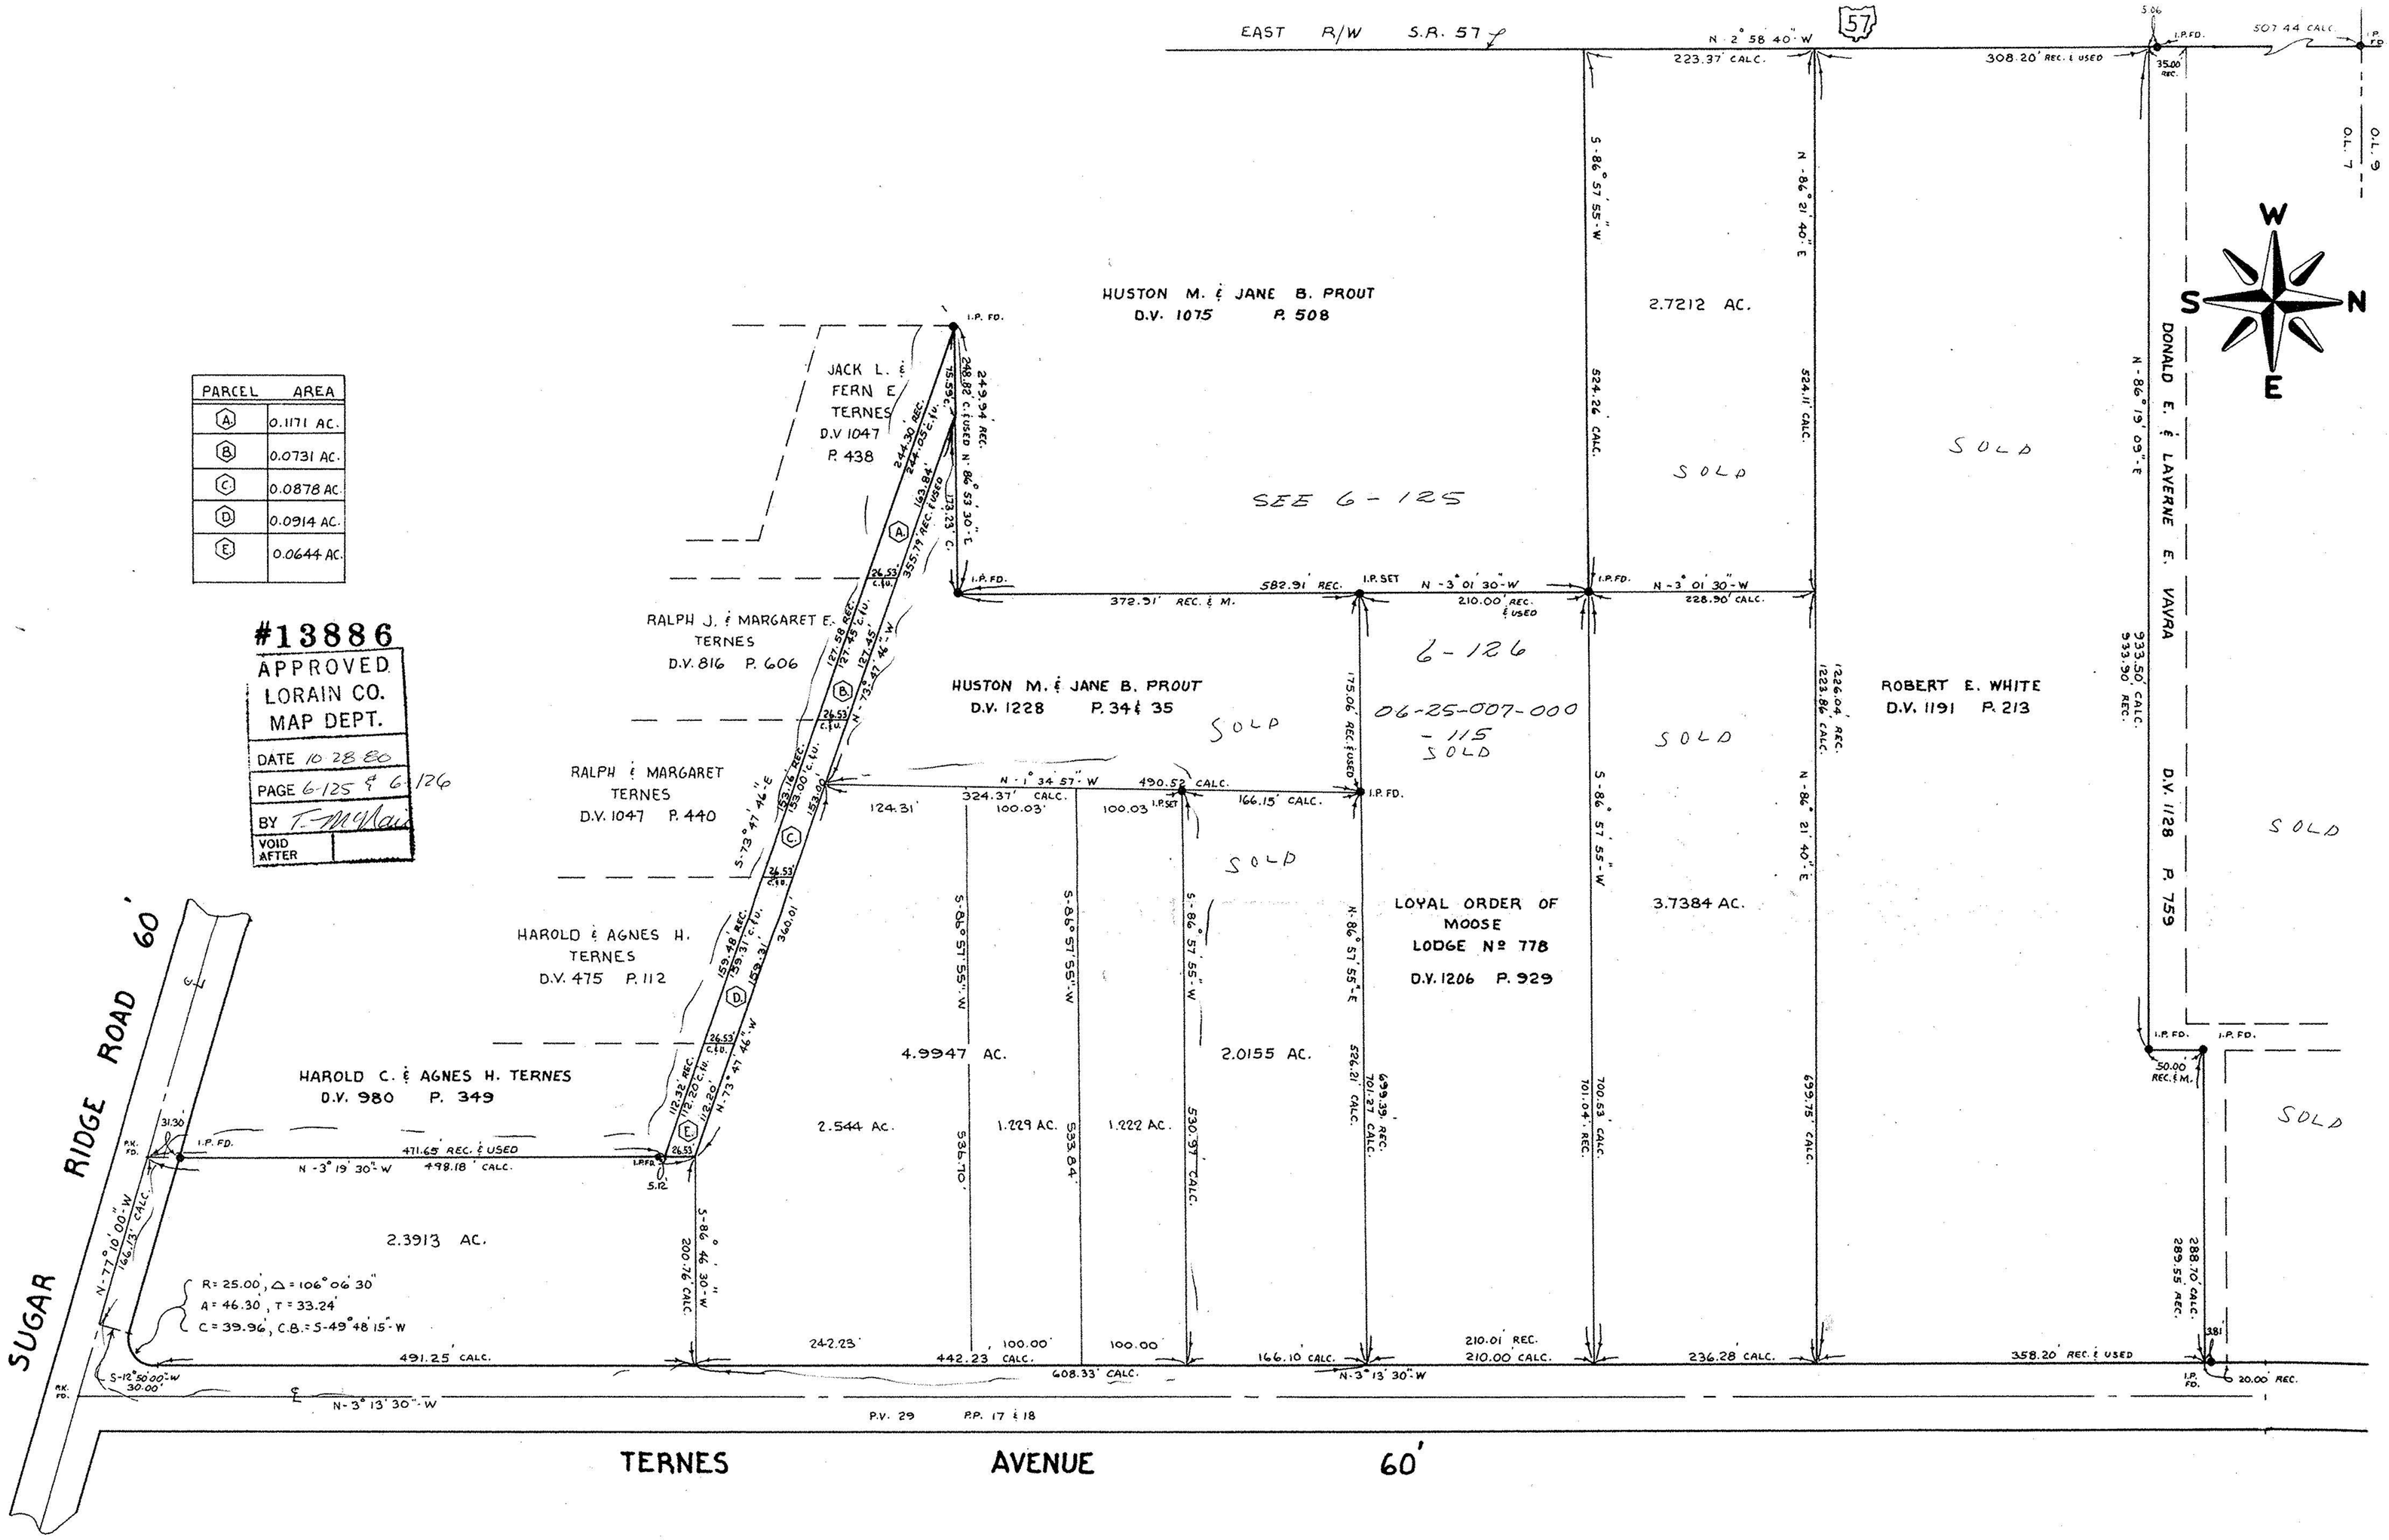

PARCEL	AREA
A	0.1171 AC.
B	0.0731 AC.
C	0.0878 AC.
D	0.0914 AC.
E	0.0644 AC.

#13886
APPROVED
LORAIN CO.
MAP DEPT.
DATE 10-28-80
PAGE 6-125 & 6-126
BY T. McNair
VOID AFTER

PROJECT

BOUNDARY SURVEY
OF PART OF
ORIGINAL ELYRIA TOWNSHIP (EAST OF THE RIVER)
LOT Nº 7
CITY OF ELYRIA, COUNTY OF LORAIN
STATE OF OHIO

Rev. 1-22-80

Prepared for: HAROLD TERNES

Drawn by: K.V.S.
Checked by:
App. by:
Scale: 1" = 100'
Date:

KLEINOEDER · SCHMIDT and ASSOCIATES
ENGINEERS — SURVEYORS — CONSULTANTS in LAND PLANNING
ELYRIA - NORWALK - MEDINA OHIO

REFERENCES

SHEET NO. 1 of 1

JOB NO. 72-97