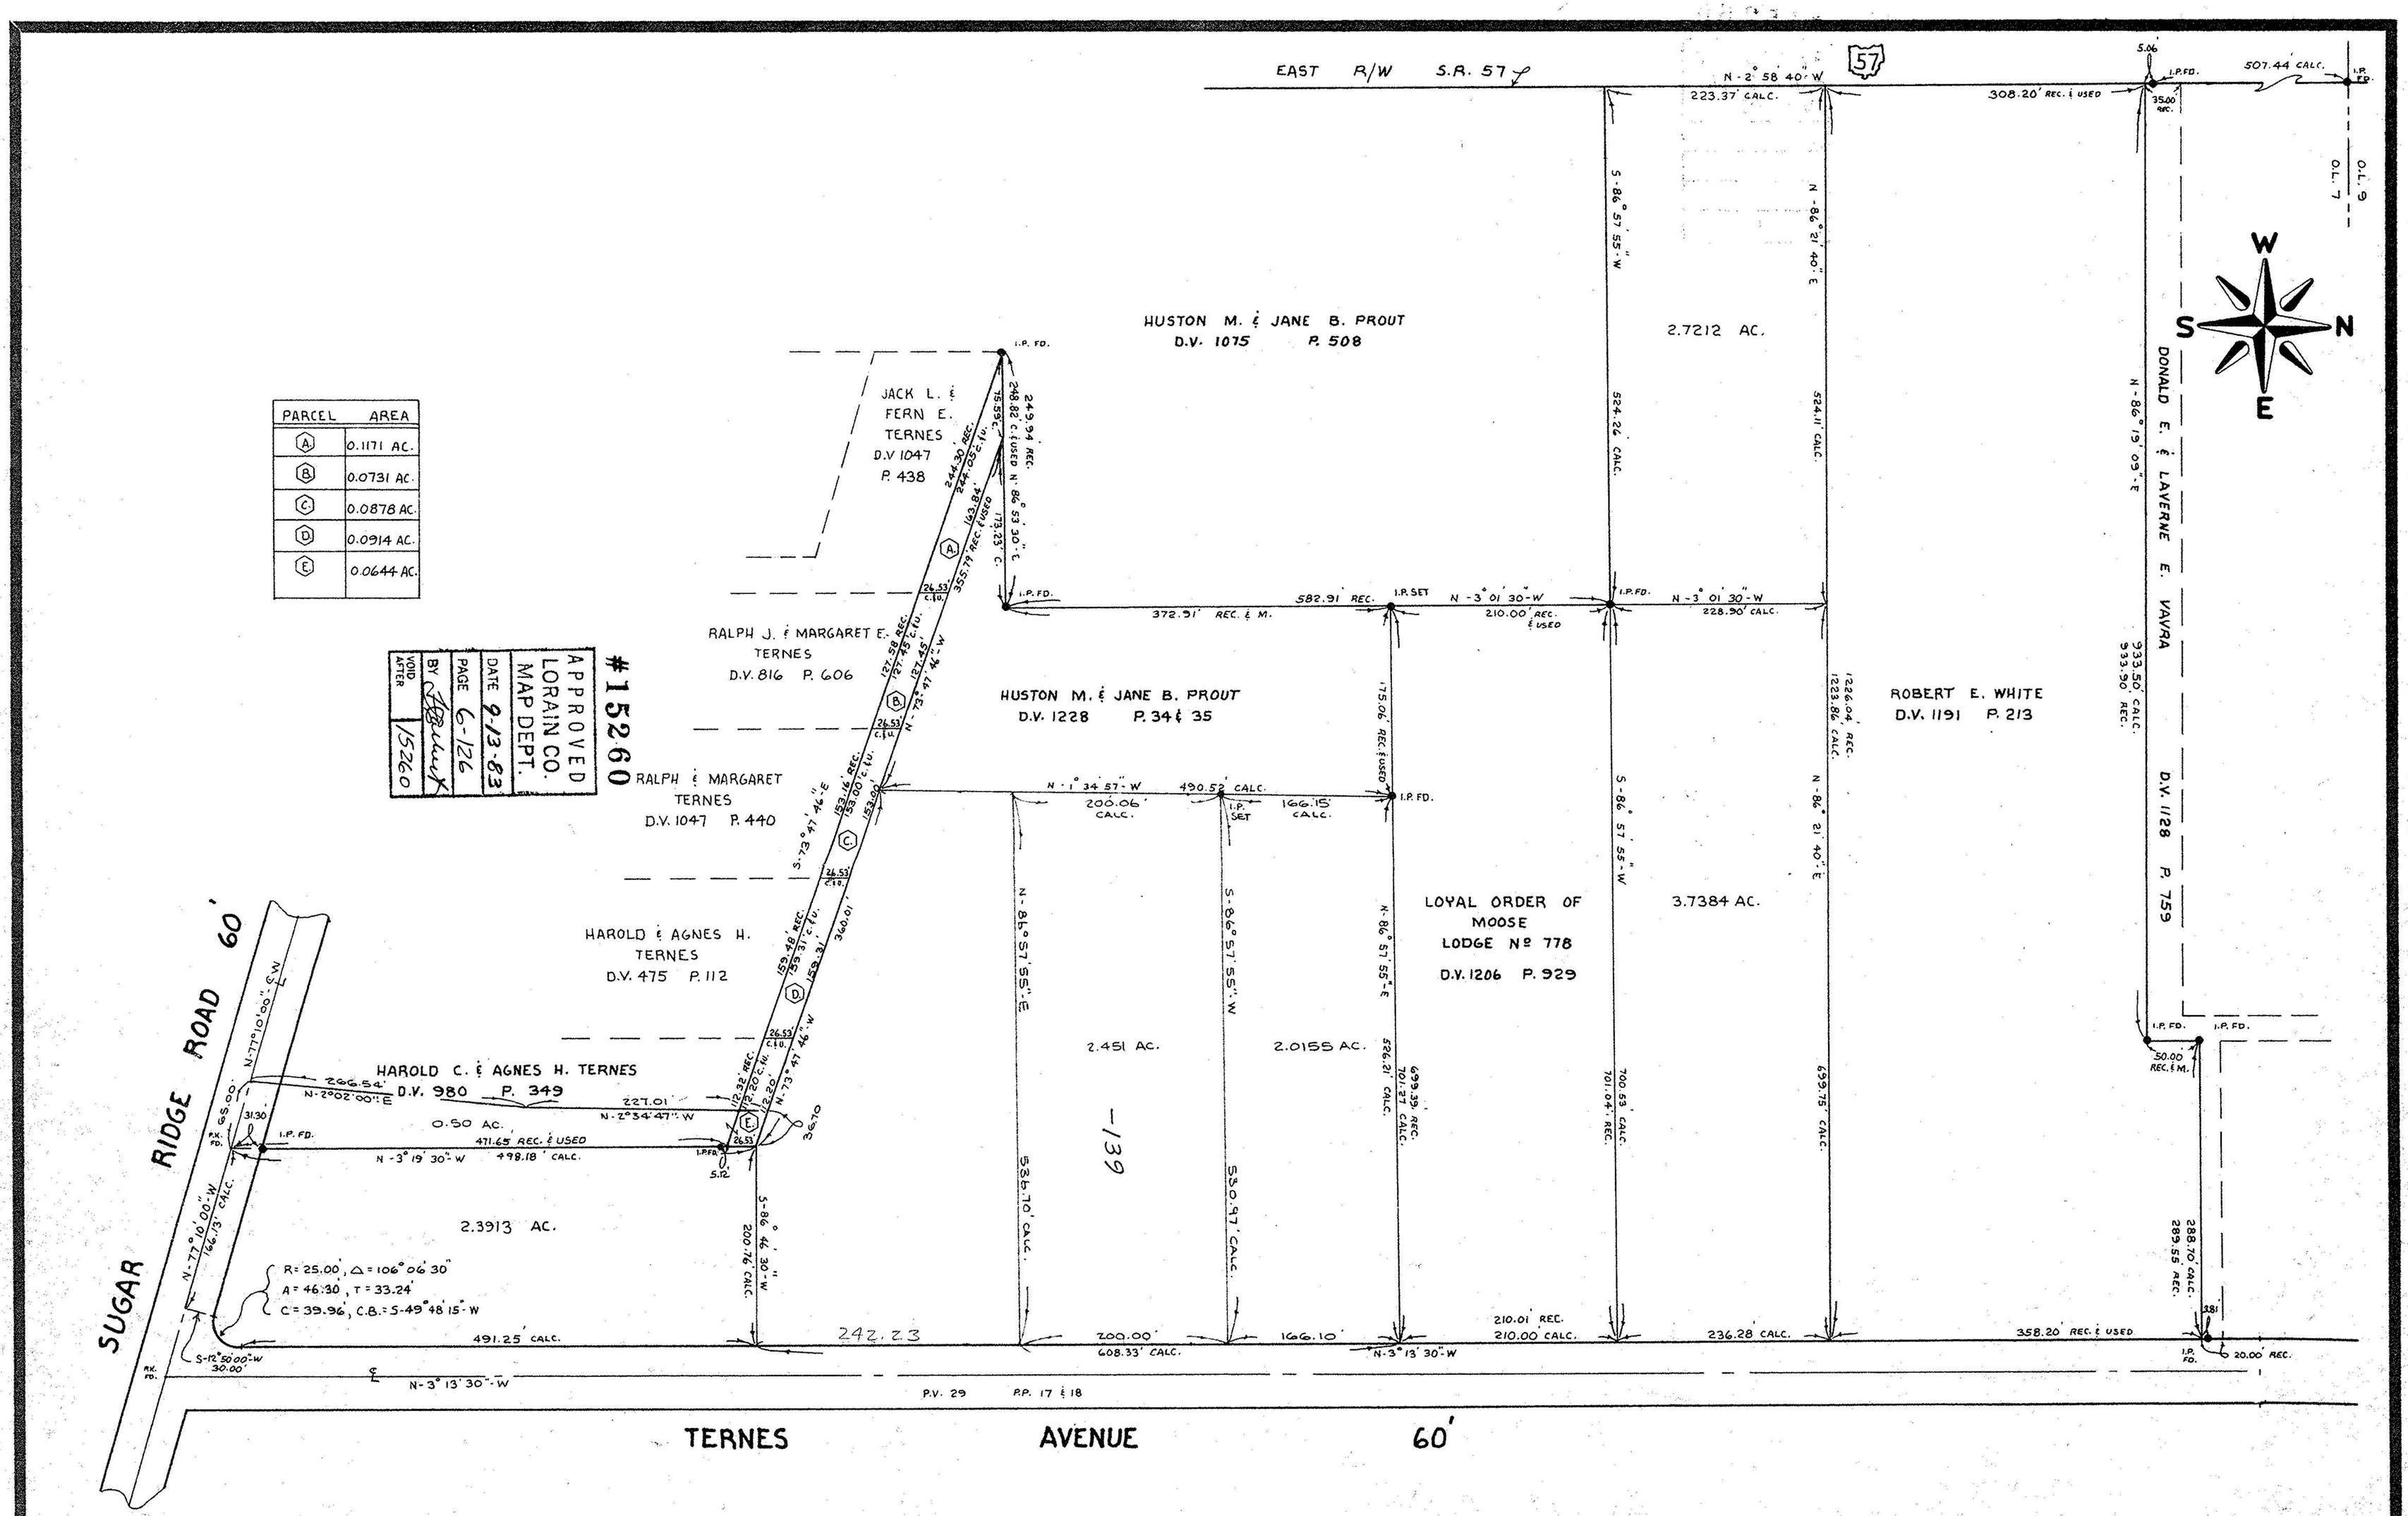

PARCEL	AREA
A	0.1171 AC.
B	0.0731 AC.
C	0.0878 AC.
D	0.0914 AC.
E	0.0644 AC.

APPROVED LORAIN CO. MAP DEPT.
DATE 9-13-83
PAGE 6-126
BY [signature]
VOID AFTER 15260

#15260

PROJECT

BOUNDARY SURVEY
OF PART OF
ORIGINAL ELYRIA TOWNSHIP (EAST OF THE RIVER)
LOT Nº 7
CITY OF ELYRIA, COUNTY OF LORAIN
STATE OF OHIO

2.85 Diff from Plat

Rev.
8-3-83 DE
12-10-82 K.V.S.
6-1-81 DE
1-22-80 DE

Drawn by: K.V.S.
Checked by:
App. by:
Scale: 1" = 100'
Date: OCTOBER, 1979

Prepared for: HAROLD TERNES

KLEINOEDER · SCHMIDT and ASSOCIATES
ENGINEERS — SURVEYORS — CONSULTANTS in LAND PLANNING
ELYRIA - NORWALK - MEDINA OHIO

REFERENCES

SHEET NO. 1 of 1

JOB NO. 72-97