DUPLICATE

SURVEY IN ORIGINAL LOTS 109-110
E OF E BRANCH OF BLACK RIVER
ELYRIA LORAIN CO OHIO

March 30 1922 Scale 1"=30'

Warden & Laundon Engrs.
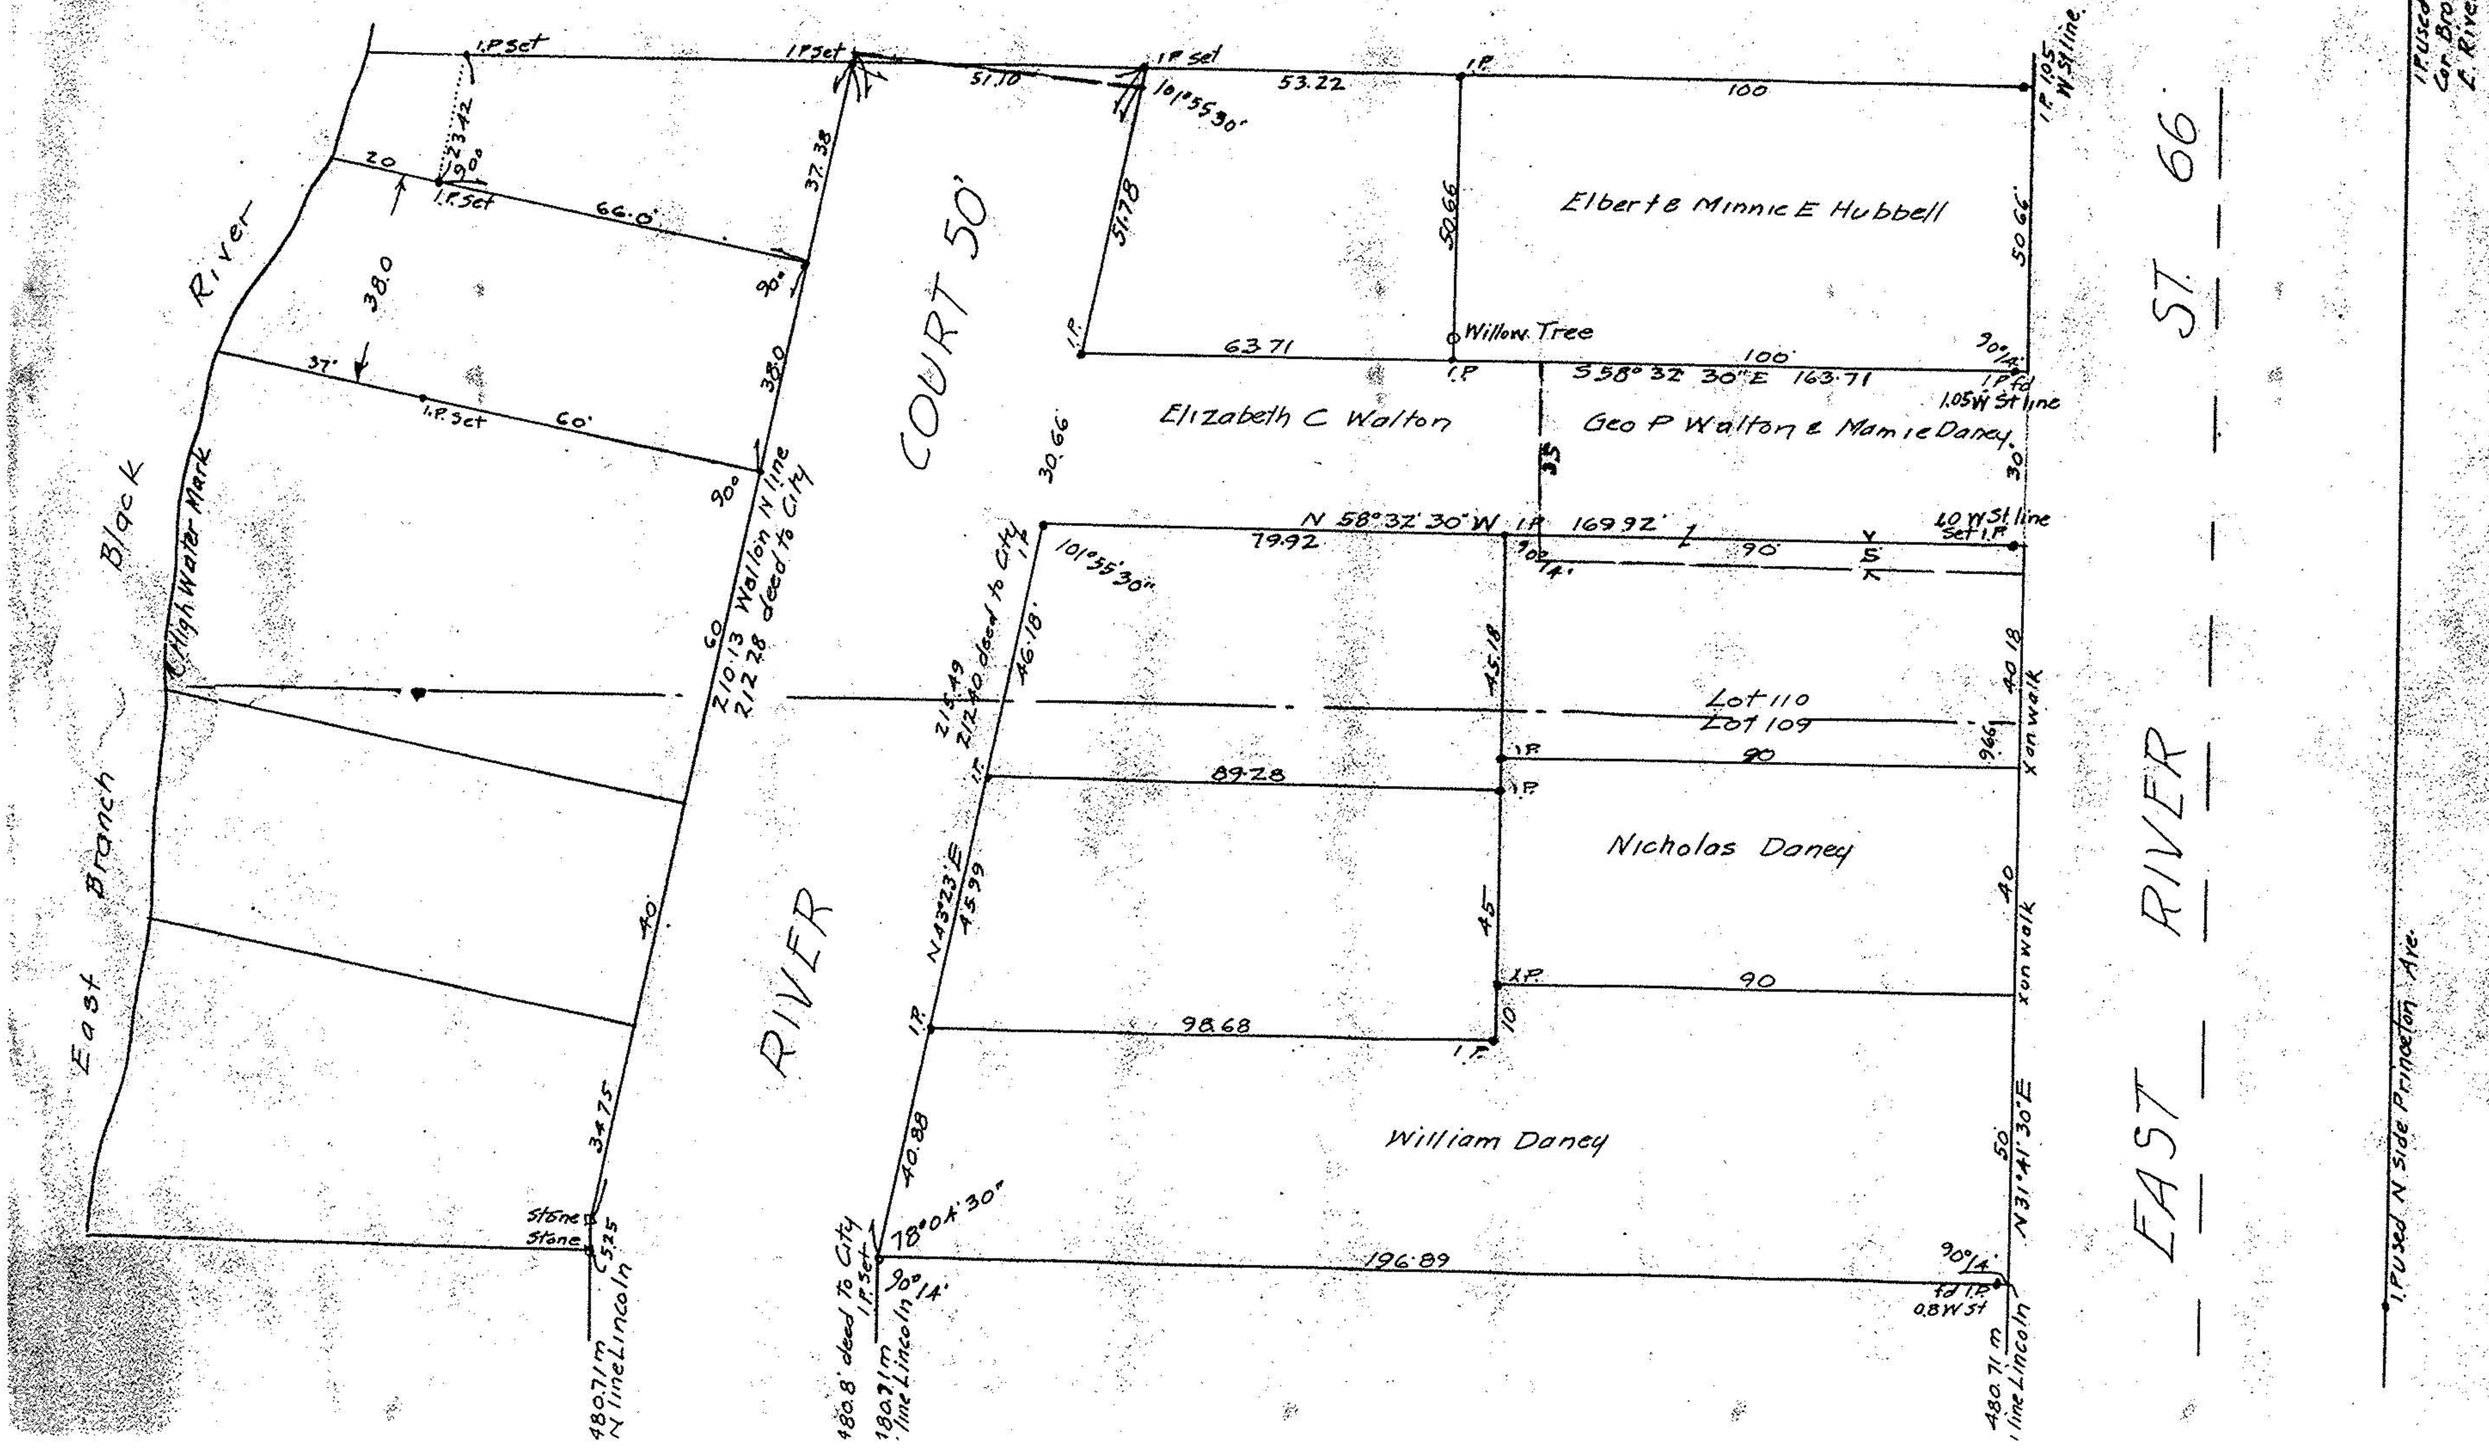
Note This tracing made from a B.P. loaned us by Henry J. Neipfoot - 5/20-24.
O. F. Palmer T.M.D.