


003

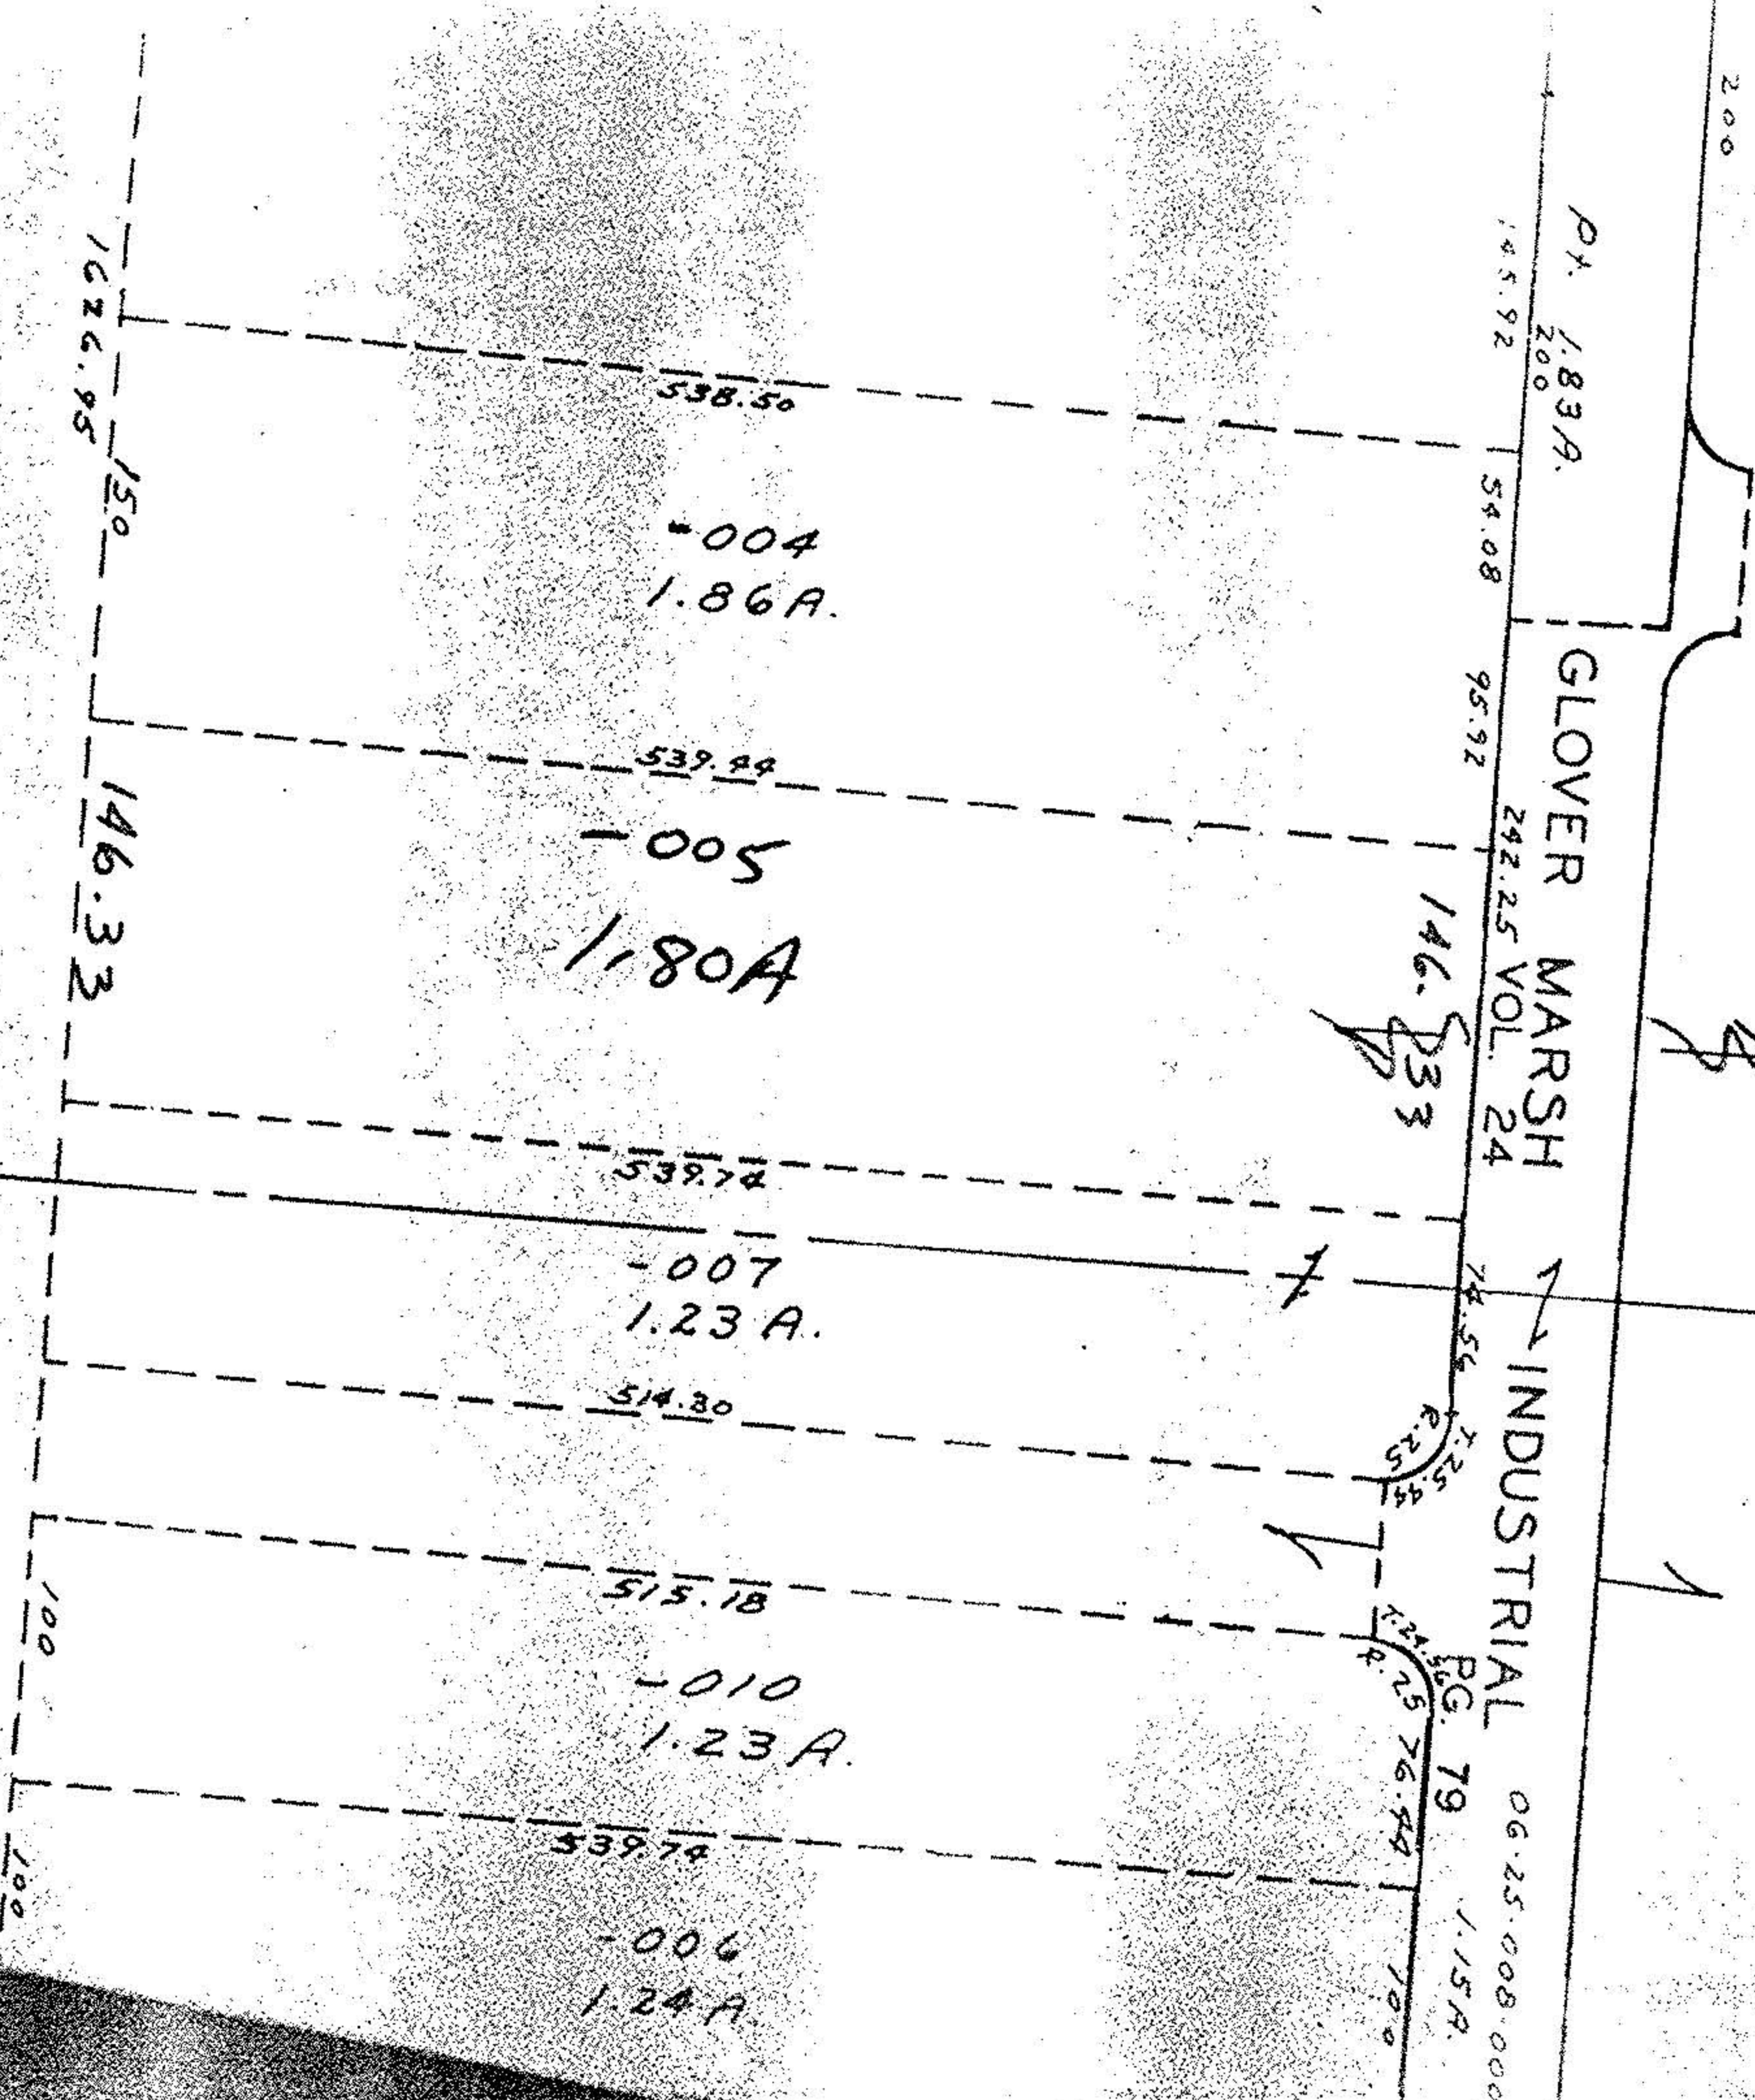

6-25-010-102-019
4.1.07A.

