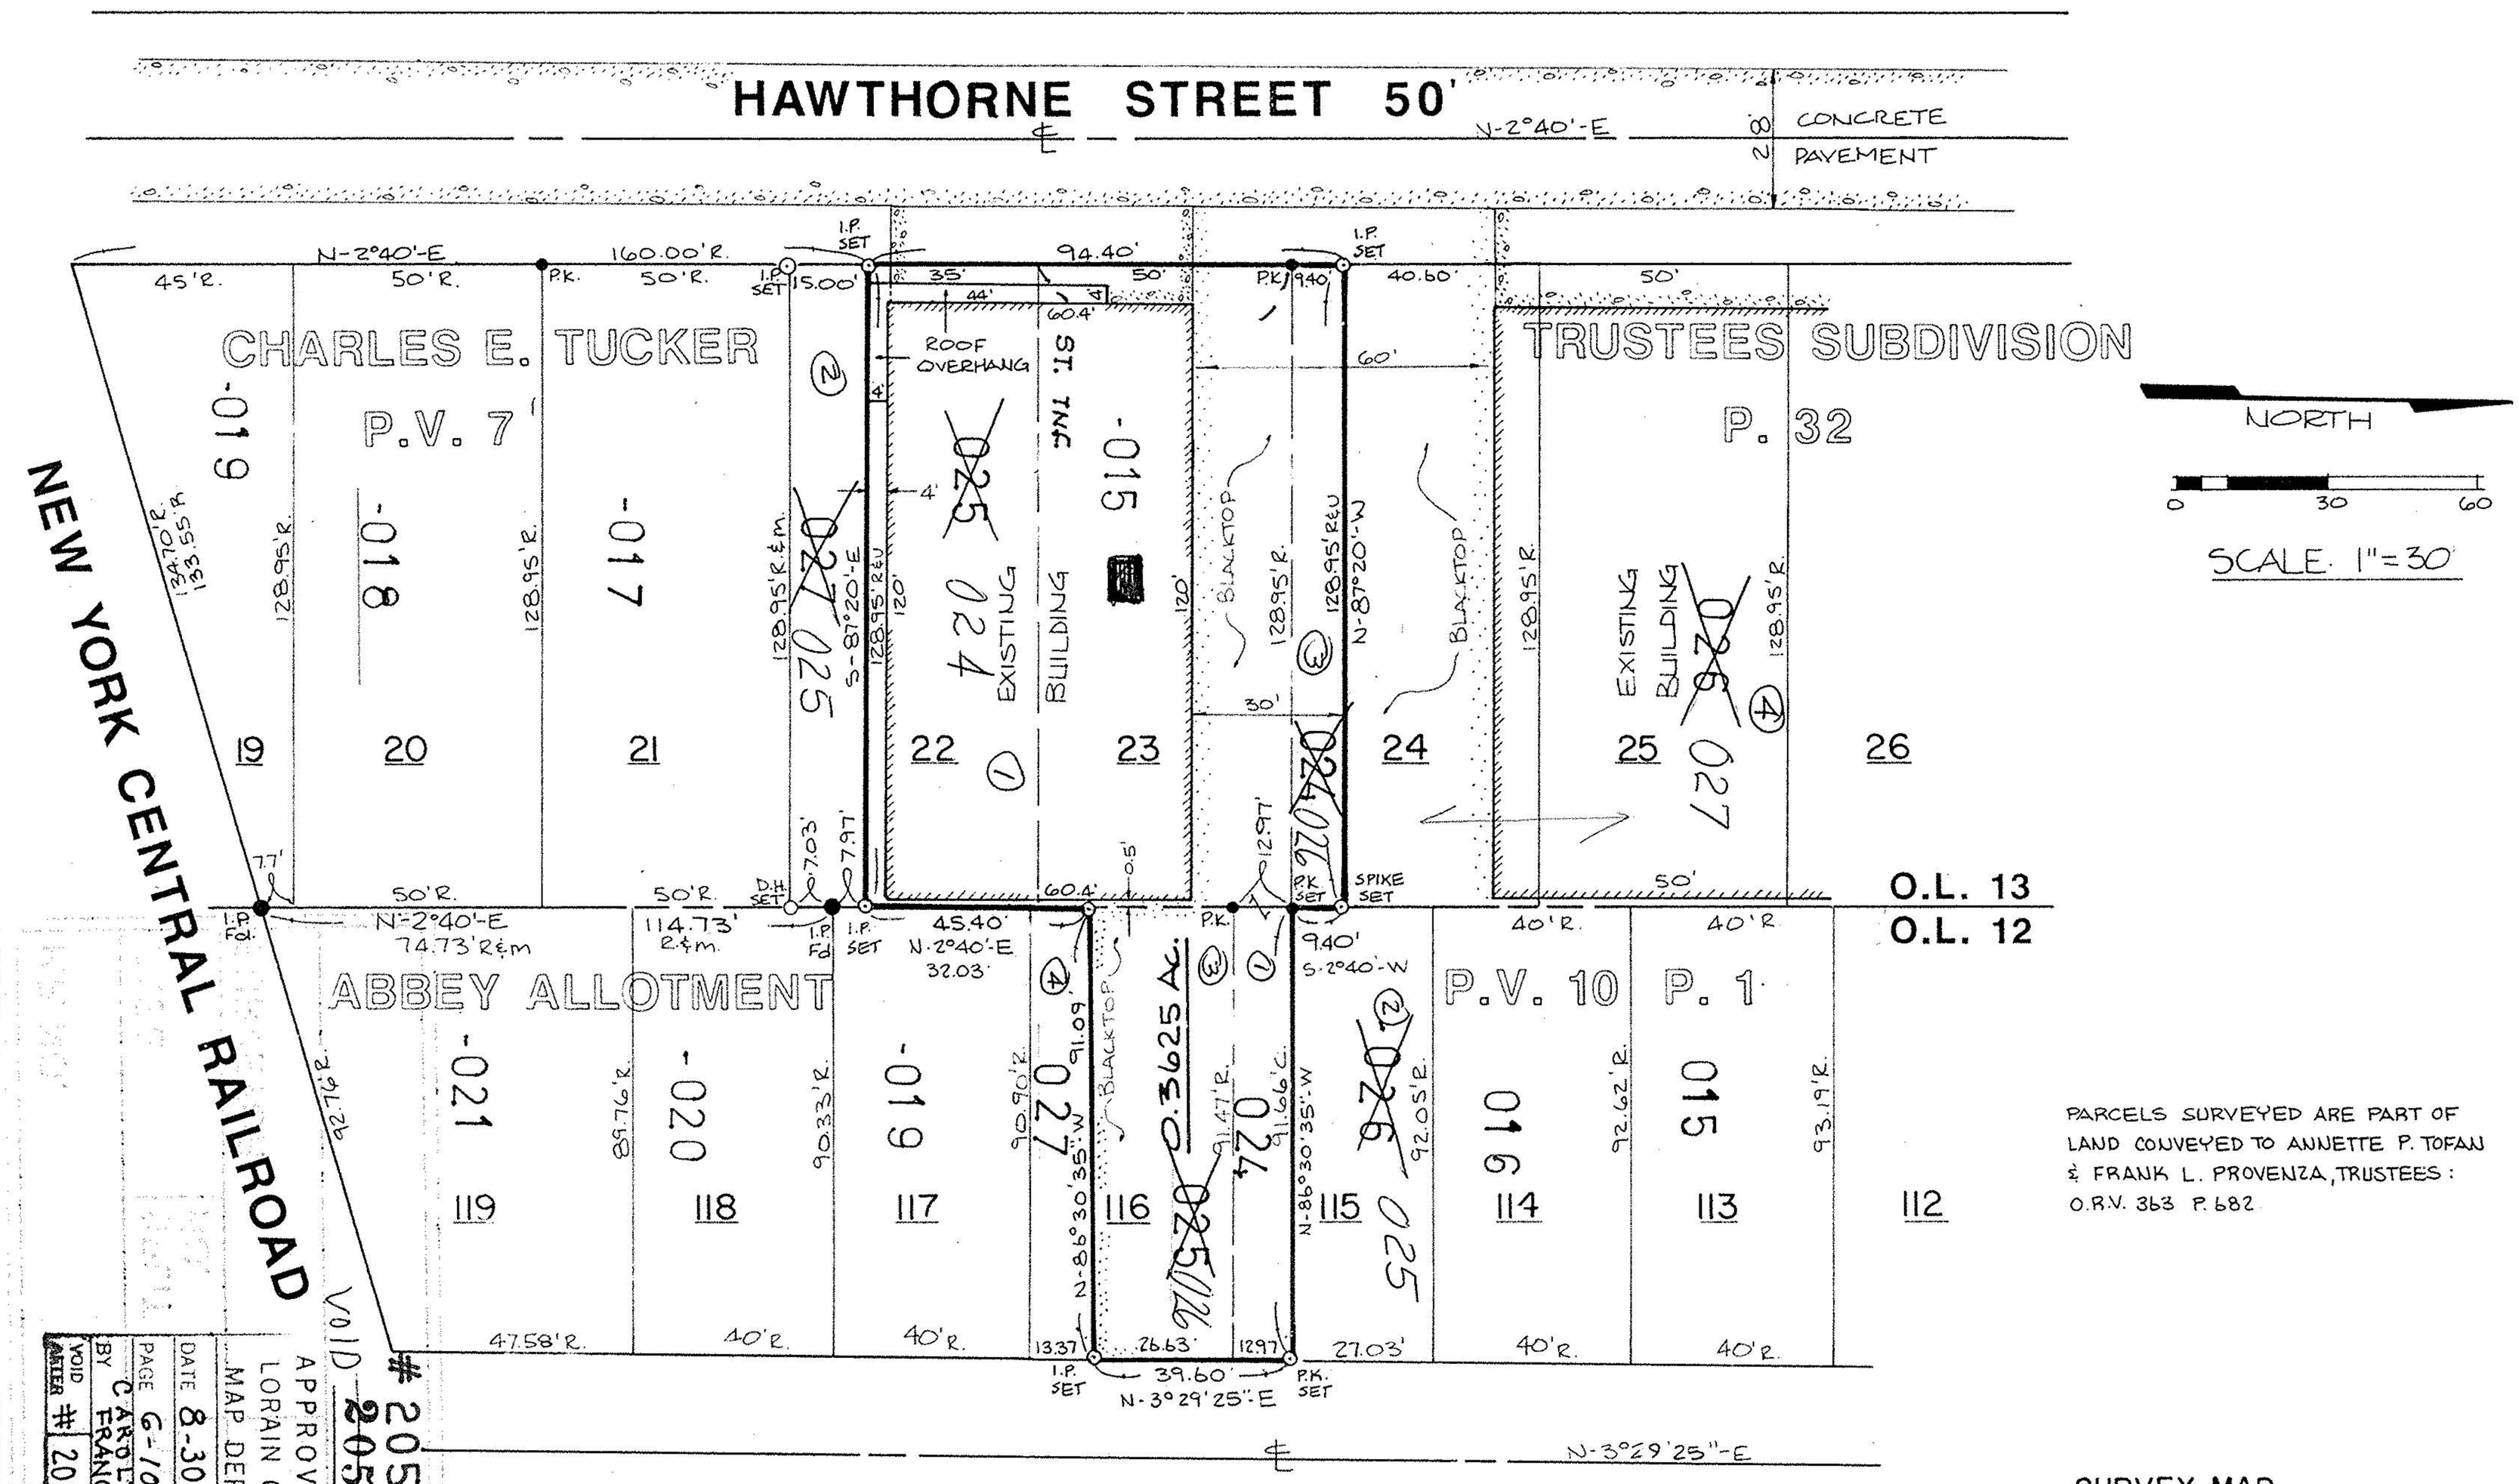

PARCELS SURVEYED ARE PART OF LAND CONVEYED TO ANNETTE P. TOFAN & FRANK L. PROVENZA, TRUSTEES: O.R.V. 363 P. 682

SURVEY MAP

PARTS OF ORIGINAL ELYRIA TOWNSHIP LOTS 12 & 13
EAST OF BLACK RIVER
CITY OF ELYRIA COUNTY OF LORAIN
STATE OF OHIO

JOB No. 92-341