



**KLEINDEDER-SCHMIDT**  
and ASSOCIATES

ENGINEERS — SURVEYORS — CONSULTANTS IN LAND PLANNING  
ELYRIA · NORWALK · MEDINA  
OHIO

**SURVEY**

Sublot(s) 13, 14, 16

Subd'n MEADOWBROOK ALLOT.  
P.V. & P.27

Tract E. OF BLACK RIVER

Sec. State of Ohio

Township ELYRIA


Orig. Lot(s) 16

County of LORAIN

Corporation CITY OF ELYRIA

06-25-016-101-

G-104

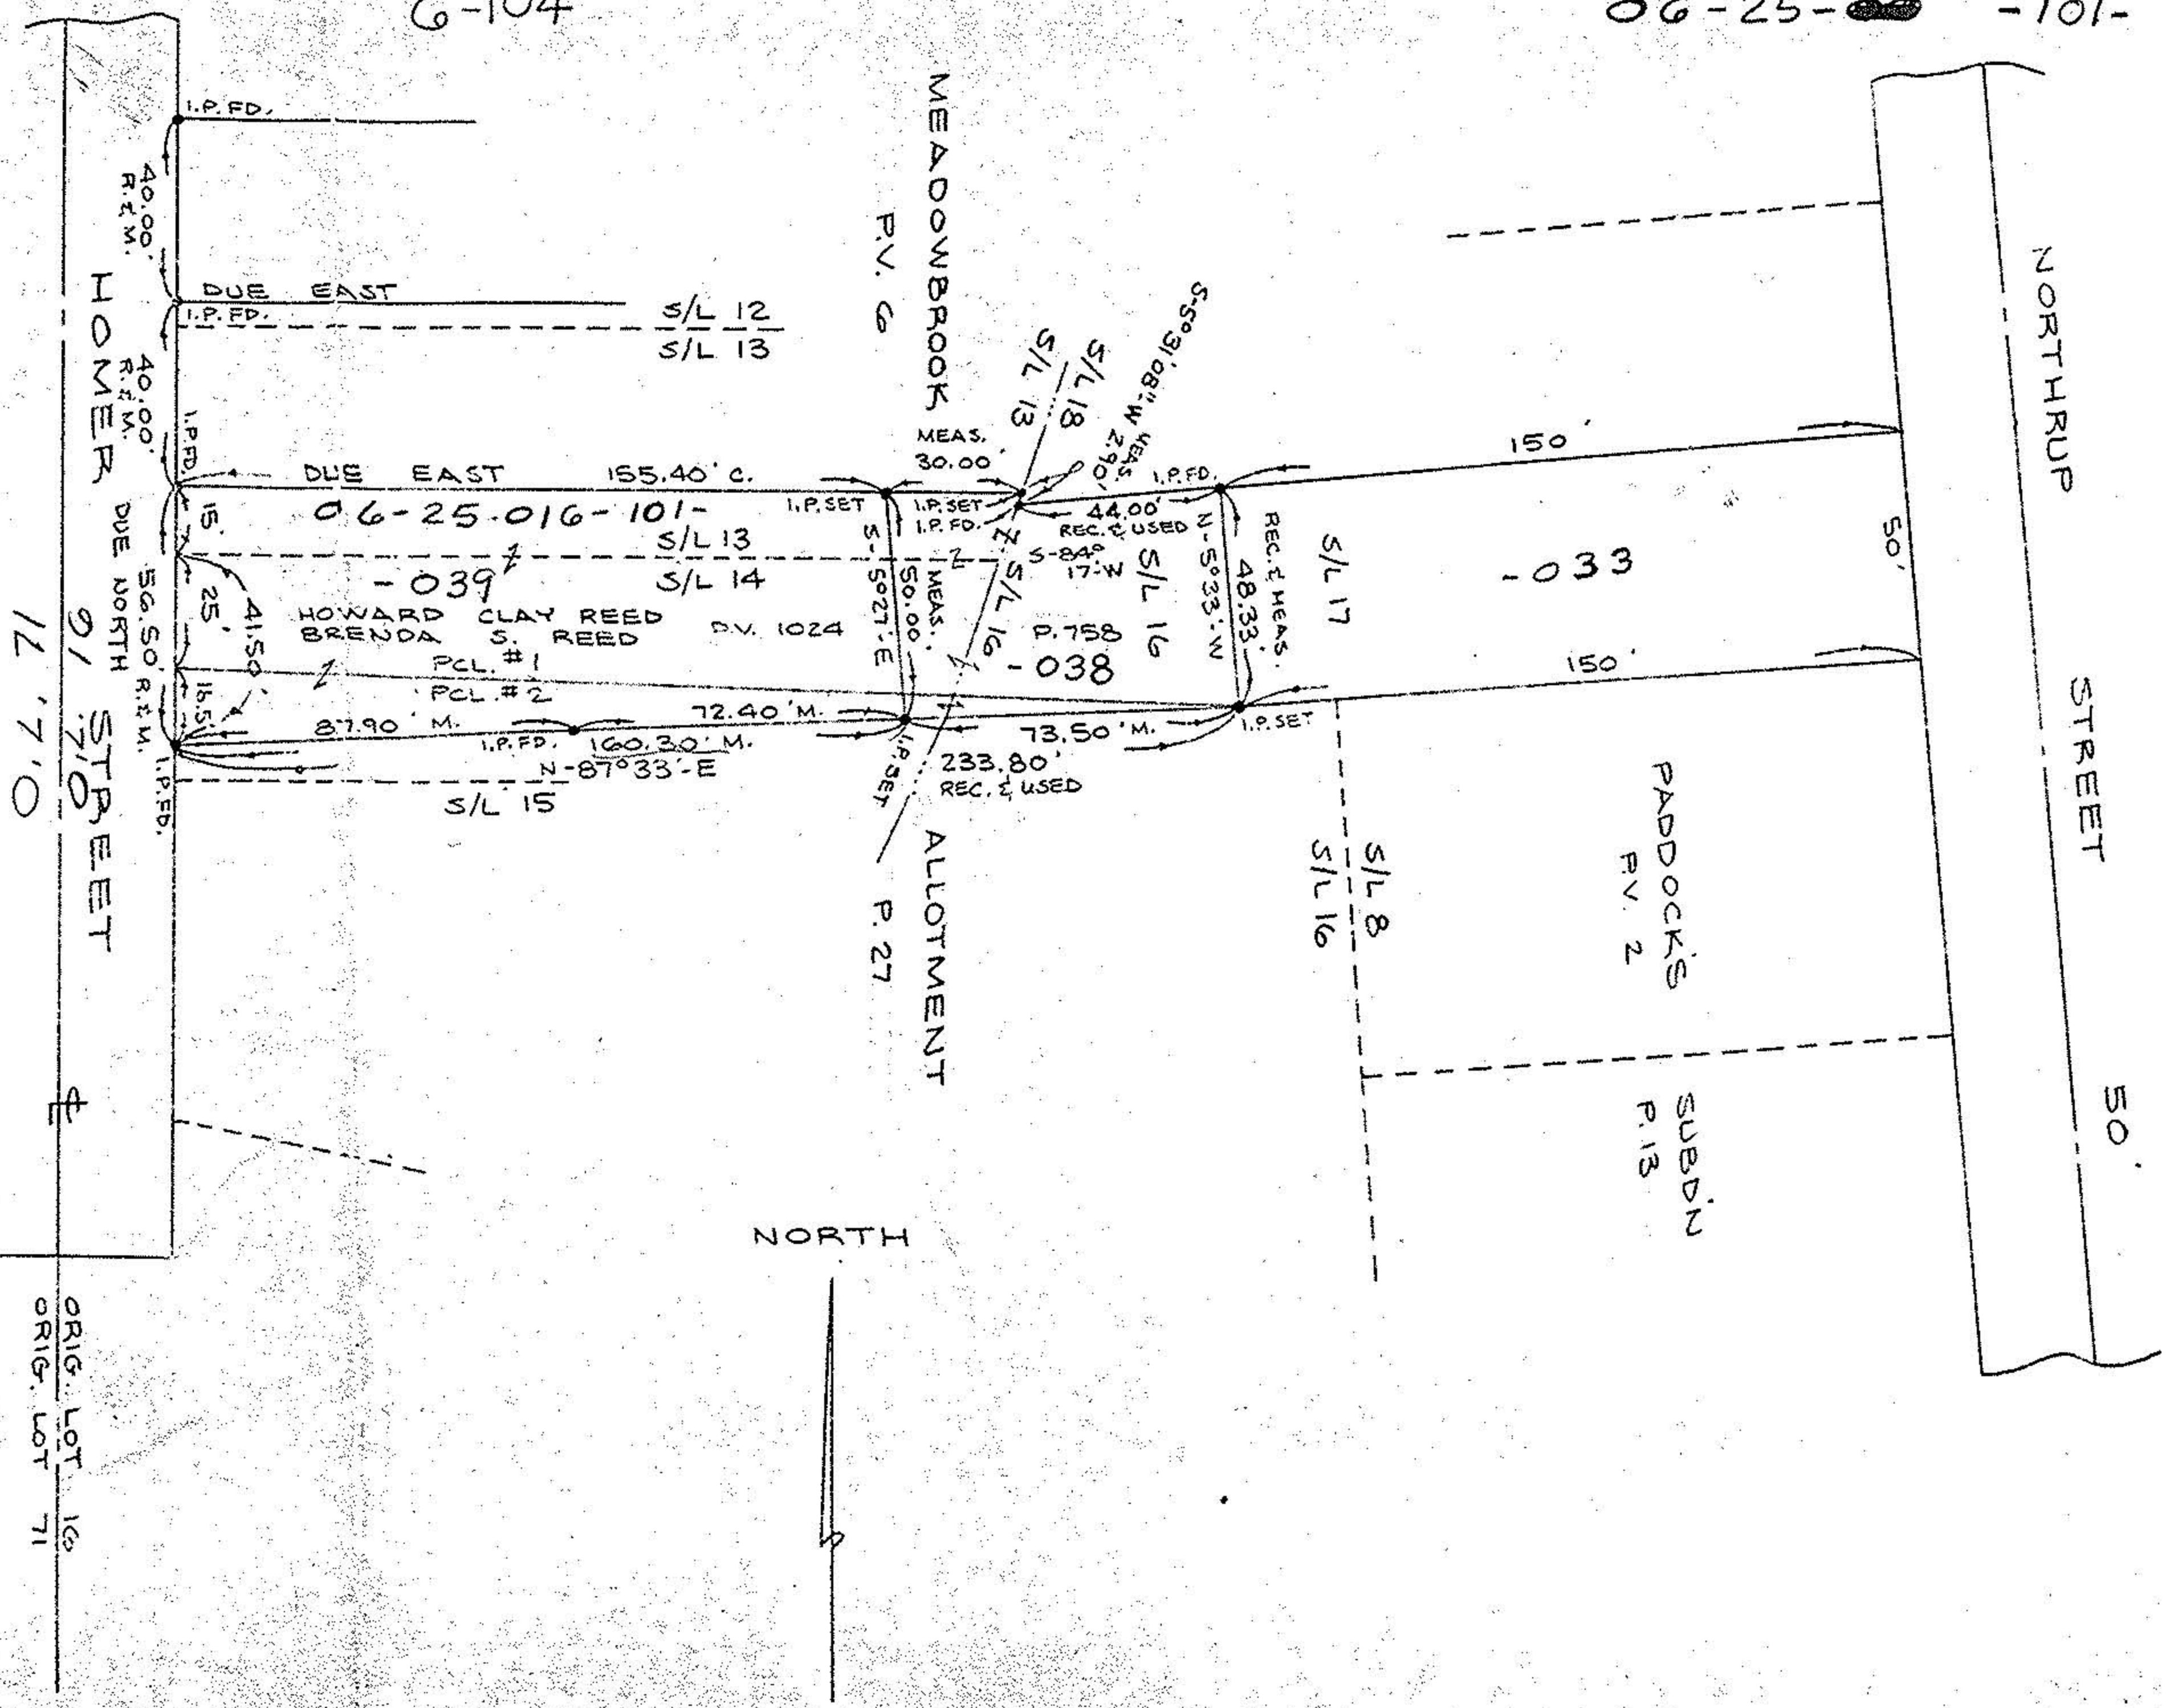

Prepared for: LES DRAGE ELYRIA, OHIO

Scale: 1" = 100'

Date: 6-20-74

Dr. by: RS

Job No: 74-174

REV. 7-3-74

ORIG. LOT 16  
ORIG. LOT 71