




*Carl R. Anderson*

PREPARED FOR: SCOTT EMERSON  
541 E. BROAD ST.  
ELYRIA, OHIO 44035

PREPARED BY: CARL R. ANDERSON P.S.  
866 SALEM AVENUE  
ELYRIA, OHIO 44035  
TELE: (216) 365-8104

SURVEY P.P. 06-25-016-114-002  
CITY OF ELYRIA - COUNTY OF LORAIN  
STATE OF OHIO - ORIGINAL LOT 16  
EAST OF THE EAST BRANCH OF THE BLACK RIVER

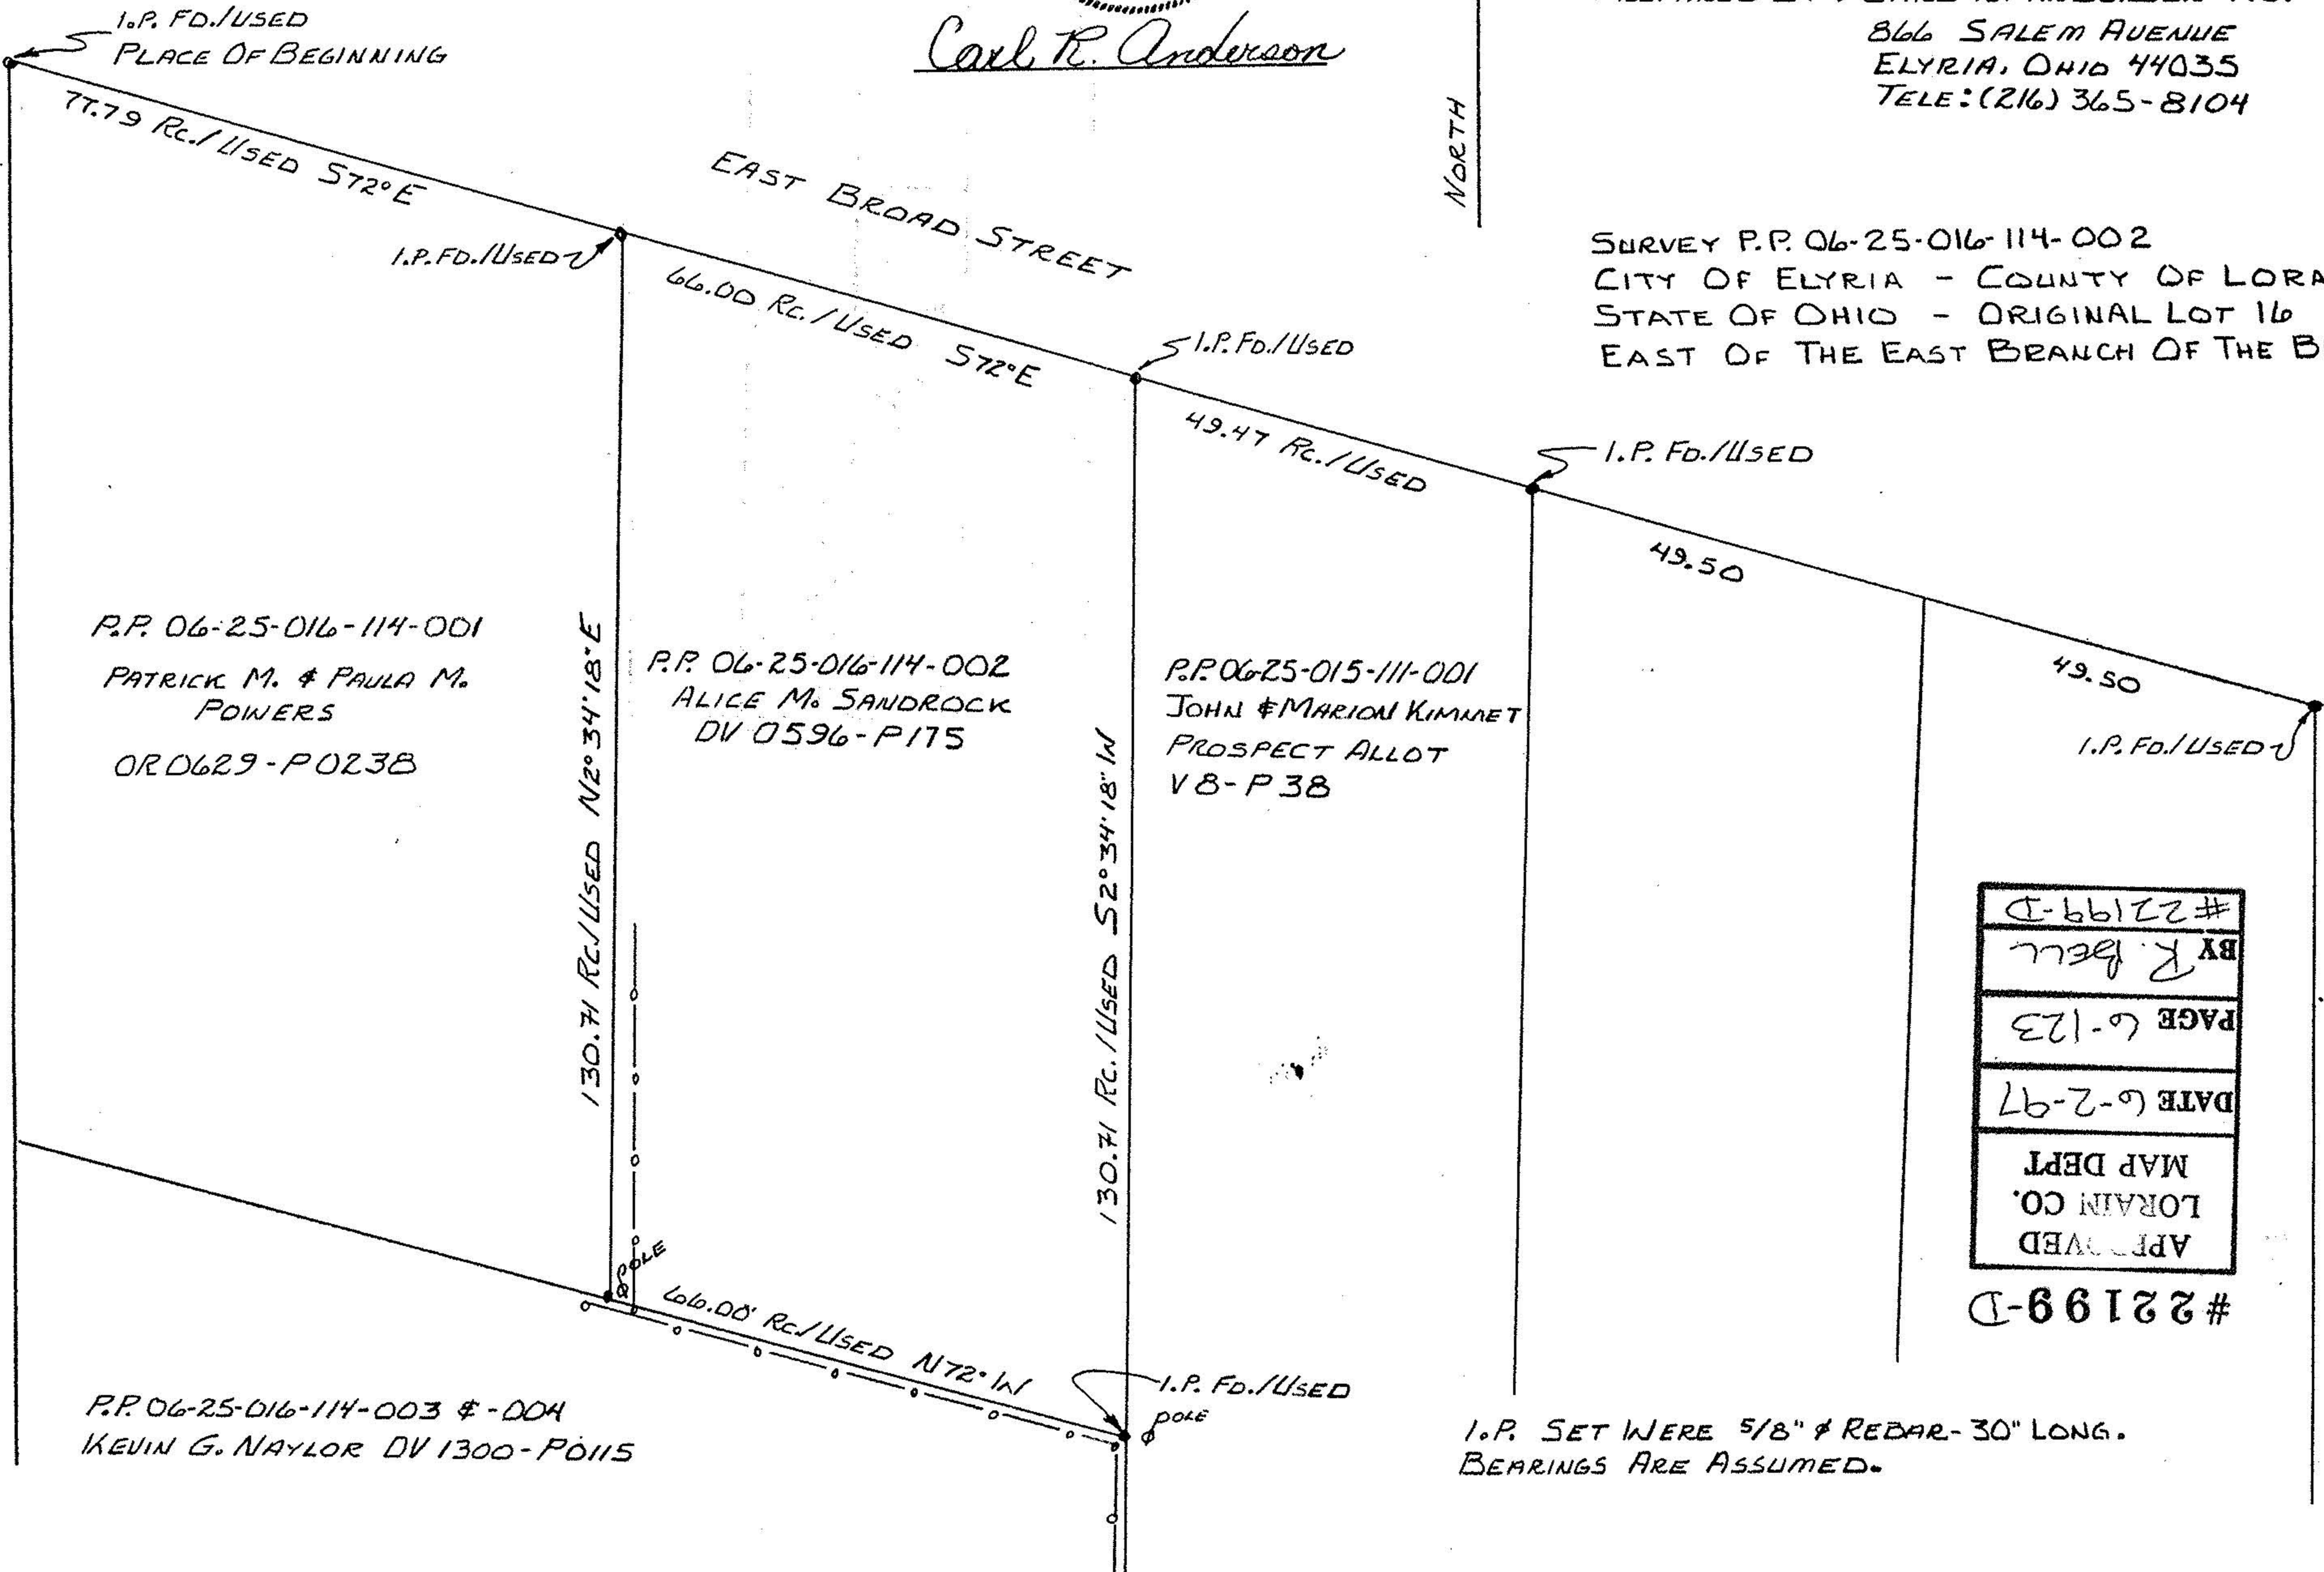

P.P. 06-25-016-114-001  
PATRICK M. & PAULA M.  
POINERS  
ORD 629-P0238

P.P. 06-25-016-114-002  
ALICE M. SANDROCK  
DV 0596-P175

P.P. 06-25-015-111-001  
JOHN & MARION KIMMET  
PROSPECT ALLOT  
V8-P38

P.P. 06-25-016-114-003 & -004  
KEVIN G. NAYLOR DV 1300-P0115

# 22199-D  
APPROVED  
LORAIN CO.  
MAP DEPT.  
DATE 6-2-97  
PAGE 6-123  
BY R. Bell  
# 22199-D

I.P. SET WERE 5/8"  $\phi$  REBAR-30" LONG.  
BEARINGS ARE ASSUMED.

WINCKLE

FAIRLAWN