LAUNDON • SIMON • CAHL & ASSOC., INC.
CONSULTING ENGINEERS & SURVEYORS
110 MIDDLE AVE., ELYRIA, O. 44035

SURVEY FOR
LAWRENCE F. SCHUBERT

Orig. Lot 28	City of ELYRIA	Date June 1994 Scale 1"=60'
Orig. Sec	Village of	Dwn. by RC Chkd. by RS
Tract EAST OF RIVER	County of LORAIN	Job No. 94-2584 F.B. 233-14
Township of ELYRIA	State of OHIO	Printed JUL 7 1994

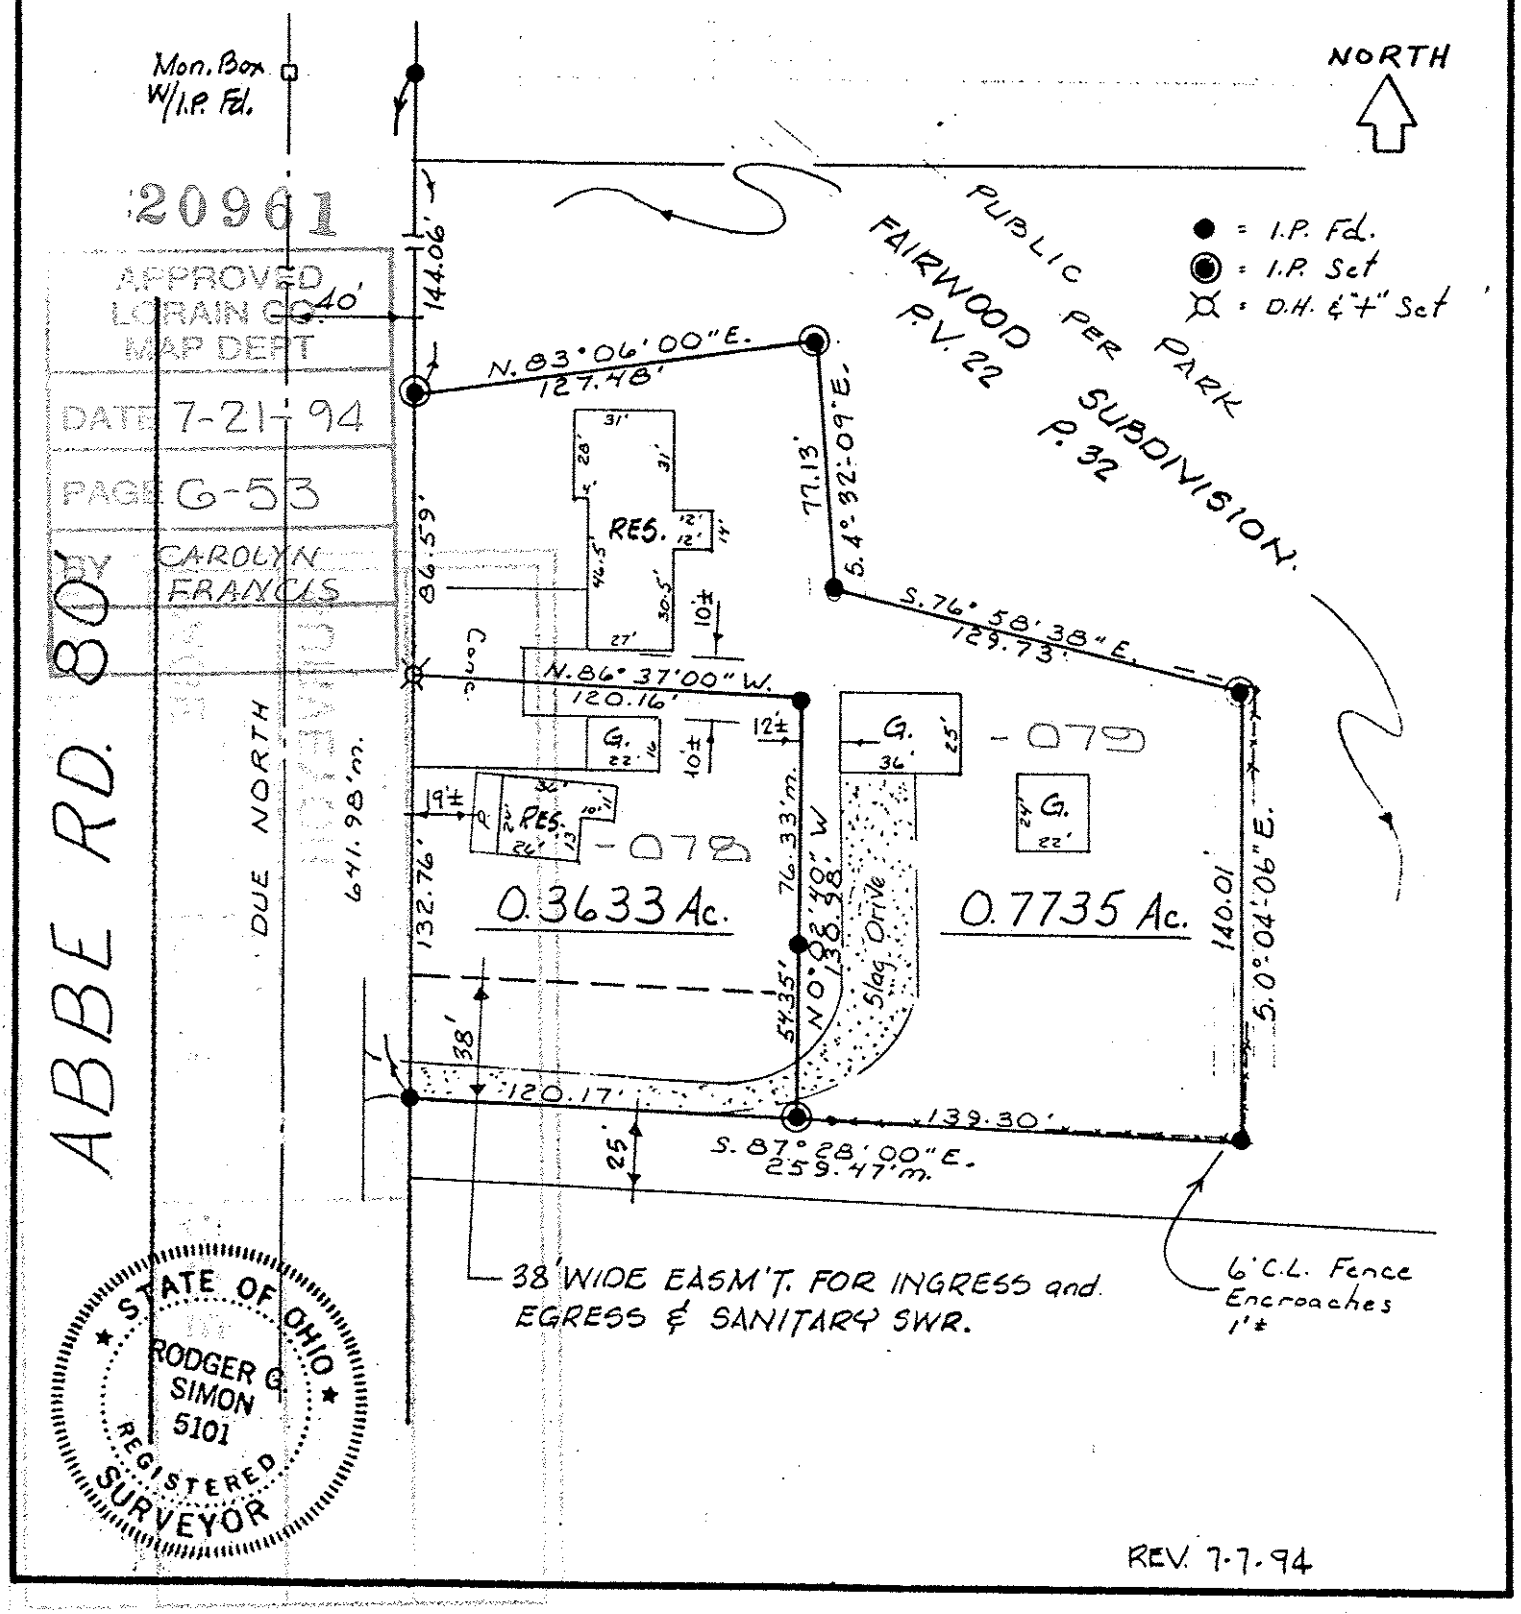

REV. 7-7-94