

21139

APPROVED
LORAIN CO.
MAP DEPT

DATE 11-29-94


PAGE 6-53

BY CAROLYN
FRANCIS

21189

City of Elyria
Public Park
P.V 23 Pg 18

Abbe Road

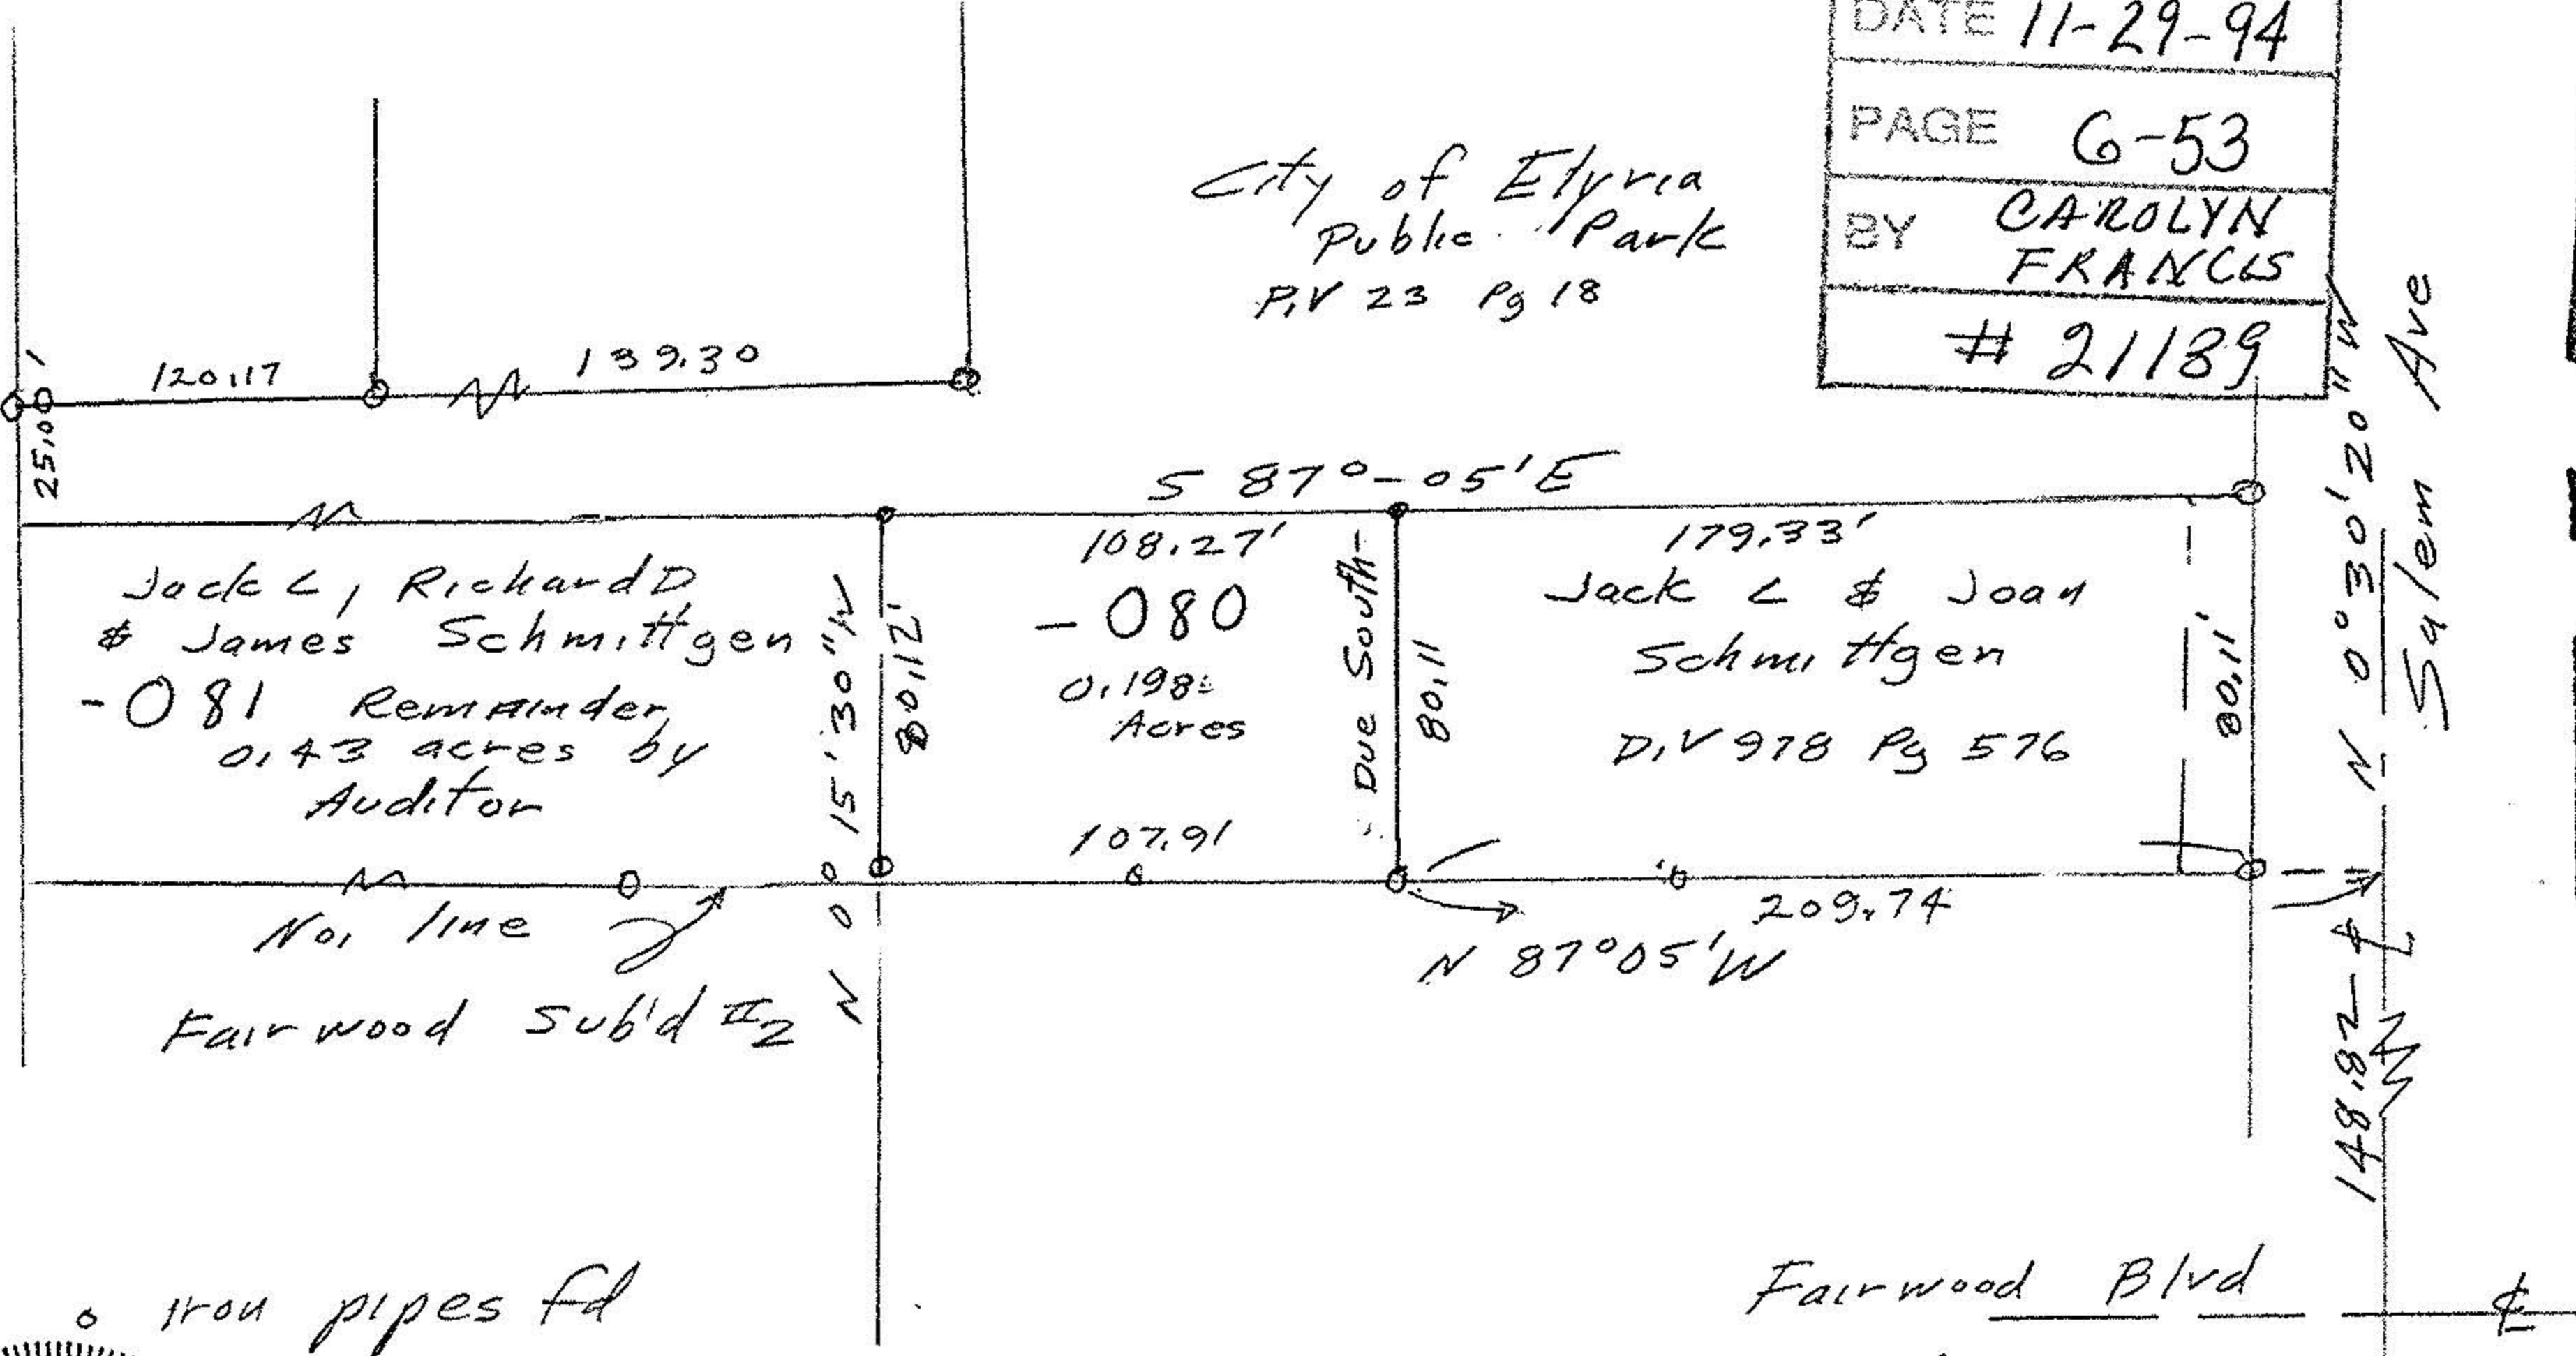

Jack L, Richard D
& James Schmittgen
- 081 Remainder
0.43 acres by
Auditor

108.27'
- 080
0.198
Acres

179.33'
Jack L & Joan
Schmittgen
D.V 978 Pg 576

No. line
Fairwood sub'd #2

Fairwood Blvd

N 89°

iron pipes fd
pipes set
Pozywak
Surveyor 5292

Survey of
Parcel Split for Richard Schmittgen
Original Elyria Township Lot 28
East of Black River
City of Elyria, Lorain County Ohio
Scale 1" = 60' Oct 8, 1994

