6-104

06-25-037-109-

#11339

6-104

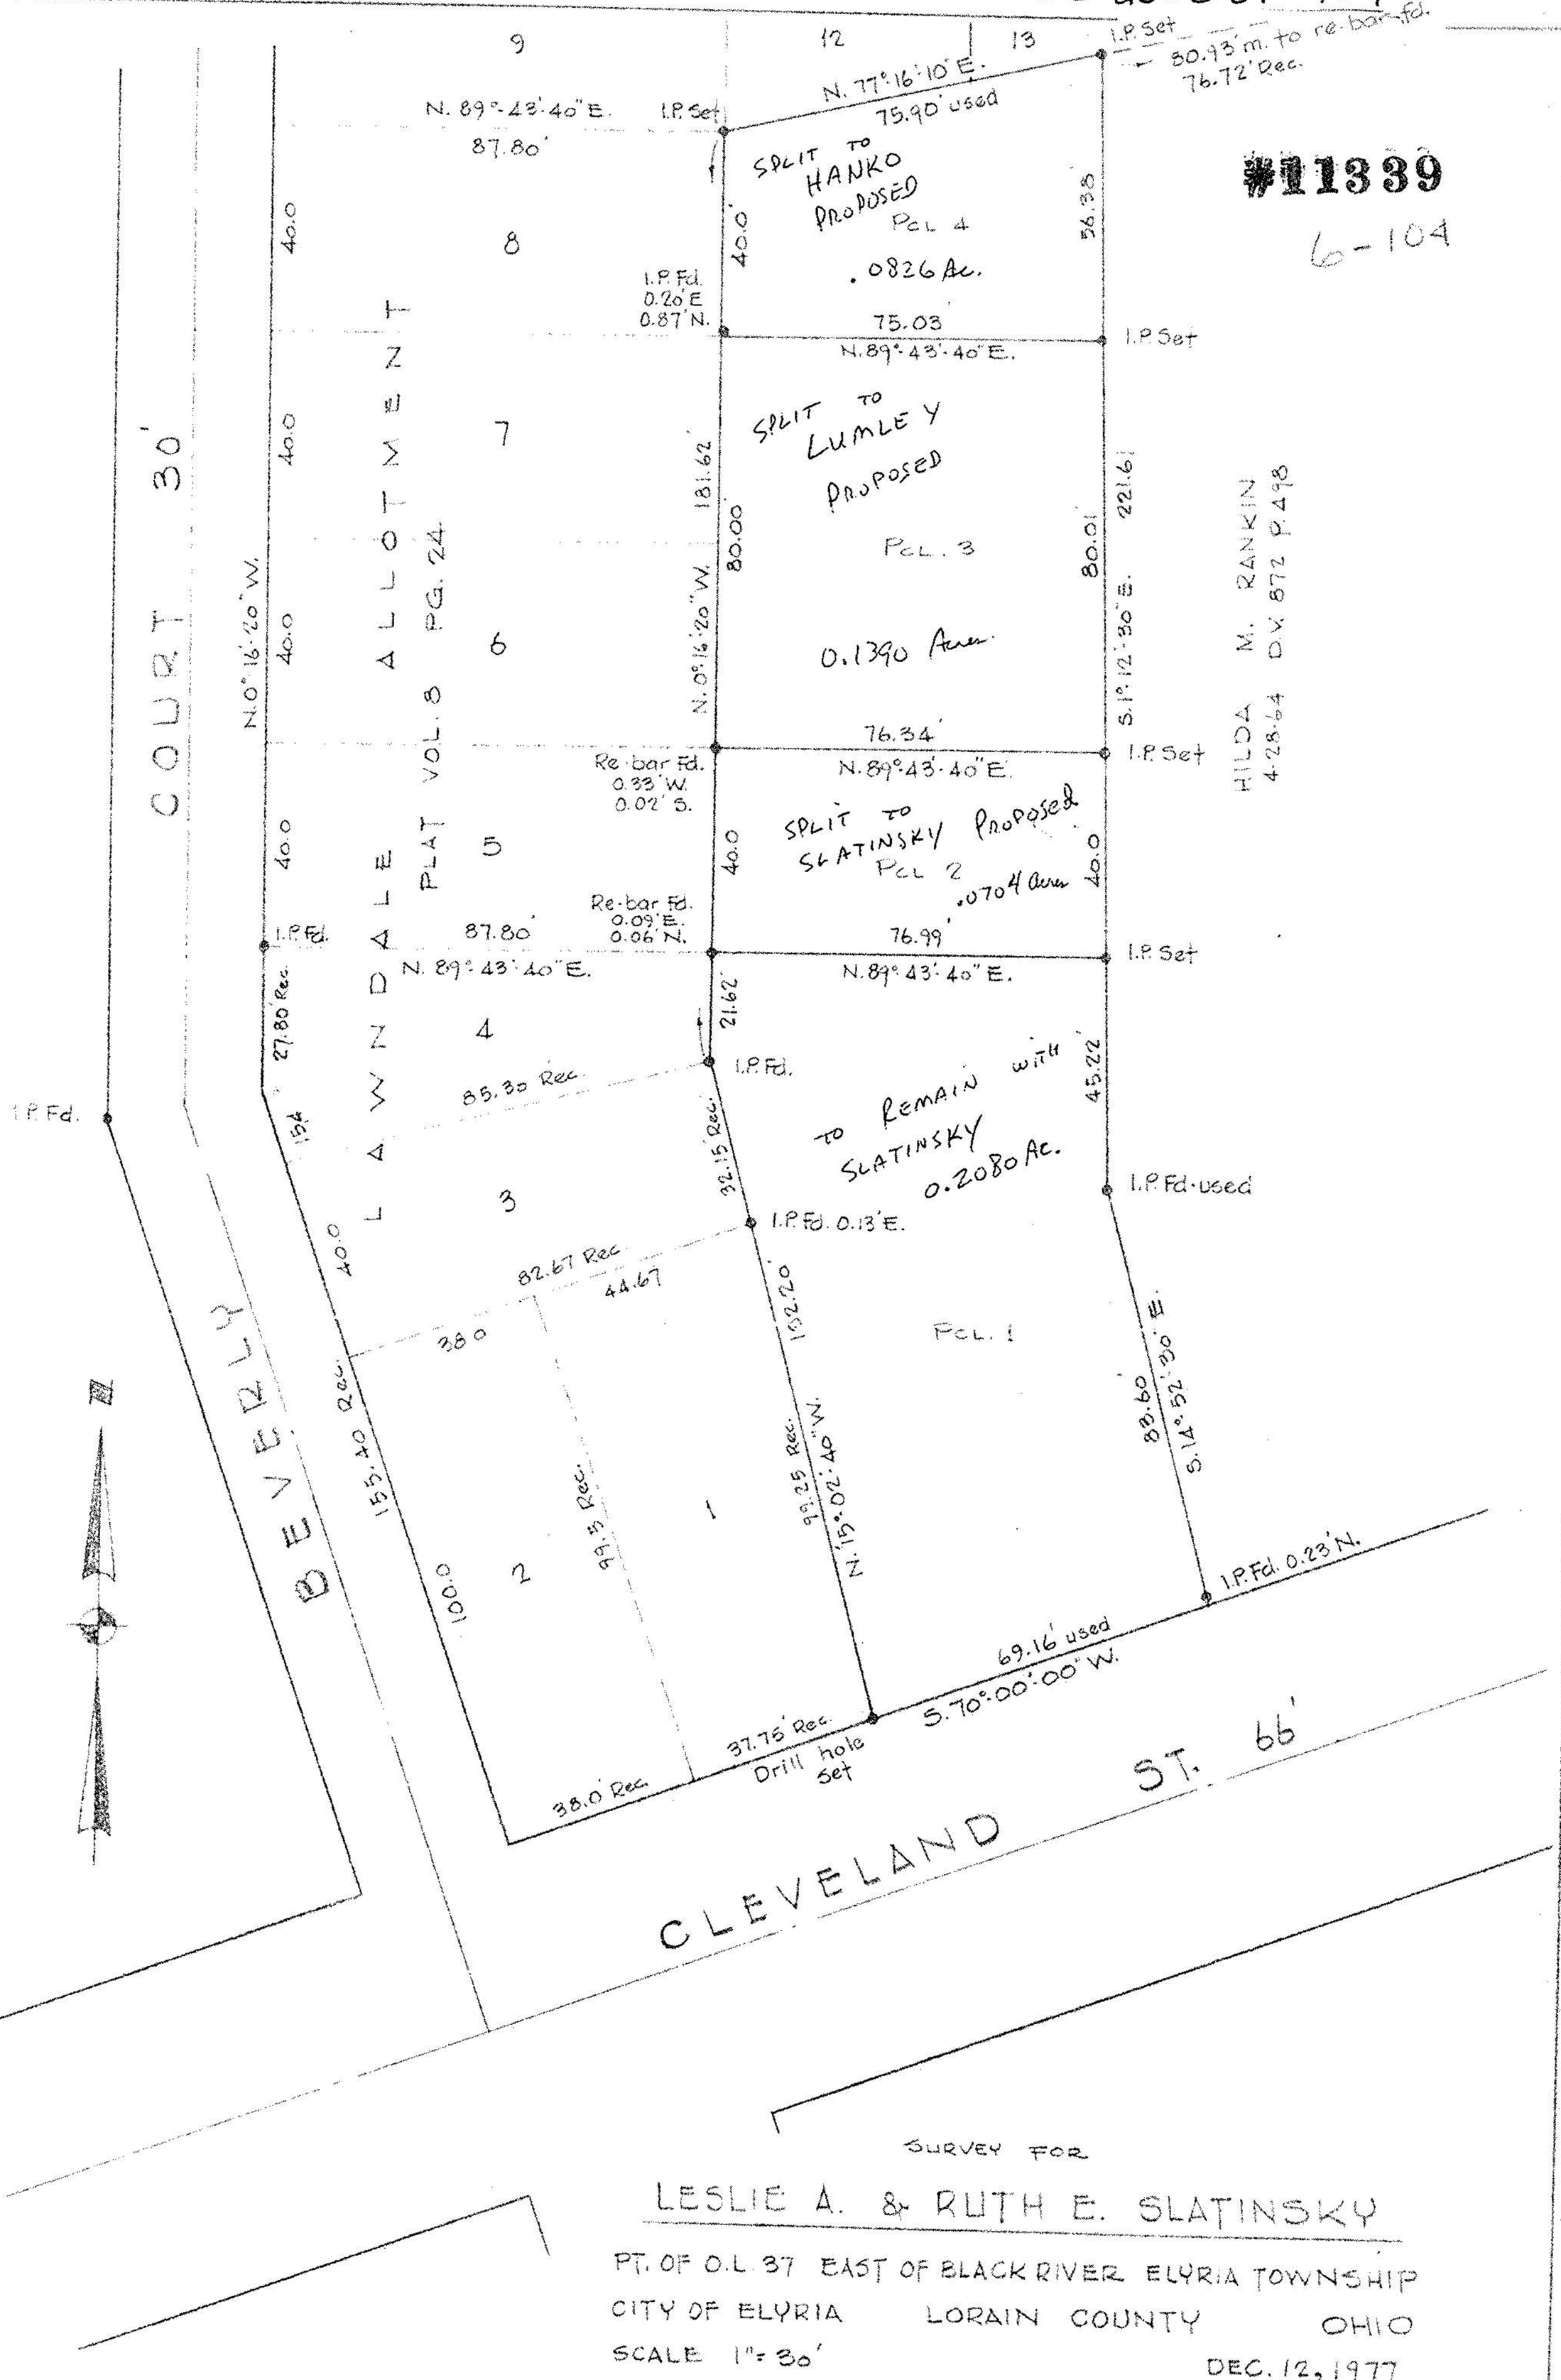

SURVEY FOR

LESLIE A. & RUTH E. SLATINSKY

PT. OF O.L. 37 EAST OF BLACK RIVER ELYRIA TOWNSHIP

CITY OF ELYRIA LORAIN COUNTY OHIO

SCALE 1" = 30' DEC. 12, 1977

LAUNDON • SIMON • CAHL & ASSOC.

ENGINEERS SURVEYORS

77-690 FB. 103-68

DEC 12 1977

6-104

(35) East of Black River

6-104 06-25-037-109