

PLAT OF J. E. GRAY'S ADDITION TO THE CITY OF ELYRIA, O.



Received April 20, 1898

6-103


6-104

06-25-067-103 -
06-25-068-102 -



6-121

6-122

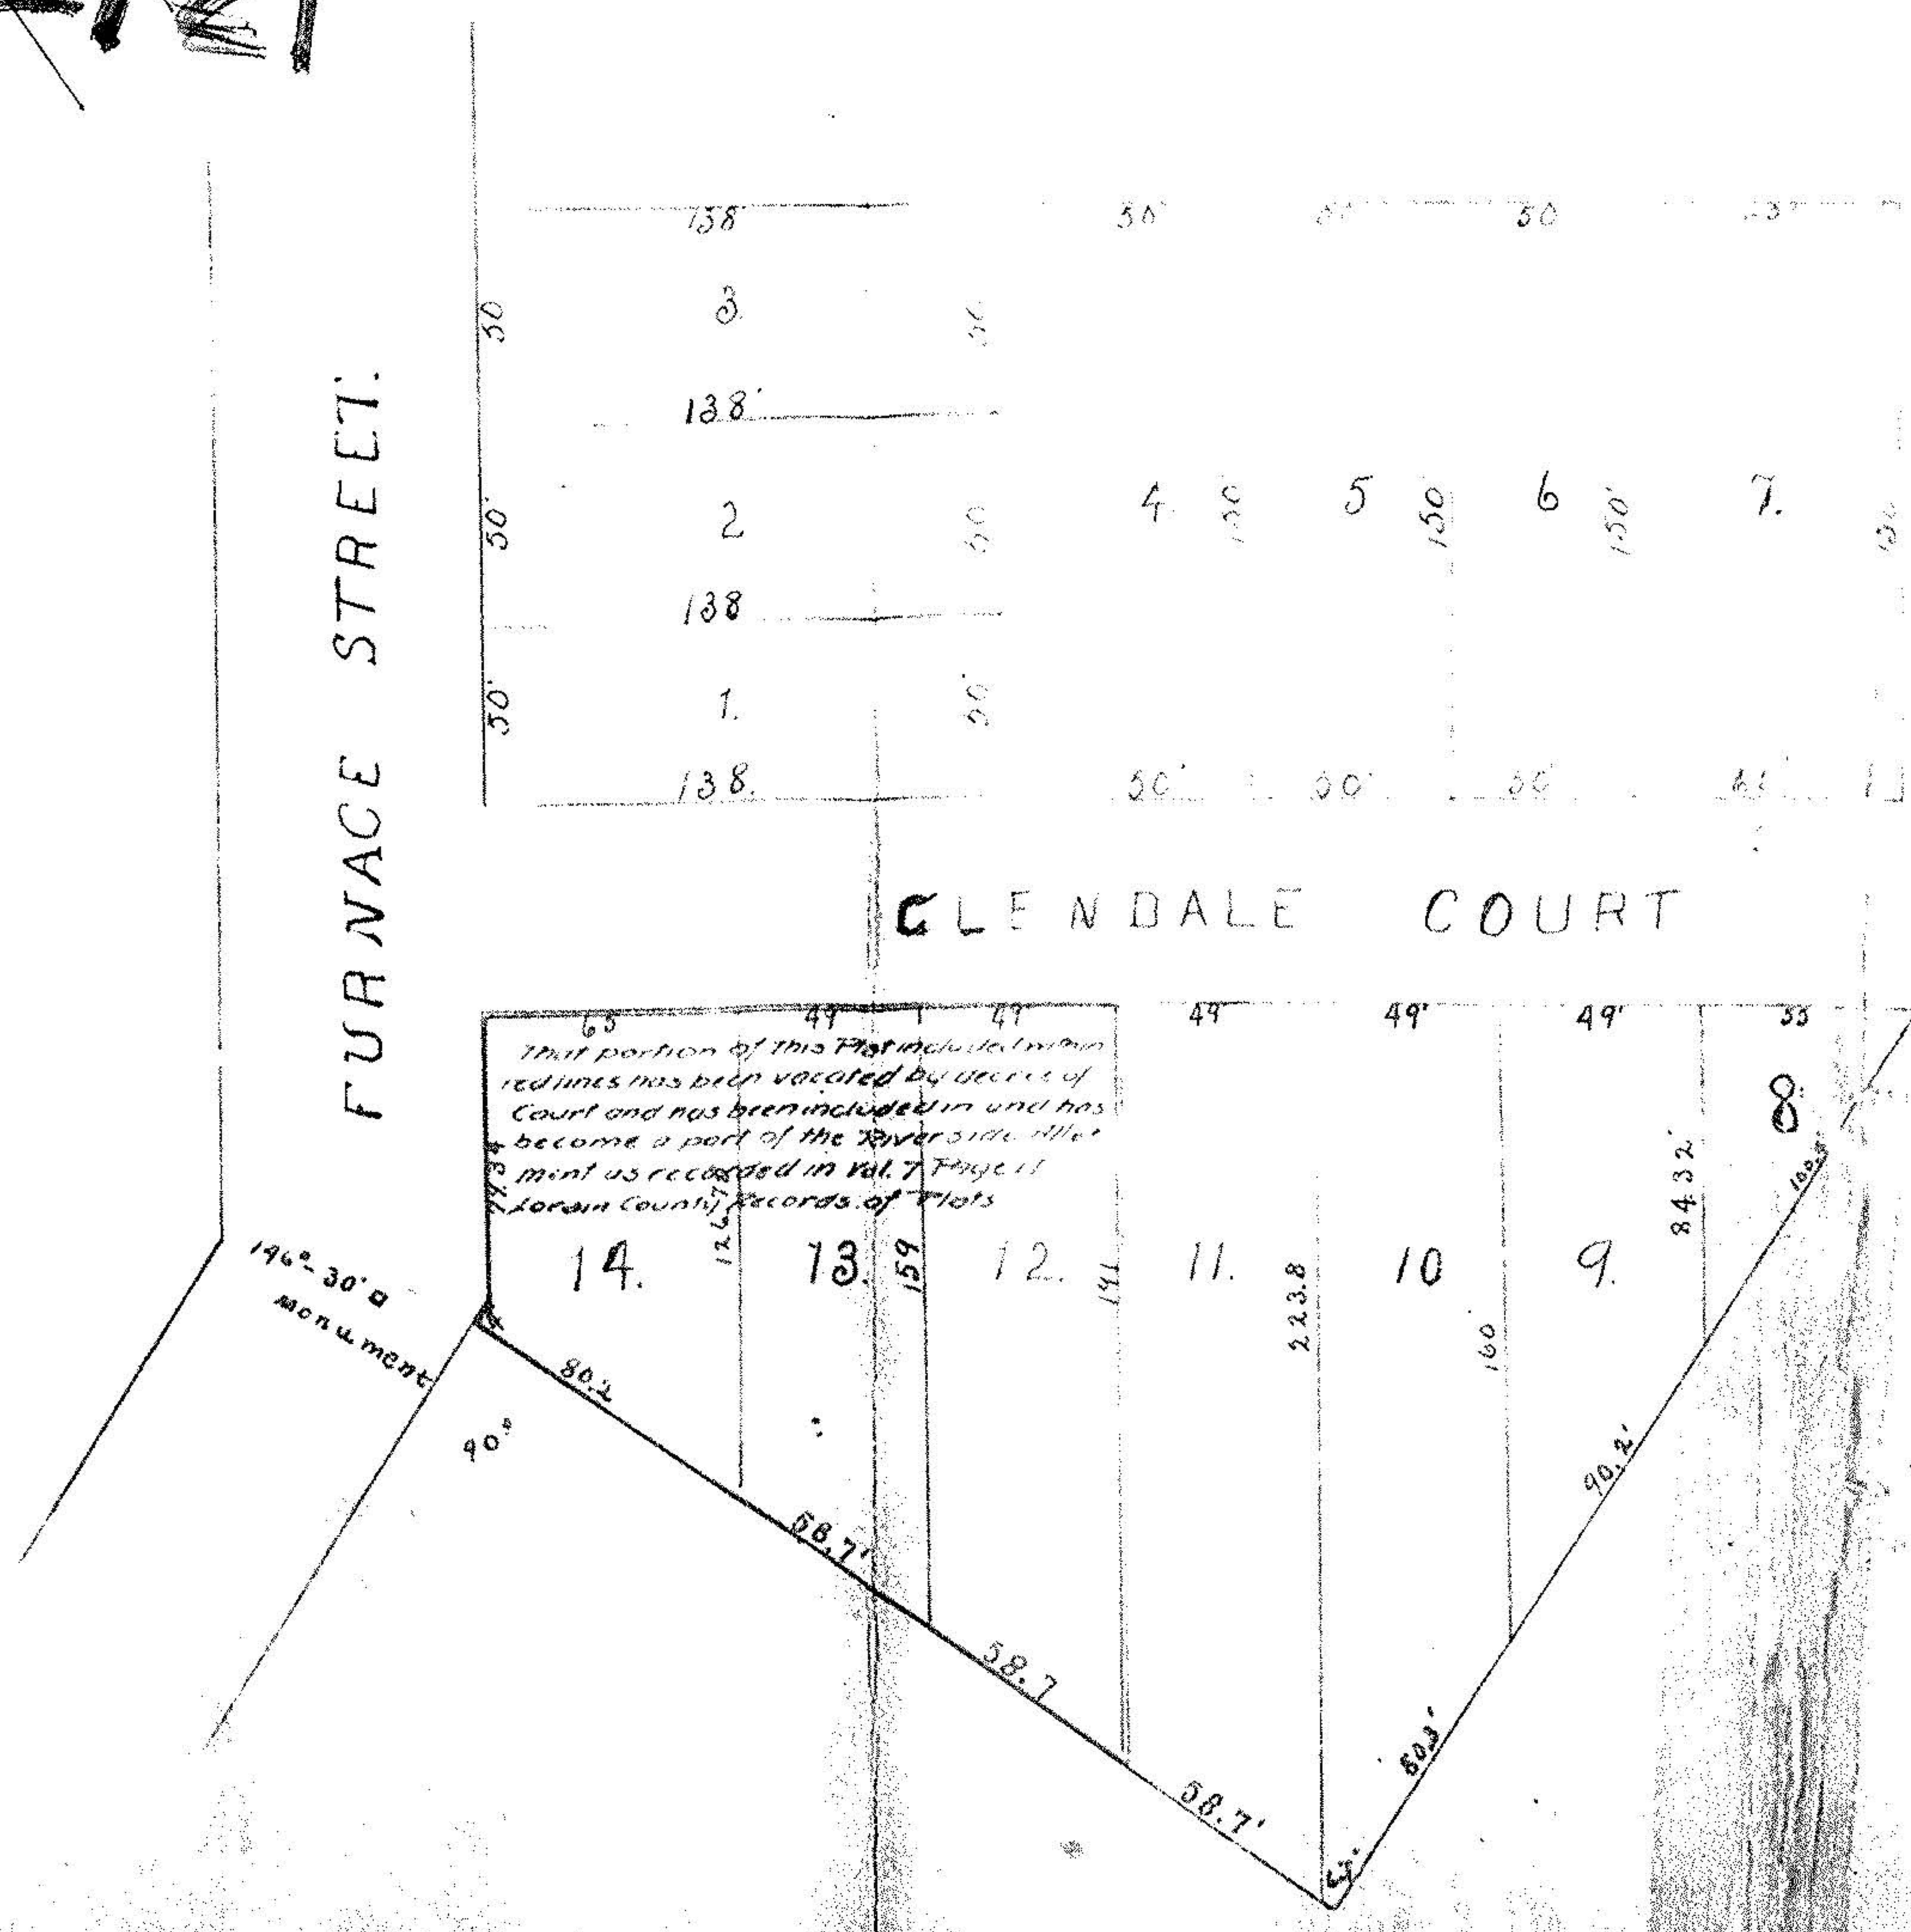


