


023 East Black River Elyria Top  
06-25-085

6-139

Frank & Lena DeFazio D. Vol. 203 Pg. 422  
Robert J. & Marjorie J. Gardner D. Vol. 913 Pg. 613

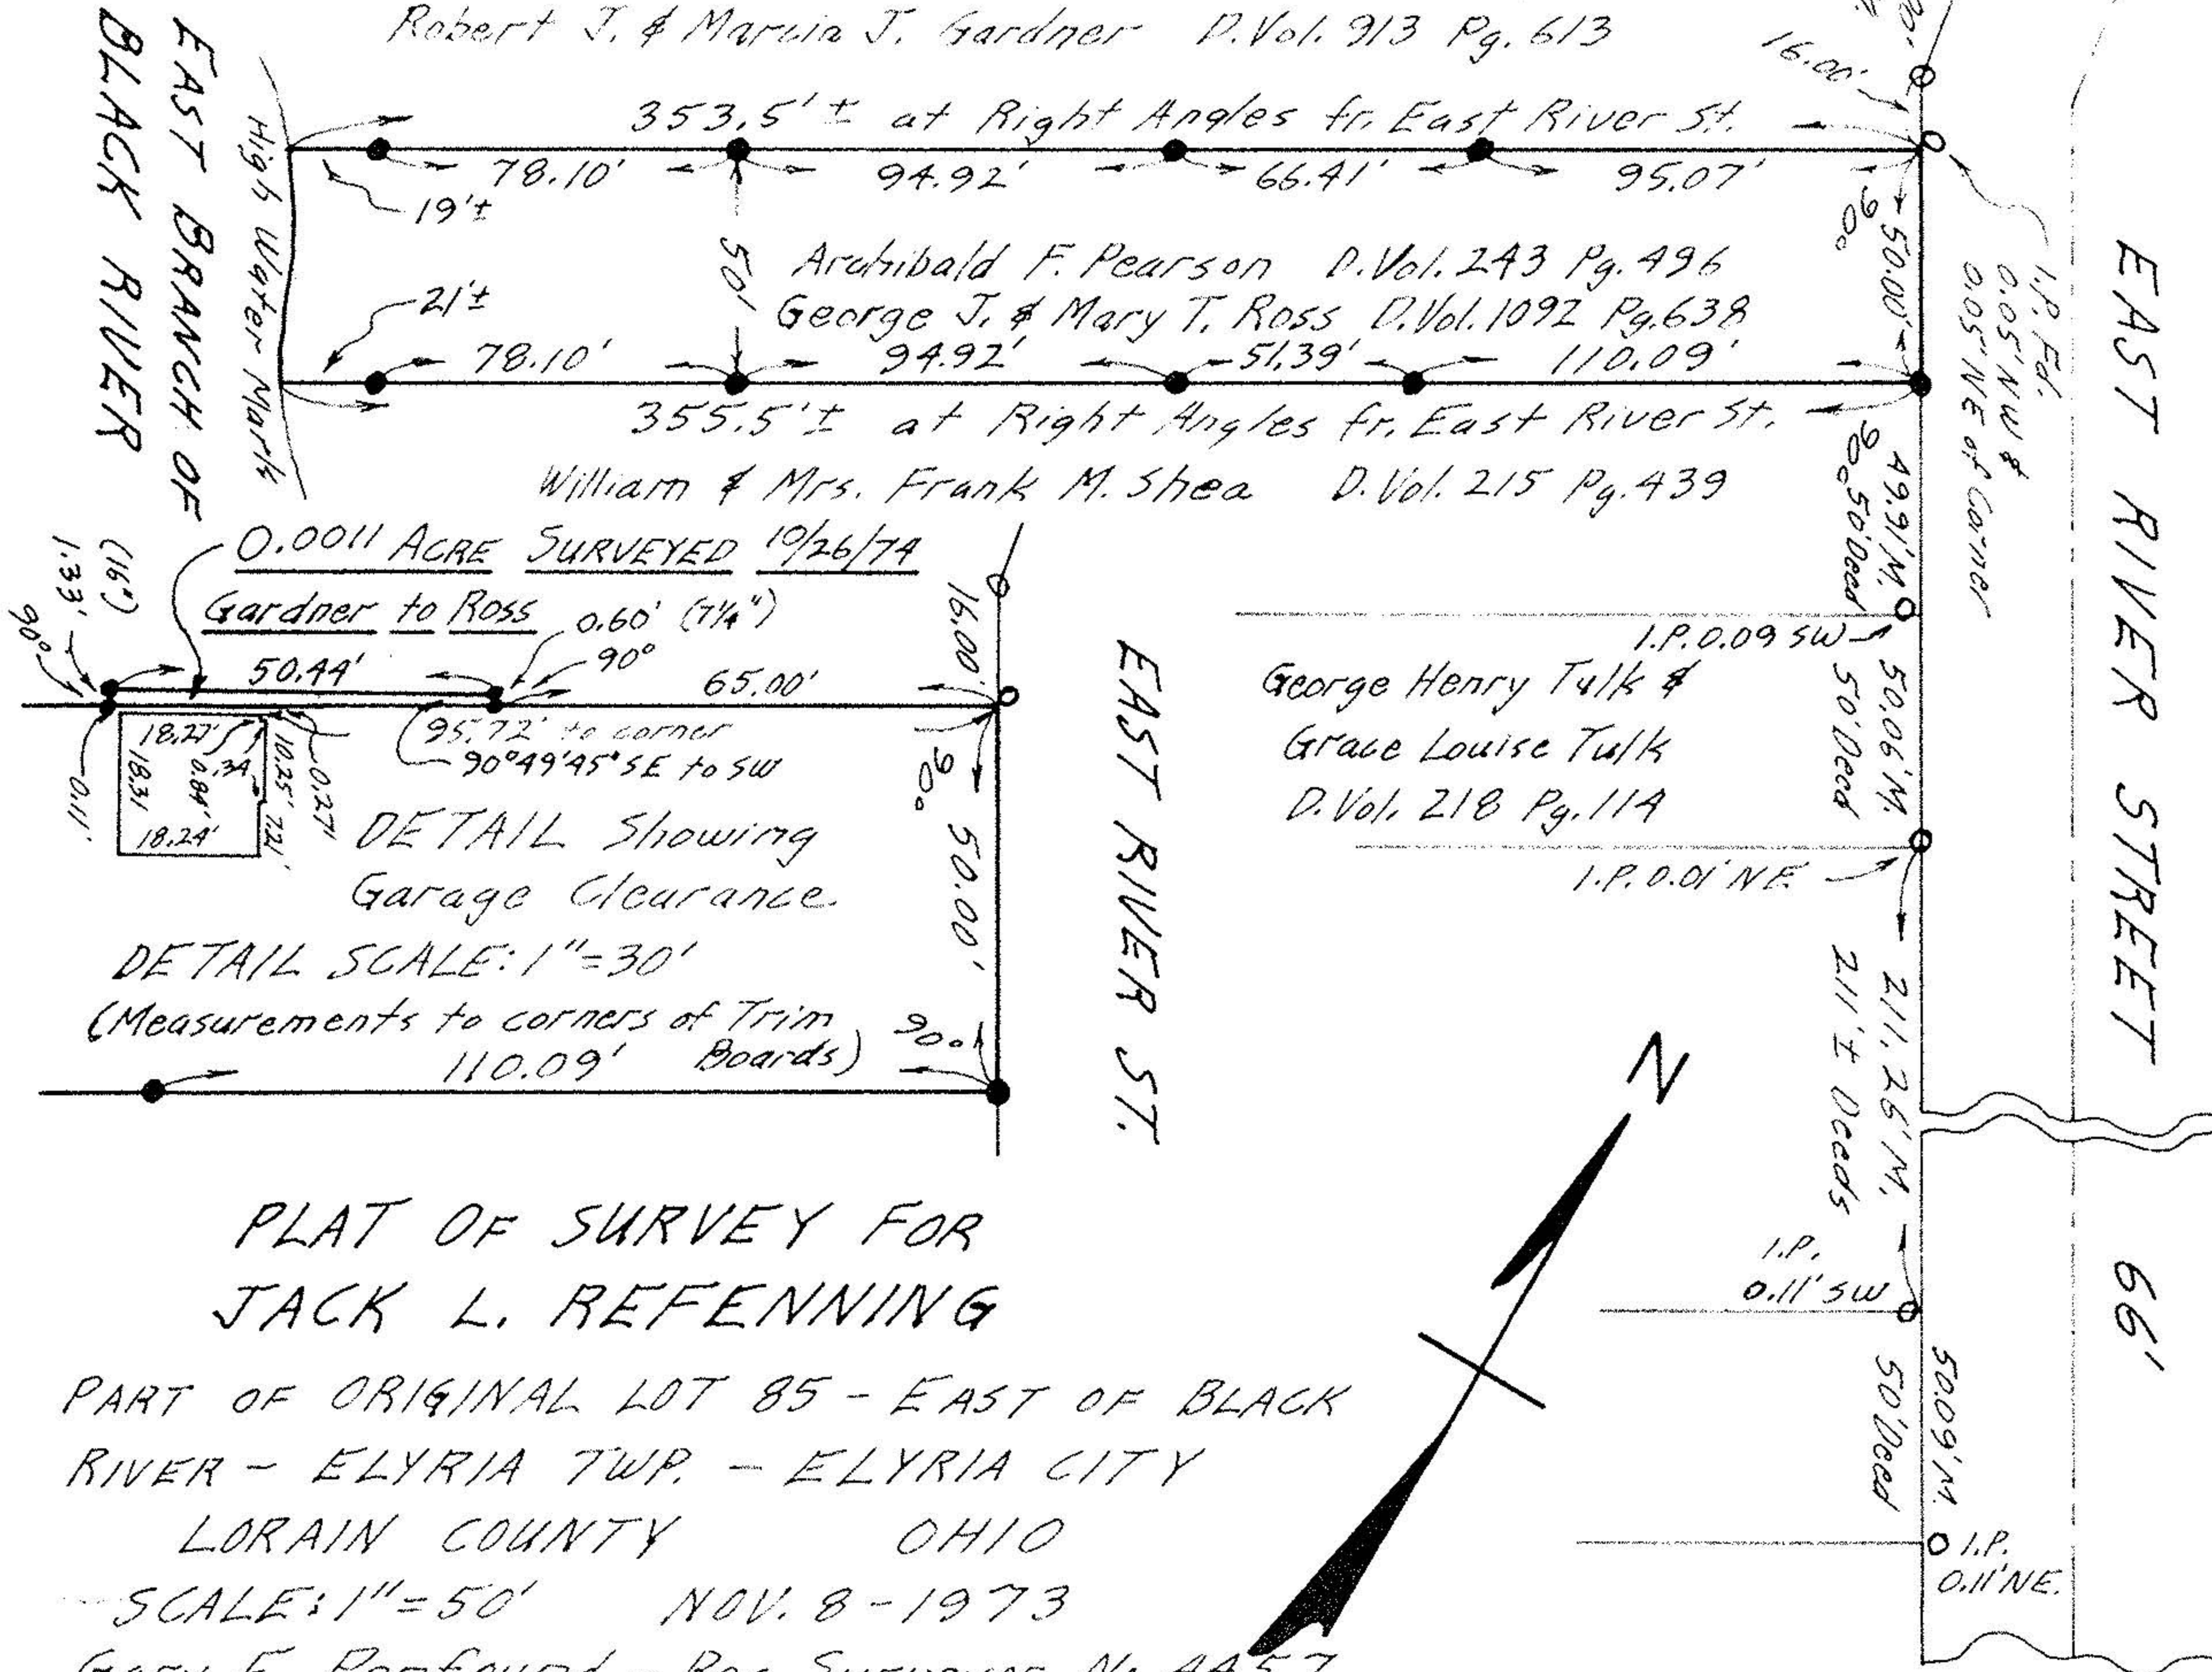

NOTES: ○ indicates iron pin found.  
● indicates iron pin set.

PLAT OF SURVEY FOR  
JACK L. REFENNING

PART OF ORIGINAL LOT 85 - EAST OF BLACK  
RIVER - ELYRIA TWP. - ELYRIA CITY  
LORAIN COUNTY OHIO

SCALE: 1" = 50' NOV. 8 - 1973

Gary E. Penfound - Reg. Surveyor No. 4457