KLEINOEDER · SCHMIDT and ASSOCIATES

ENGINEERS — SURVEYORS — CONSULTANTS in LAND PLANNING

ELYRIA · NORWALK · MEDINA — OHIO

SURVEY

Sublot(s) 9 & 10

Subd'n GULF FARMS ADD'N.

Township ELYRIA — Tract EAST OF THE RIVER

Orig. Lot(s) 162, 161 — Sec.

County of LORAIN — State of Ohio

Corporation ELYRIA

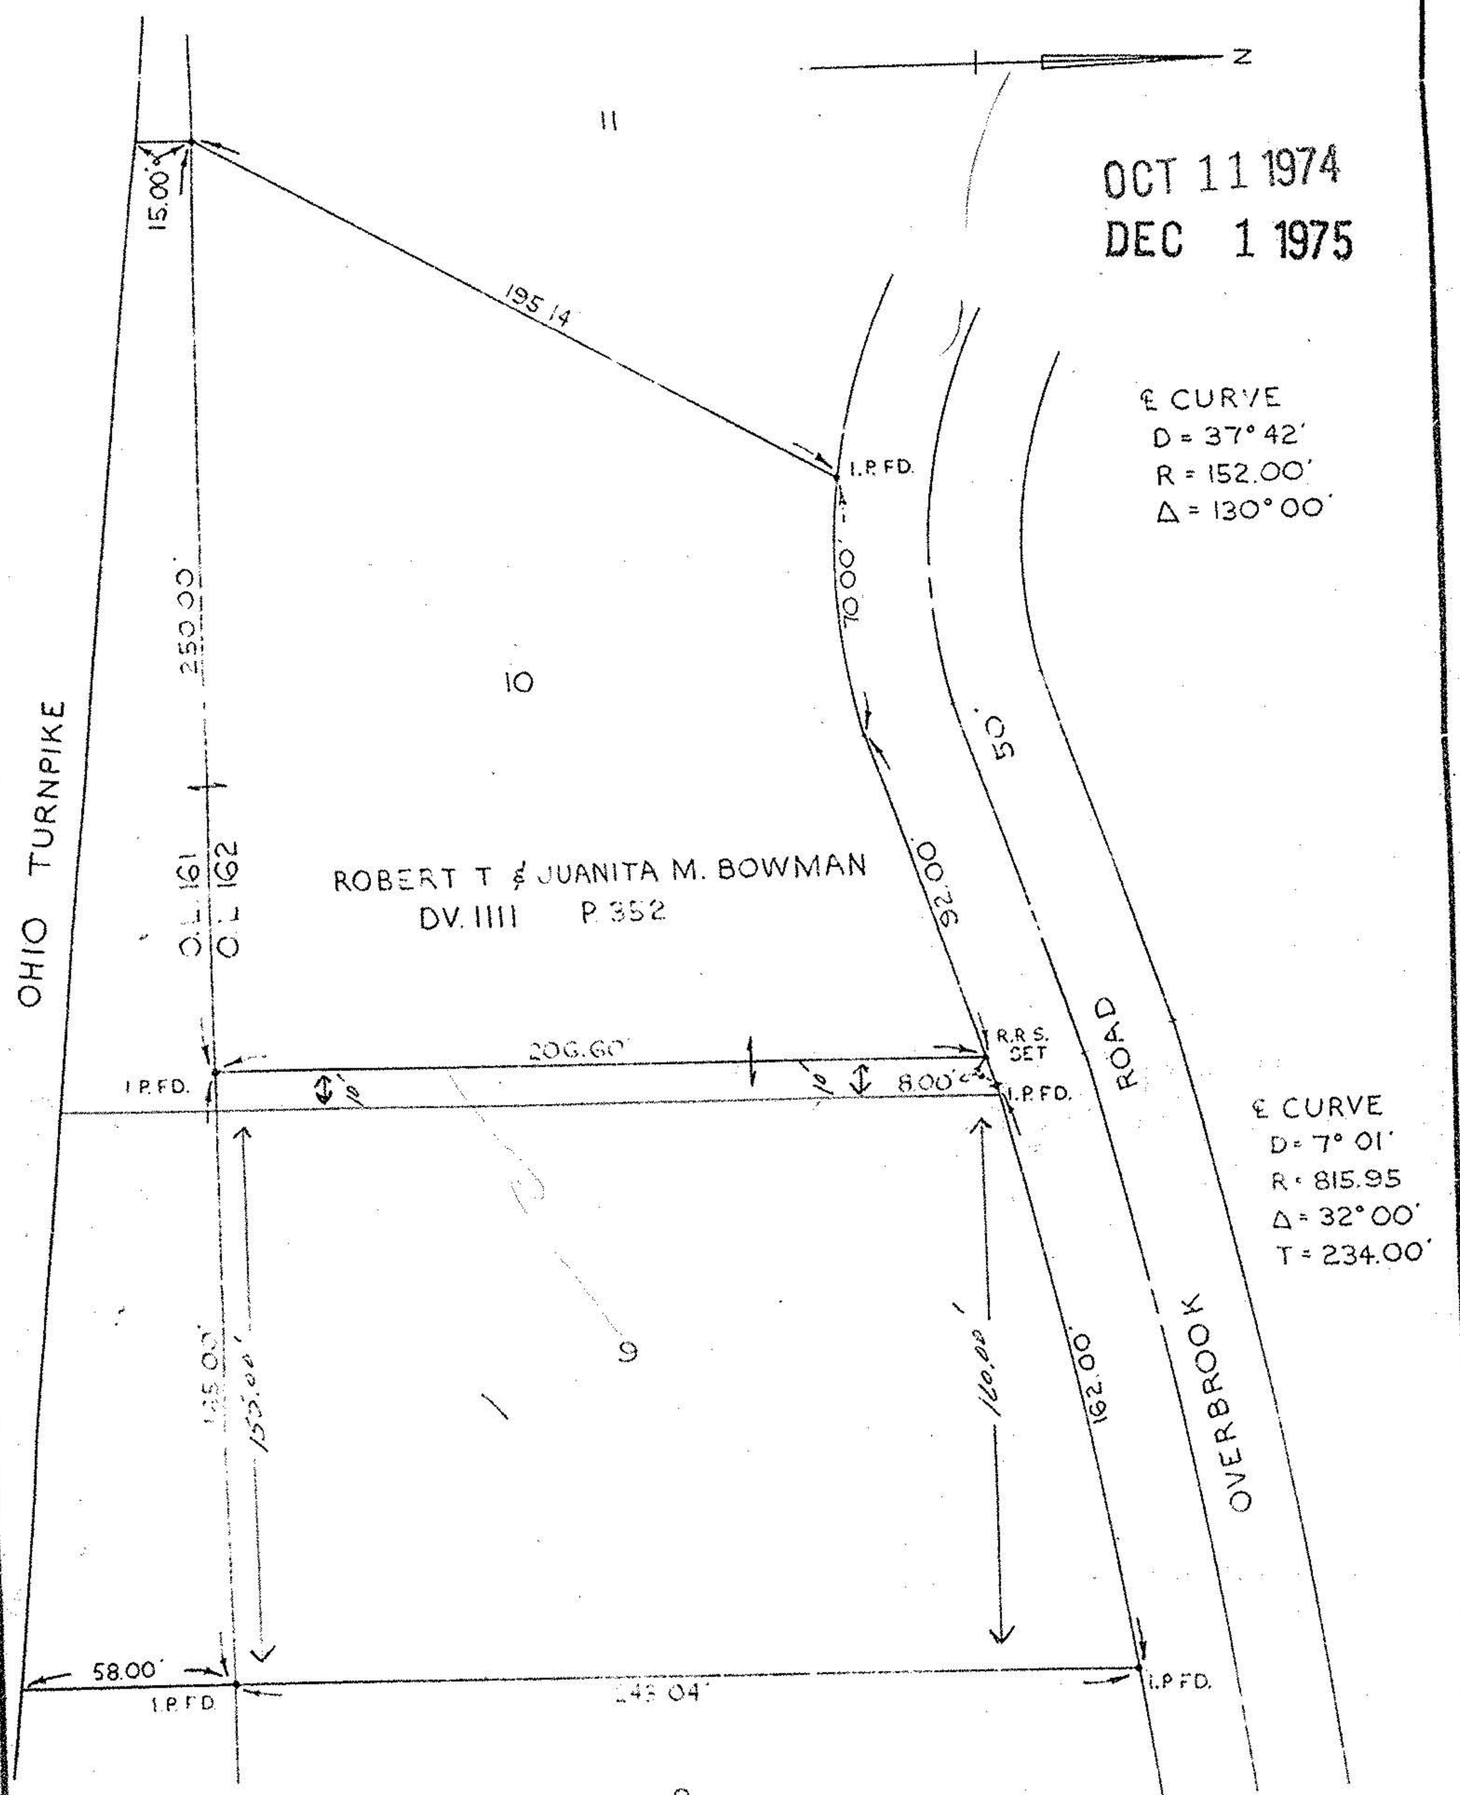

OCT 11 1974
DEC 1 1975

℄ CURVE
D = 37° 42'
R = 152.00'
Δ = 130° 00'

℄ CURVE
D = 7° 01'
R = 815.95
Δ = 32° 00'
T = 234.00'

Prepared for: ROBERT T. BOWMAN

Scale: 1" = 50'	Date: 9-9-74	Dr. by:	Job No 74-238