O.L. 1
T. 26

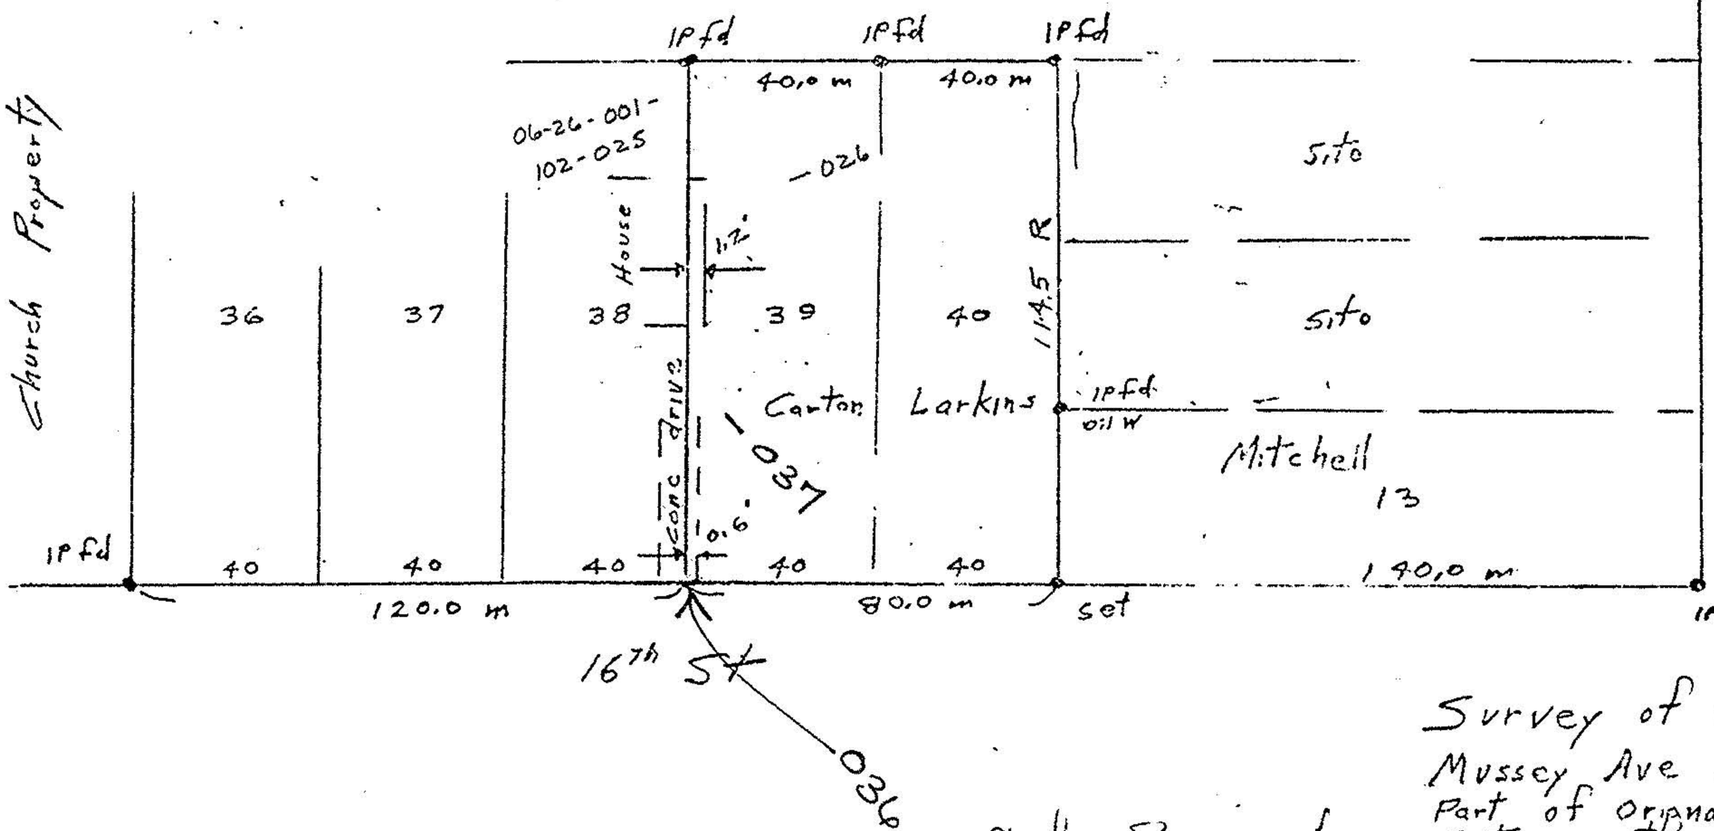

#16932

APPROVED
RAIN CO.
M. DEPT.
DATE 8-11-86
PAGE 6-137
BY C. FRANCIS
VOID AFTER 16982

Scale 1" = 40'

John Pozgainik
P.S. # 5292

Survey of sublots 39, 40
Mussey Ave Allt P.Vol 8 Pg 49
Part of original Lot
Between the Black Rivers
City of Elyria
Lorain County Ohio
Scale 1" = 40' July 11, 1986