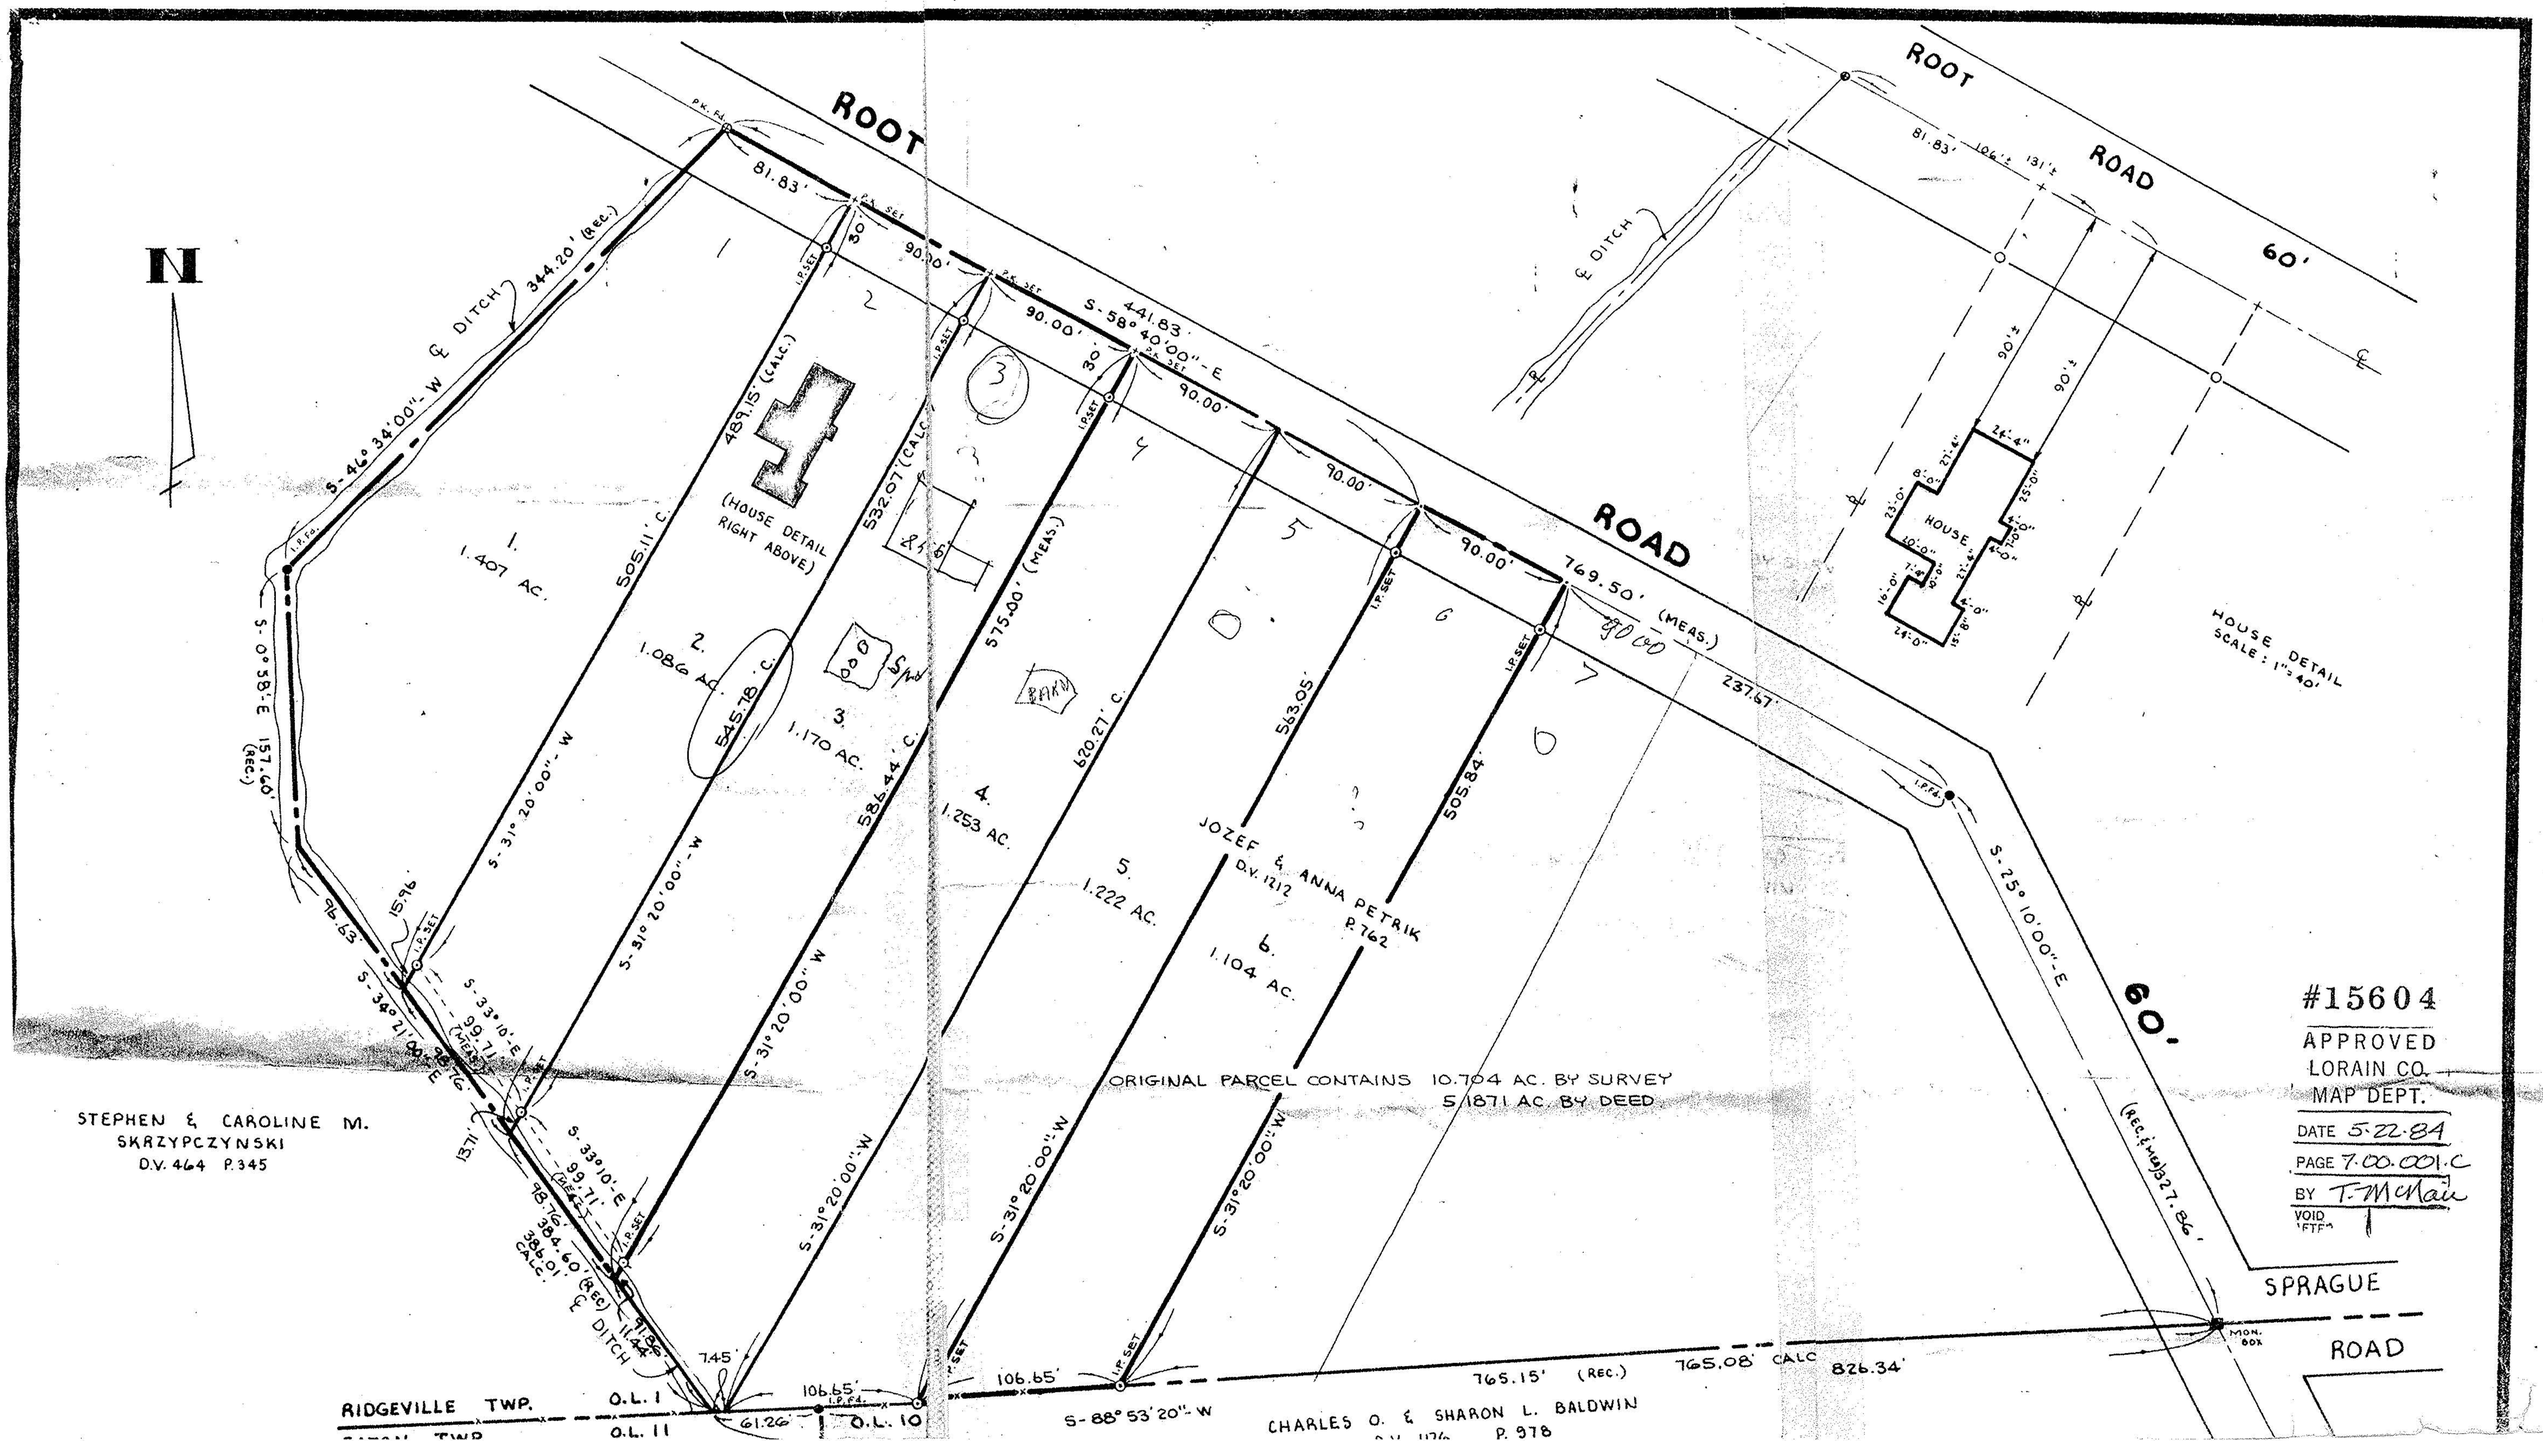

N
ROOT ROAD
ROOT ROAD 60'
60'
SPRAGUE ROAD
HOUSE DETAIL SCALE: 1"=40'
HOUSE
(HOUSE DETAIL RIGHT ABOVE)
S-46° 34'00"-W
344.20' (REC.)
℄ DITCH
S-58° 40'00"-E
441.83'
81.83'
90.00'
769.50' (MEAS.)
237.67'
S-25° 10'00"-E
(REC.&MEAS.) 327.86'
S-0° 58'-E
157.60' (REC.)
S-31° 20'00"-W
505.11' C.
489.15' (CALC.)
532.07' (CALC.)
575.00' (MEAS.)
586.44' C.
620.27' C.
563.05'
505.84'
545.78' C.
1. 1.407 AC.
2. 1.086 AC.
3. 1.170 AC.
4. 1.253 AC.
5. 1.222 AC.
6. 1.104 AC.
JOZEF & ANNA PETRIK D.V. 1212 P. 762
ORIGINAL PARCEL CONTAINS 10.704 AC. BY SURVEY
5.1871 AC. BY DEED
STEPHEN & CAROLINE M. SKRZYPCZYNSKI D.V. 464 P. 345
S-34° 21'00"-E
S-33° 10'-E
99.71' (MEAS.)
384.60' (REC.)
386.01' CALC.
℄ DITCH
RIDGEVILLE TWP.
O.L. 1
O.L. 11
O.L. 10
61.26'
106.65'
7.45'
S-88° 53'20"-W
765.15' (REC.)
765.08' CALC
826.34'
CHARLES O. & SHARON L. BALDWIN
P. 978
MON. BOX
#15604
APPROVED
LORAIN CO.
MAP DEPT.
DATE 5-22-84
PAGE 7.00.001.C
BY T. McNair
VOID