

7-00-002-B


# 16014

07-00-002-102


is to certify to  
COLWELL FINANCIAL CORP.  
and/or

MIDLAND TITLE SECURITY INC.


we have given a location service on the subject property; the buildings, if any, are contained within the boundaries as shown; and there are no apparent encroachments or visible easements unless shown. The purpose and intent of a location service is as attached and a part hereof, defines the limitations and precision of this service.

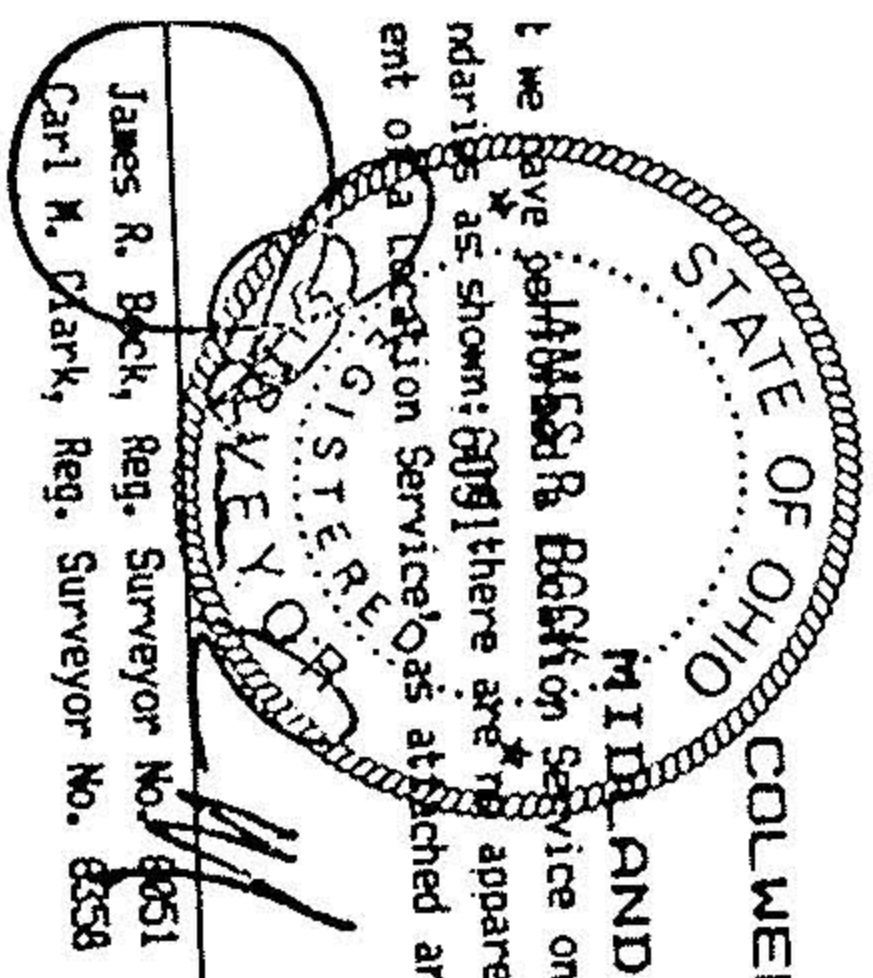

#16014  
APPROVED  
LORAIN CO.  
MAP DEPT.  
DATE 2-1-85  
PAGE 7-00-002-B  
BY T. McMain  
VOID

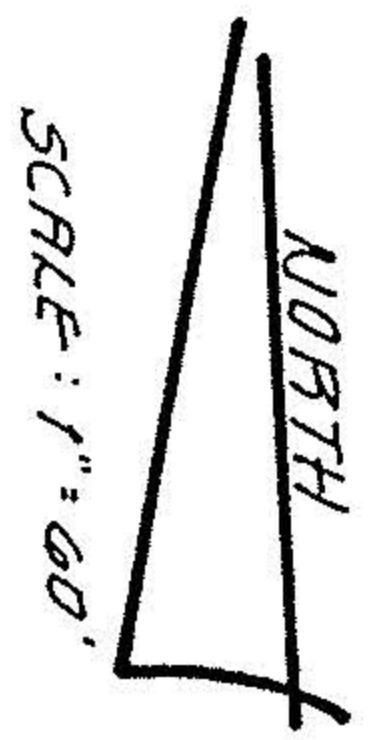

SCALE: 1" = 60'

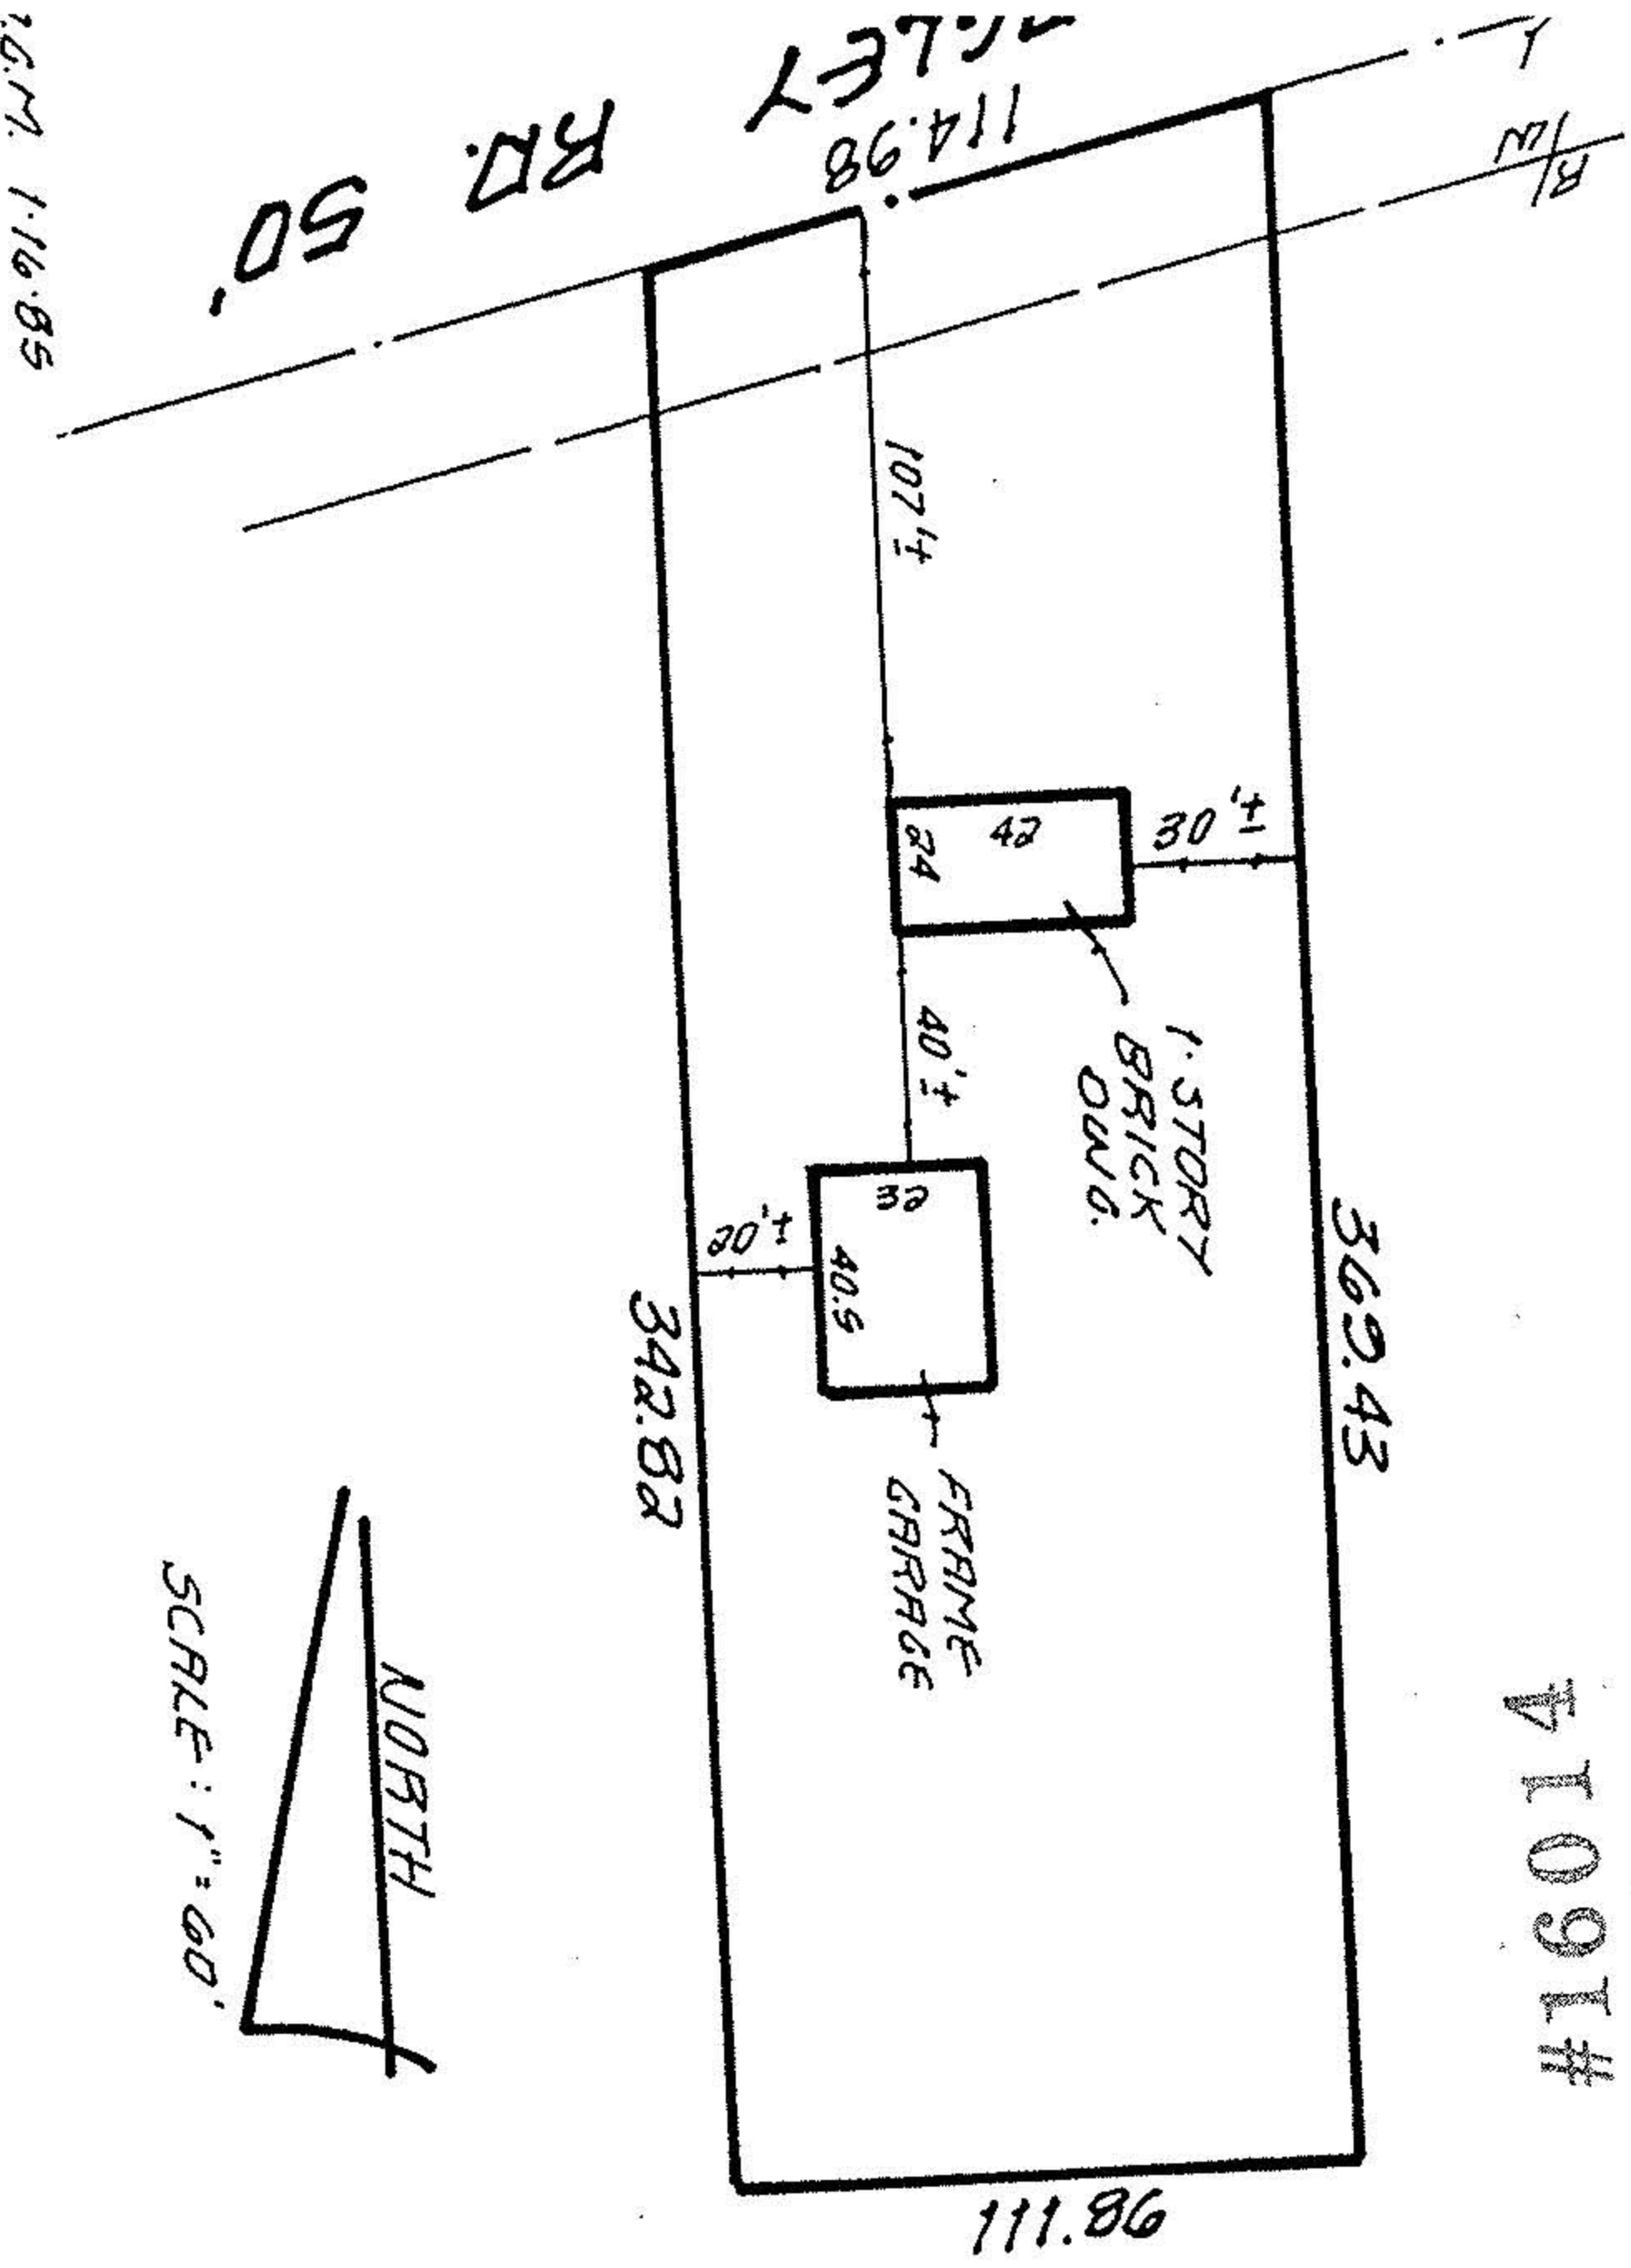

31725 BAGLEY ROAD  
CITY OF NORTH RIDGEVILLE  
LORAIN COUNTY  
P.P.N. 07-00-02-102-039  
DATE: 1-15-85 2:30 PM

PLAT BOOK — PAGE(S) —  
NEW OWNER: CECIL B. KOHOUT  
PRESENT OWNER: JOSEPH JR. & ANNA SKAPURA  
YOUR ORDER NO. 10-18441

BOCK & CLARK LOCATION SERVICE

26264