LEGEND

⊠	–	EXISTING MONUMENT BOX
◎	–	IRON PIN/PIPE FOUND
O	–	5/8" CAPPED REBAR SET
•	–	PK NAIL FOUND
R.	–	RECORD
S.	–	SURVEYED
U.	–	USED

BEARING SYSTEM IS ASSUMED.

50 0 50 100

SCALE IN FEET
SCALE: 1" = 50'

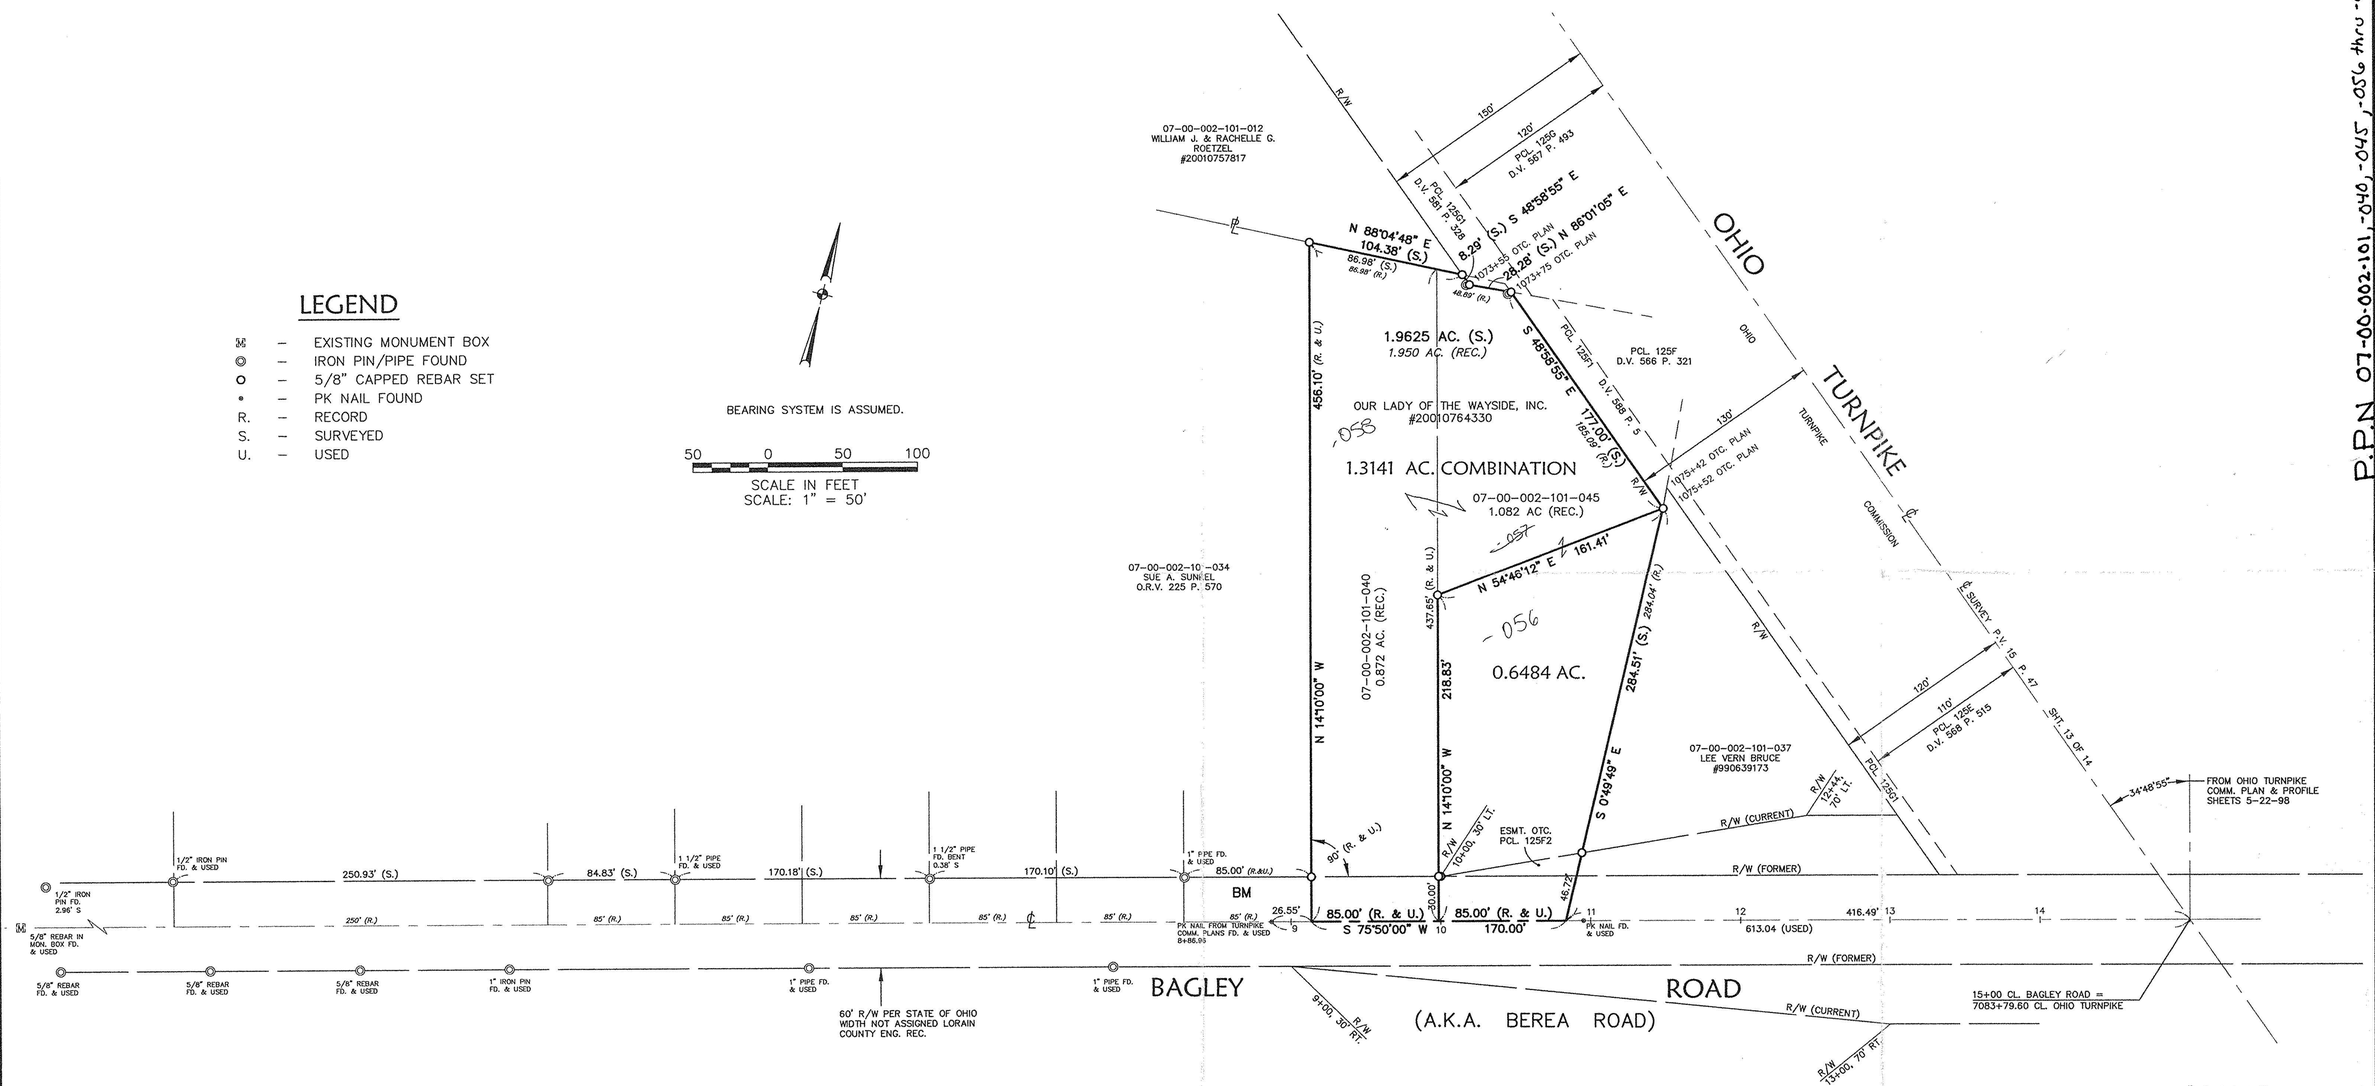

OHIO TURNPIKE & BAGLEY ROAD R/W PER
O.T.C. PROJECT No. 1, SHEET 17 OF 78.

№ 01117

APPROVED
LORAIN CO.
MAP DEPT

DATE 6-19-02
PAGE 7-00-002-A
BY JHatfield
02-01117

David L. Elwell
DAVID L. ELWELL, REGISTERED SURVEYOR No. 6333

STATE OF OHIO
DAVID L. ELWELL
6333
REGISTERED
SURVEYOR

P.P.N. 07-00-002-101, -040, -045, -056 thru -058

DATE	DESCRIPTION	BY
2-25-02	ORIGINAL ISSUE	ABR

REVISIONS

DATE: 2-22-02
DRAWN BY: ABR
CH'D BY:
DWG. NAME: 0-SPLIT01
PATH: 01215
F.B. 569, 571

KS ASSOCIATES, INC.
260 Burns Road, Suite 100
P.O. Box 569
Elyria, Ohio 44036
Phone (440) 365-4730
Fax (440) 365-4790
mail@ksassoc.com
www.ksassoc.com
KS ASSOCIATES

SURVEY MAP

OF PART OF
ORIGINAL RIDGEVILLE TOWNSHIP LOT No. 2
CITY OF NORTH RIDGEVILLE COUNTY OF LORAIN STATE OF OHIO

SHEET 1 OF 1

JOB NO.
01215-02S