


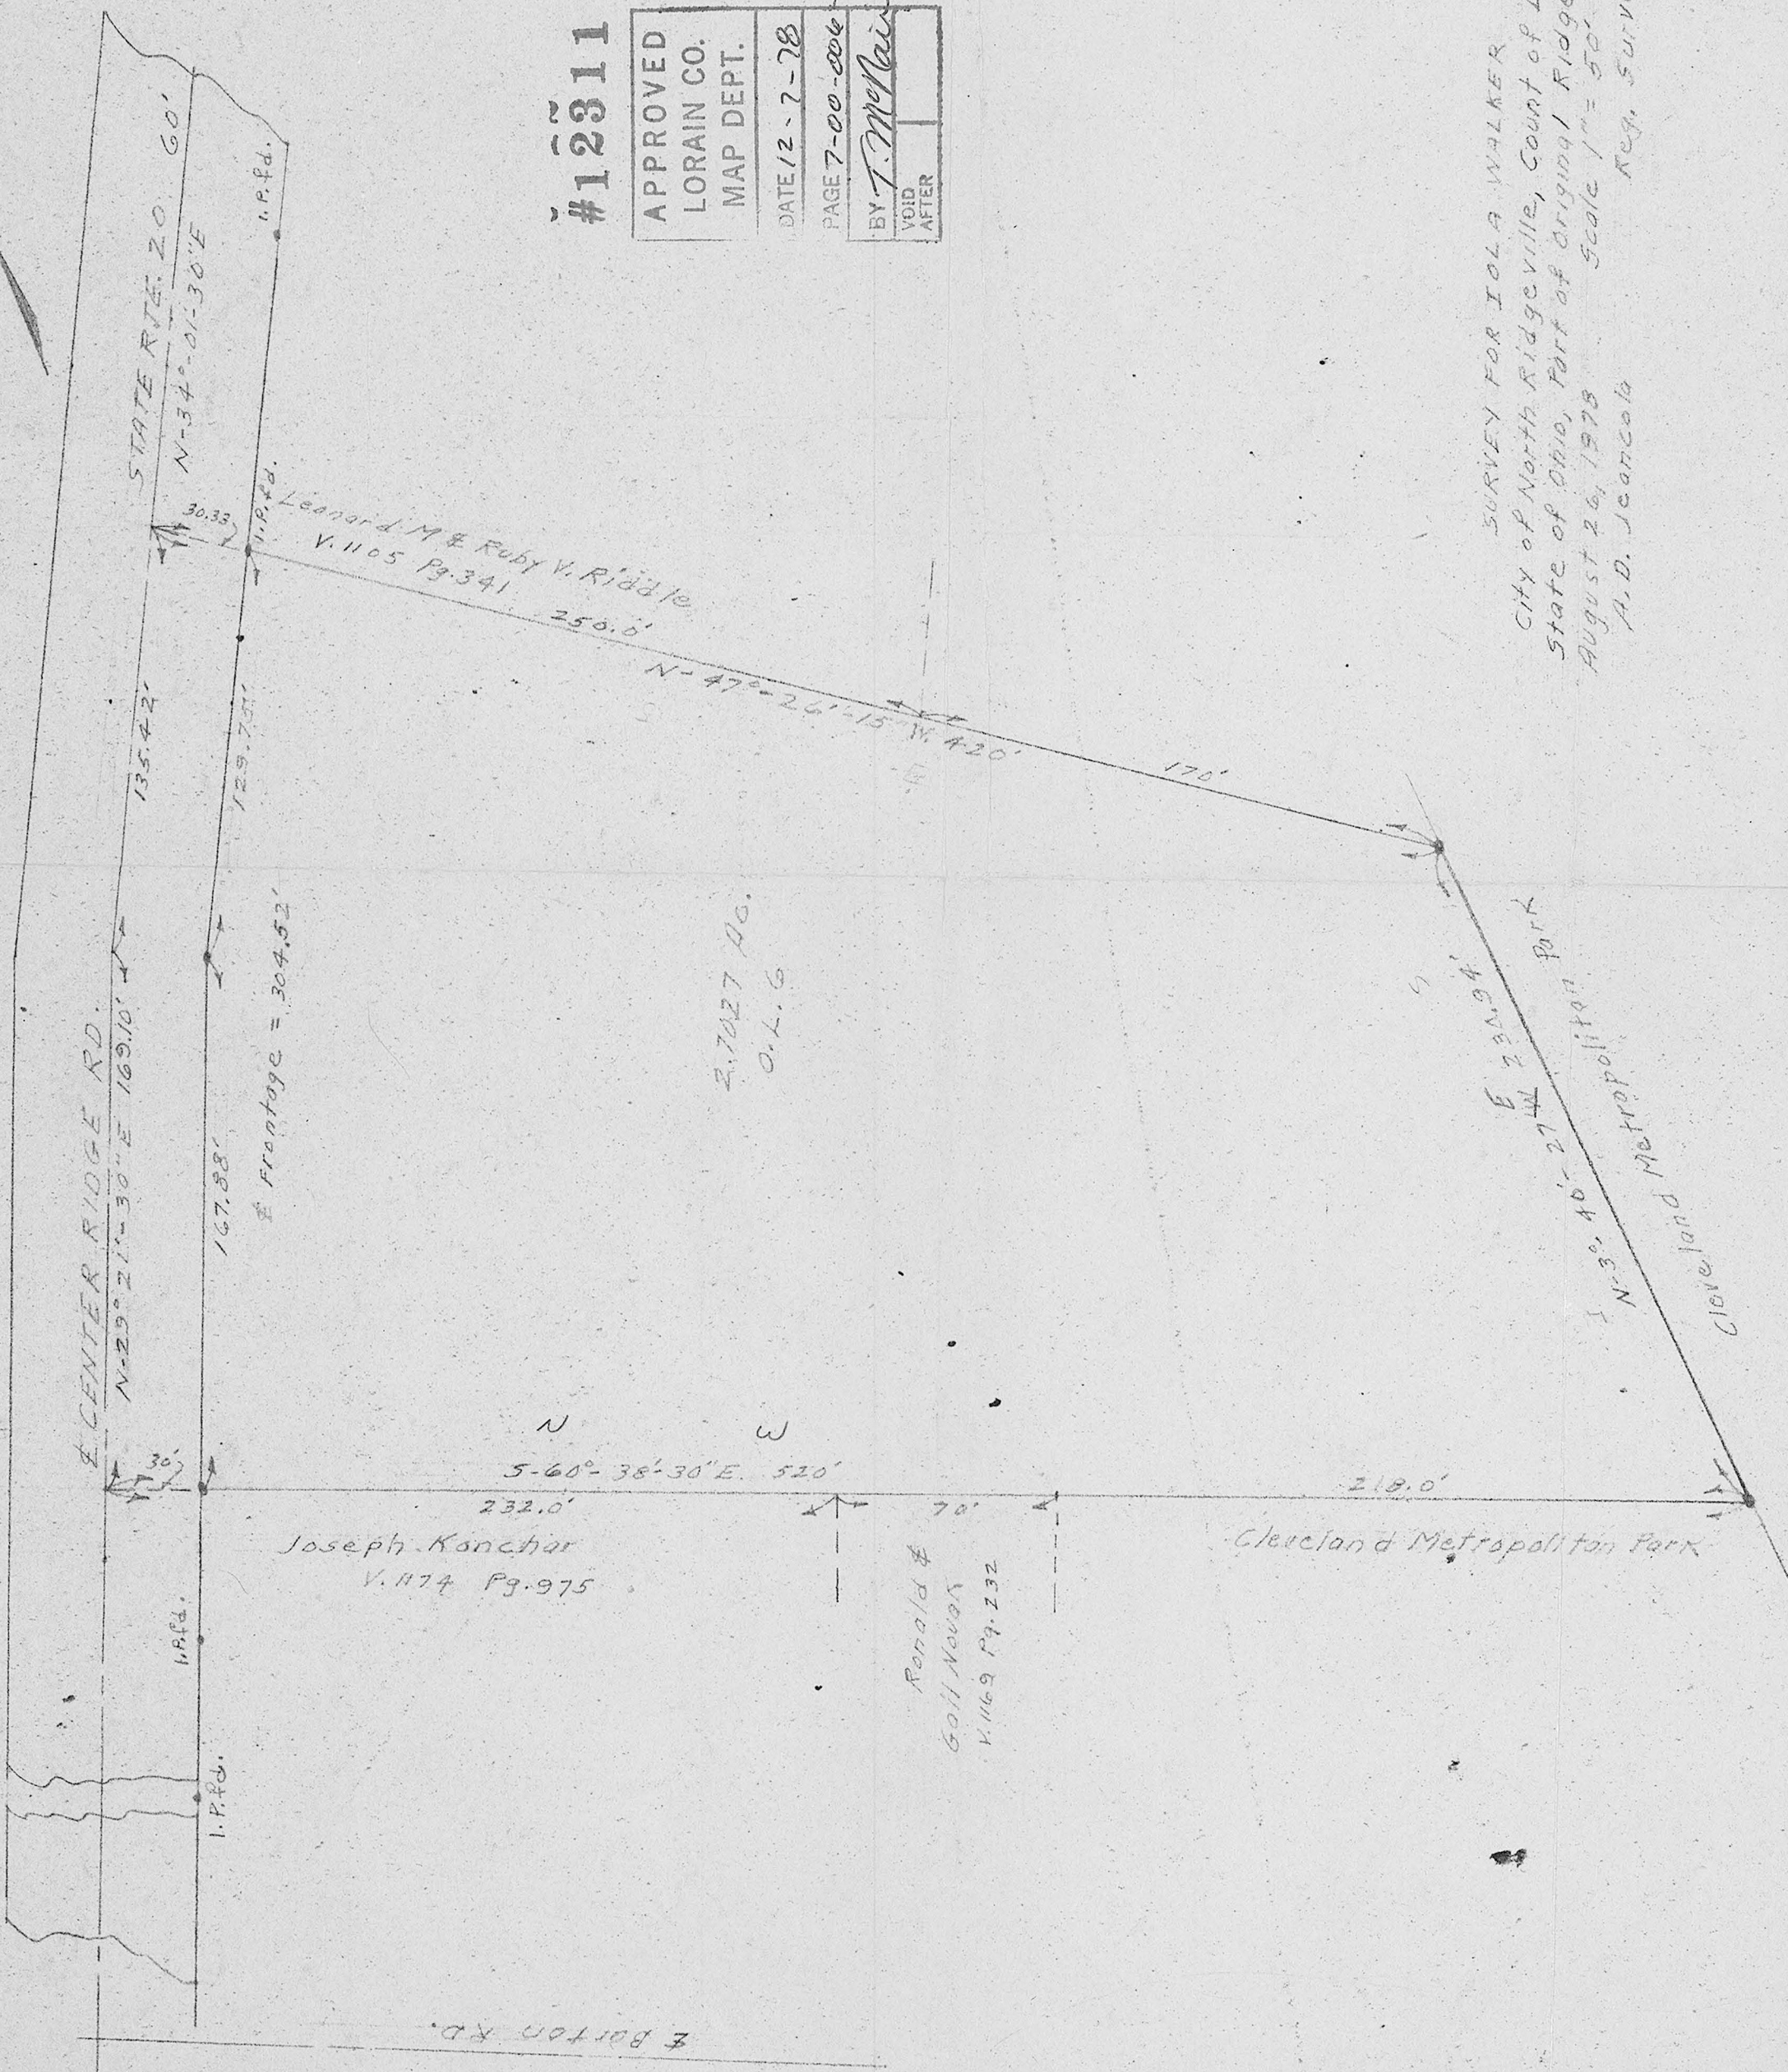

#12311

APPROVED
LORAIN CO.
MAP DEPT.
DATE 12-7-78
PAGE 7-00-006-13
BY <i>T. McNeil</i>
VOID AFTER

SURVEY FOR IOLA WALKER  
 City of North Ridgeville, Count of Lorain  
 State of Ohio, Part of Original Ridgeville Twp. Lot No. 6  
 August 26, 1978 Scale 1" = 50'  
 H. D. Jancicola Reg. Surveyor



7-00-006-D