7-00-004-C #18428 07-00-004-136

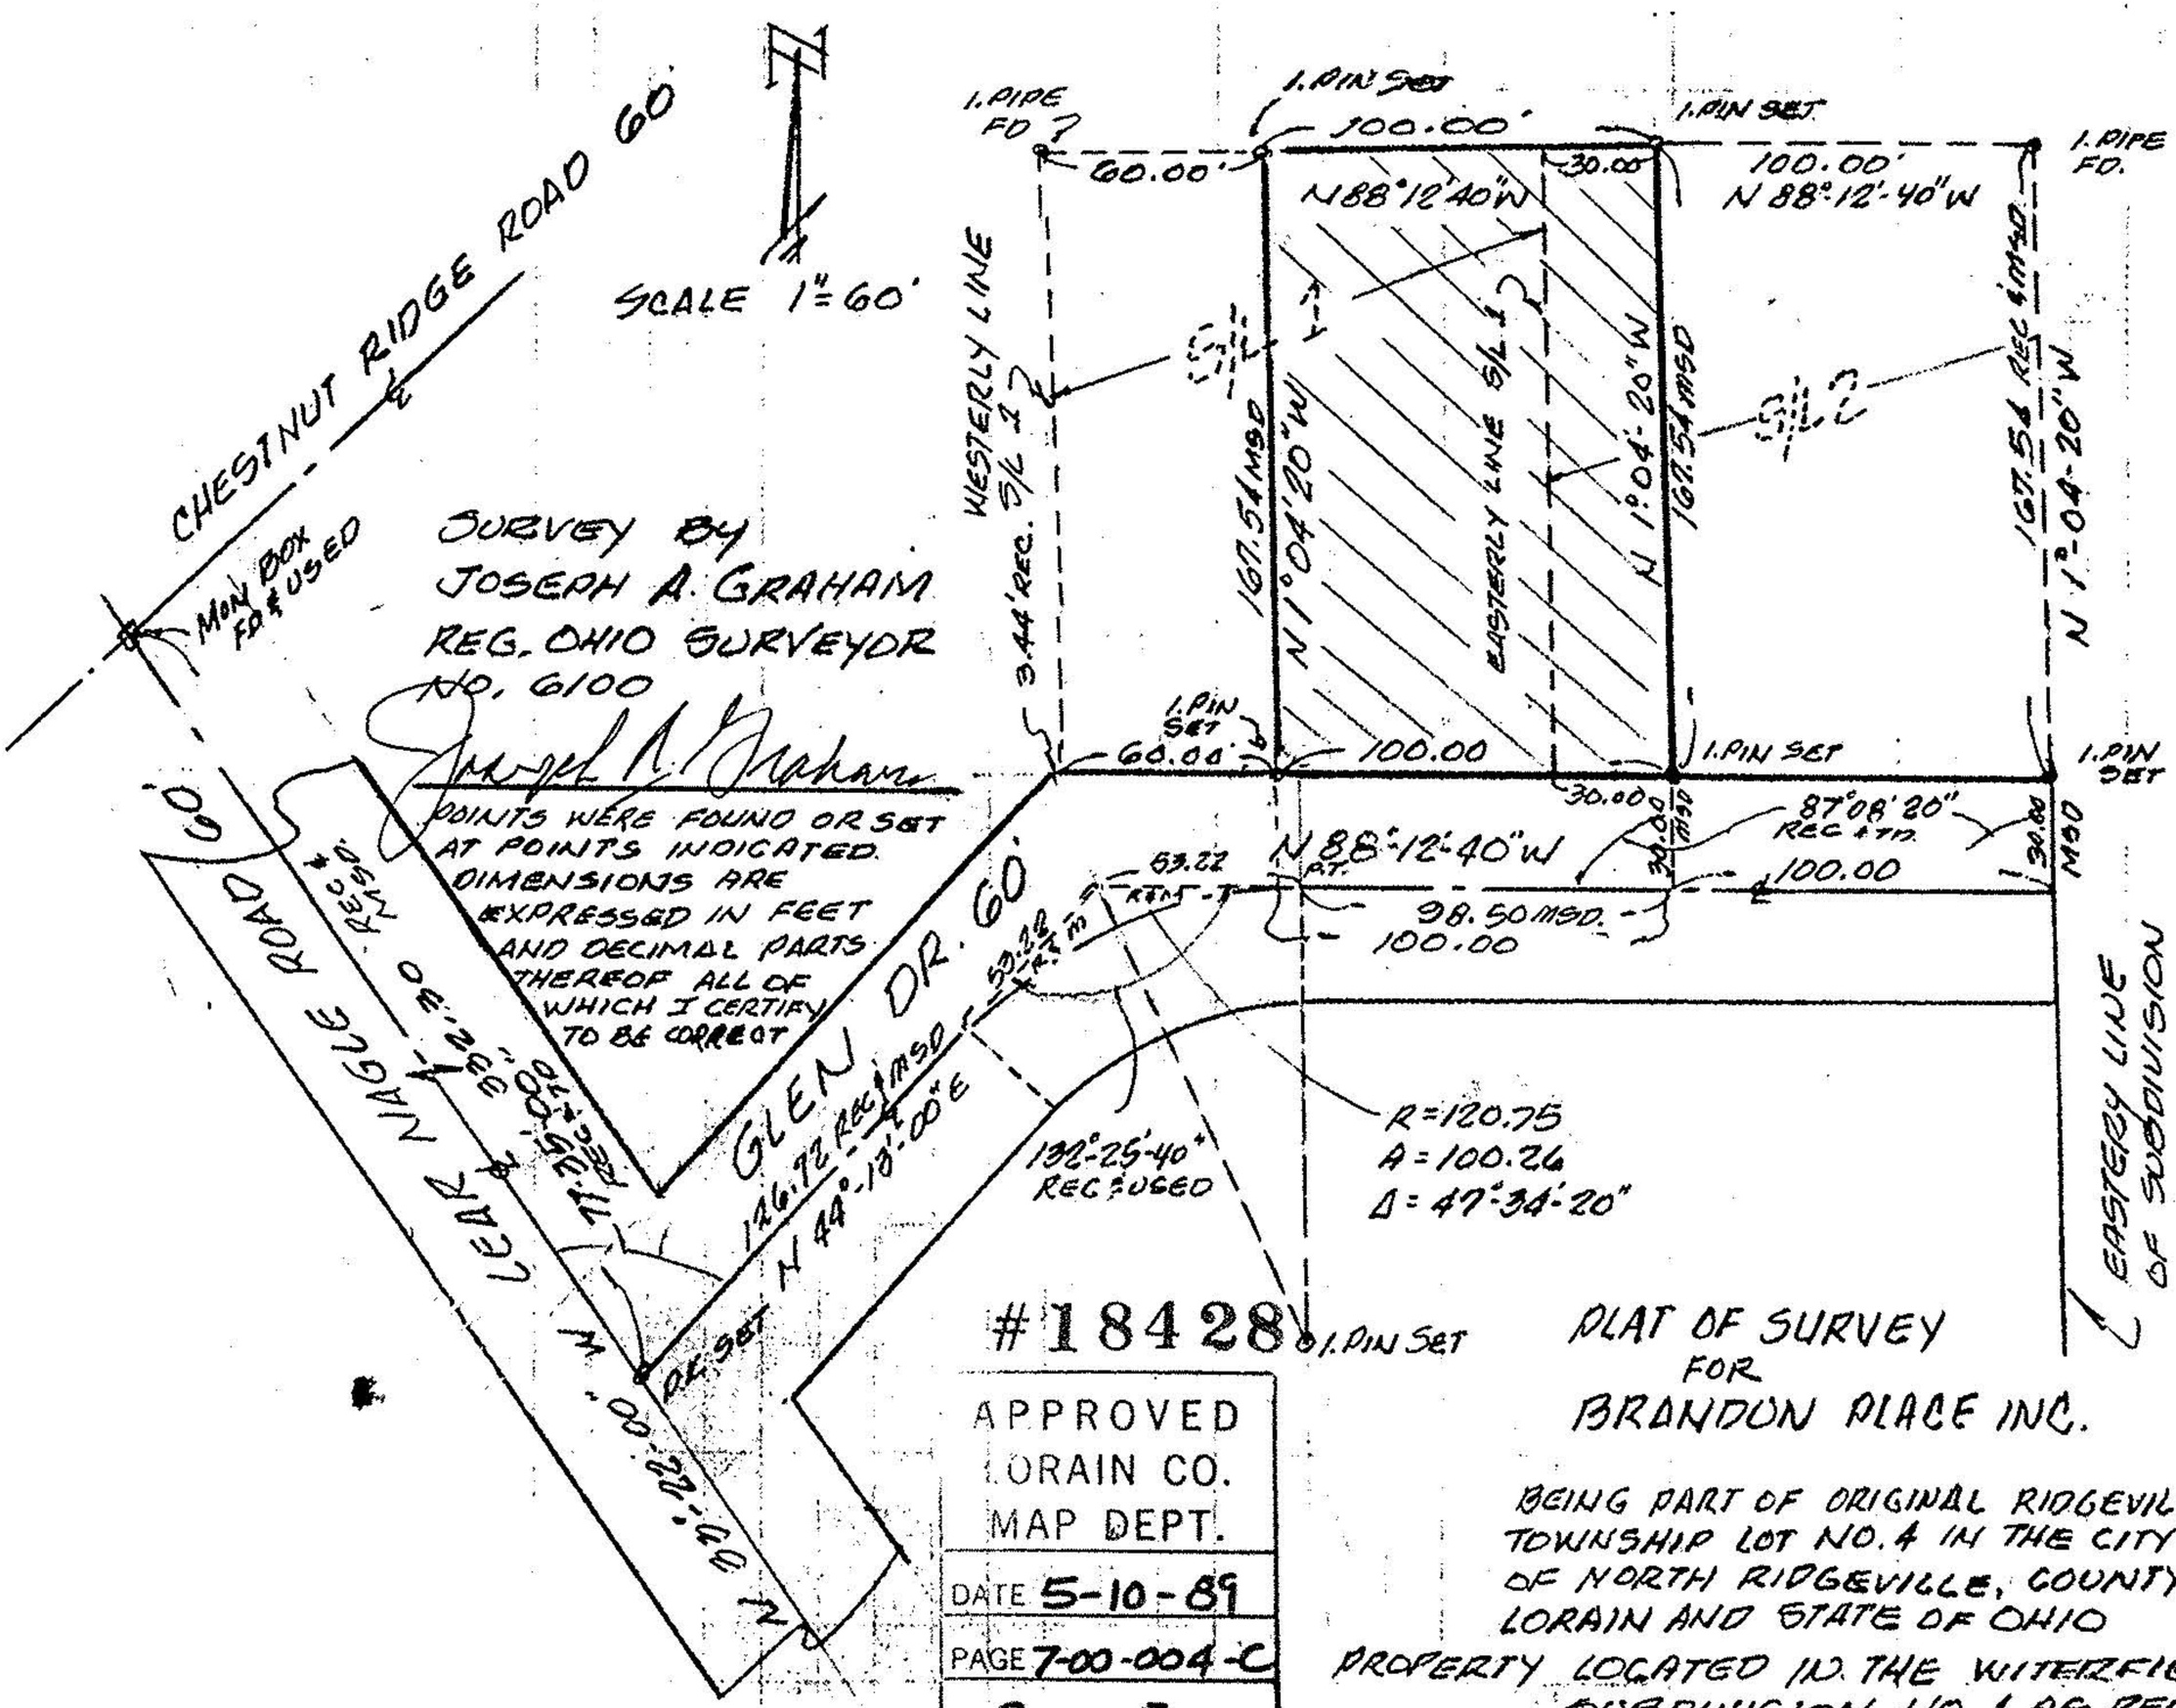

SURVEY BY
JOSEPH A. GRAHAM
REG. OHIO SURVEYOR
NO. 6100

Joseph A. Graham

POINTS WERE FOUND OR SET AT POINTS INDICATED. DIMENSIONS ARE EXPRESSED IN FEET AND DECIMAL PARTS THEREOF ALL OF WHICH I CERTIFY TO BE CORRECT

#18428

APPROVED
LORAIN CO.
MAP DEPT.
DATE 5-10-89
PAGE 7-00-004-C
BY Carol Francis
VOID # 18428

PLAT OF SURVEY
FOR
BRANDON PLACE INC.

BEING PART OF ORIGINAL RIDGEVILLE TOWNSHIP LOT NO. 4 IN THE CITY OF NORTH RIDGEVILLE, COUNTY OF LORAIN AND STATE OF OHIO

PROPERTY LOCATED IN THE WITERFIELD SUBDIVISION NO. 1 AS RECORDED IN VOL 21 PG. 6 OF L.C.R.