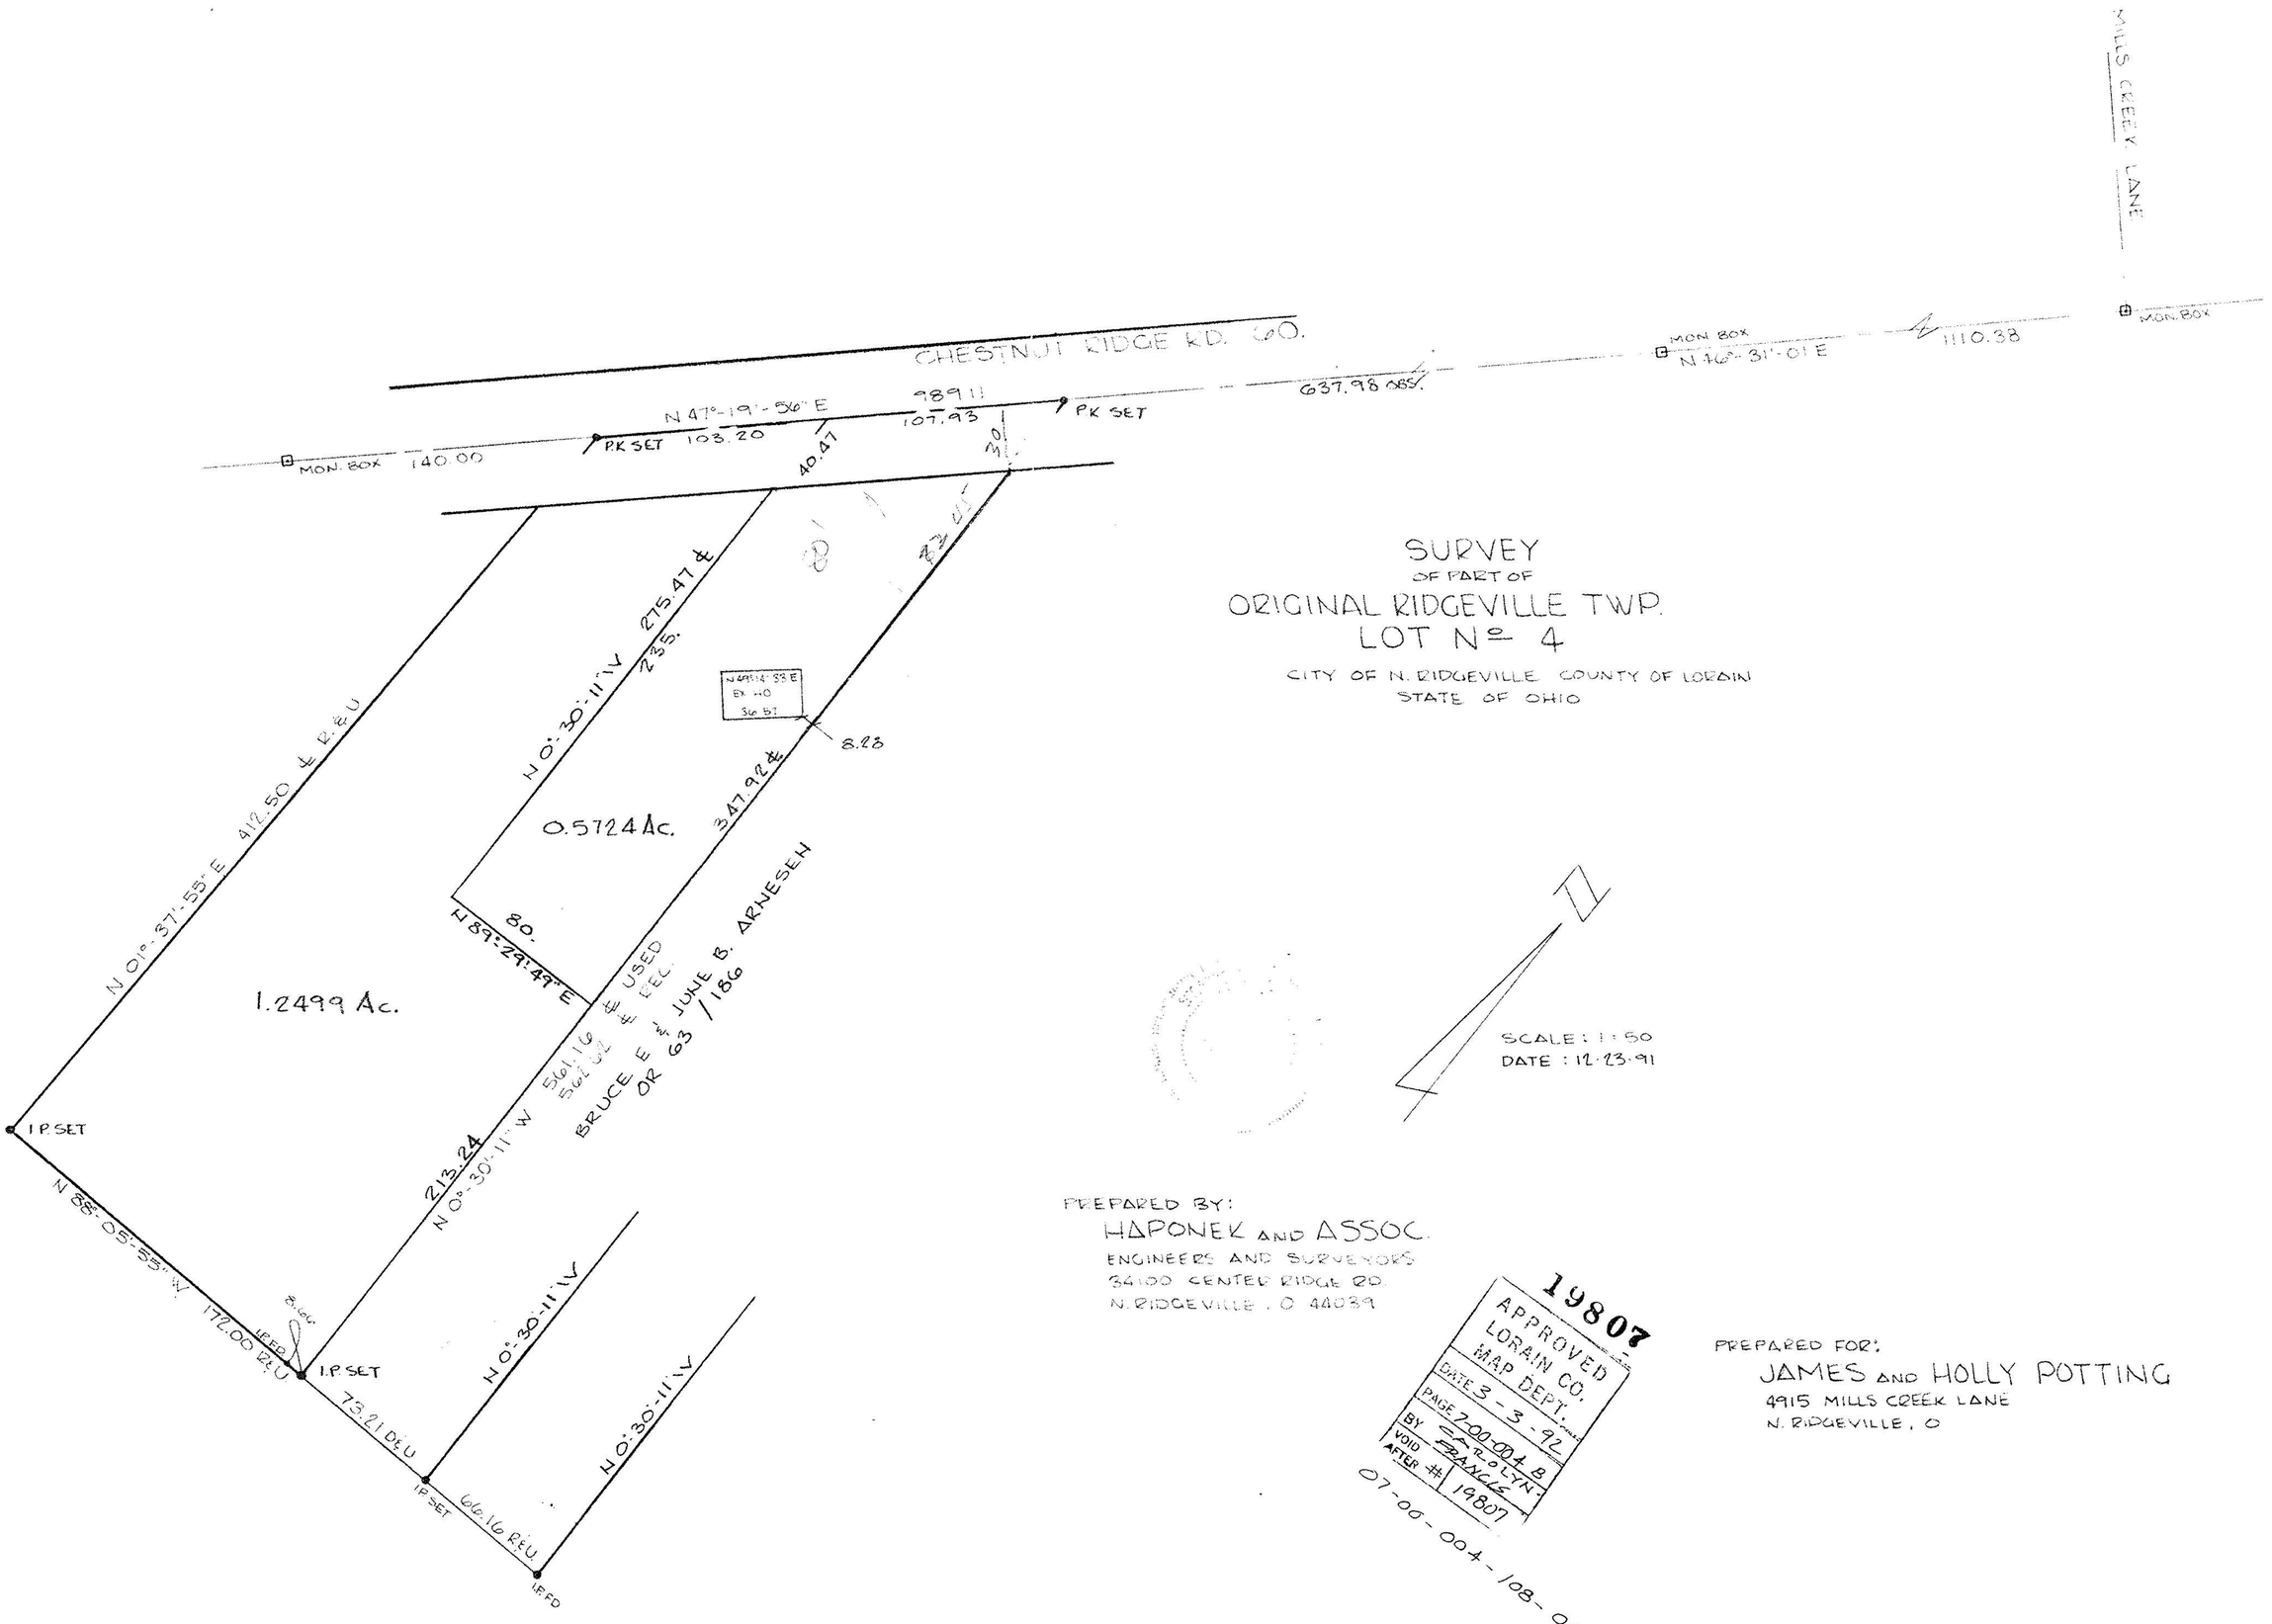

SURVEY
OF PART OF
ORIGINAL RIDGEVILLE TWP.
LOT Nº 4

CITY OF N. RIDGEVILLE COUNTY OF LORAIN
STATE OF OHIO

SCALE : 1 : 50
DATE : 12-23-91

PREPARED BY:
HAPONEK AND ASSOC.
ENGINEERS AND SURVEYORS
34100 CENTER RIDGE RD.
N. RIDGEVILLE, O 44039

19807
APPROVED
LORAIN CO.
MAP DEPT.
DATE 3-3-92
PAGE 2-00-004 B
BY CAROLYN FRANCIS
VOID AFTER # 19807

07-00-004-108-065

PREPARED FOR:
JAMES AND HOLLY POTTING
4915 MILLS CREEK LANE
N. RIDGEVILLE, O