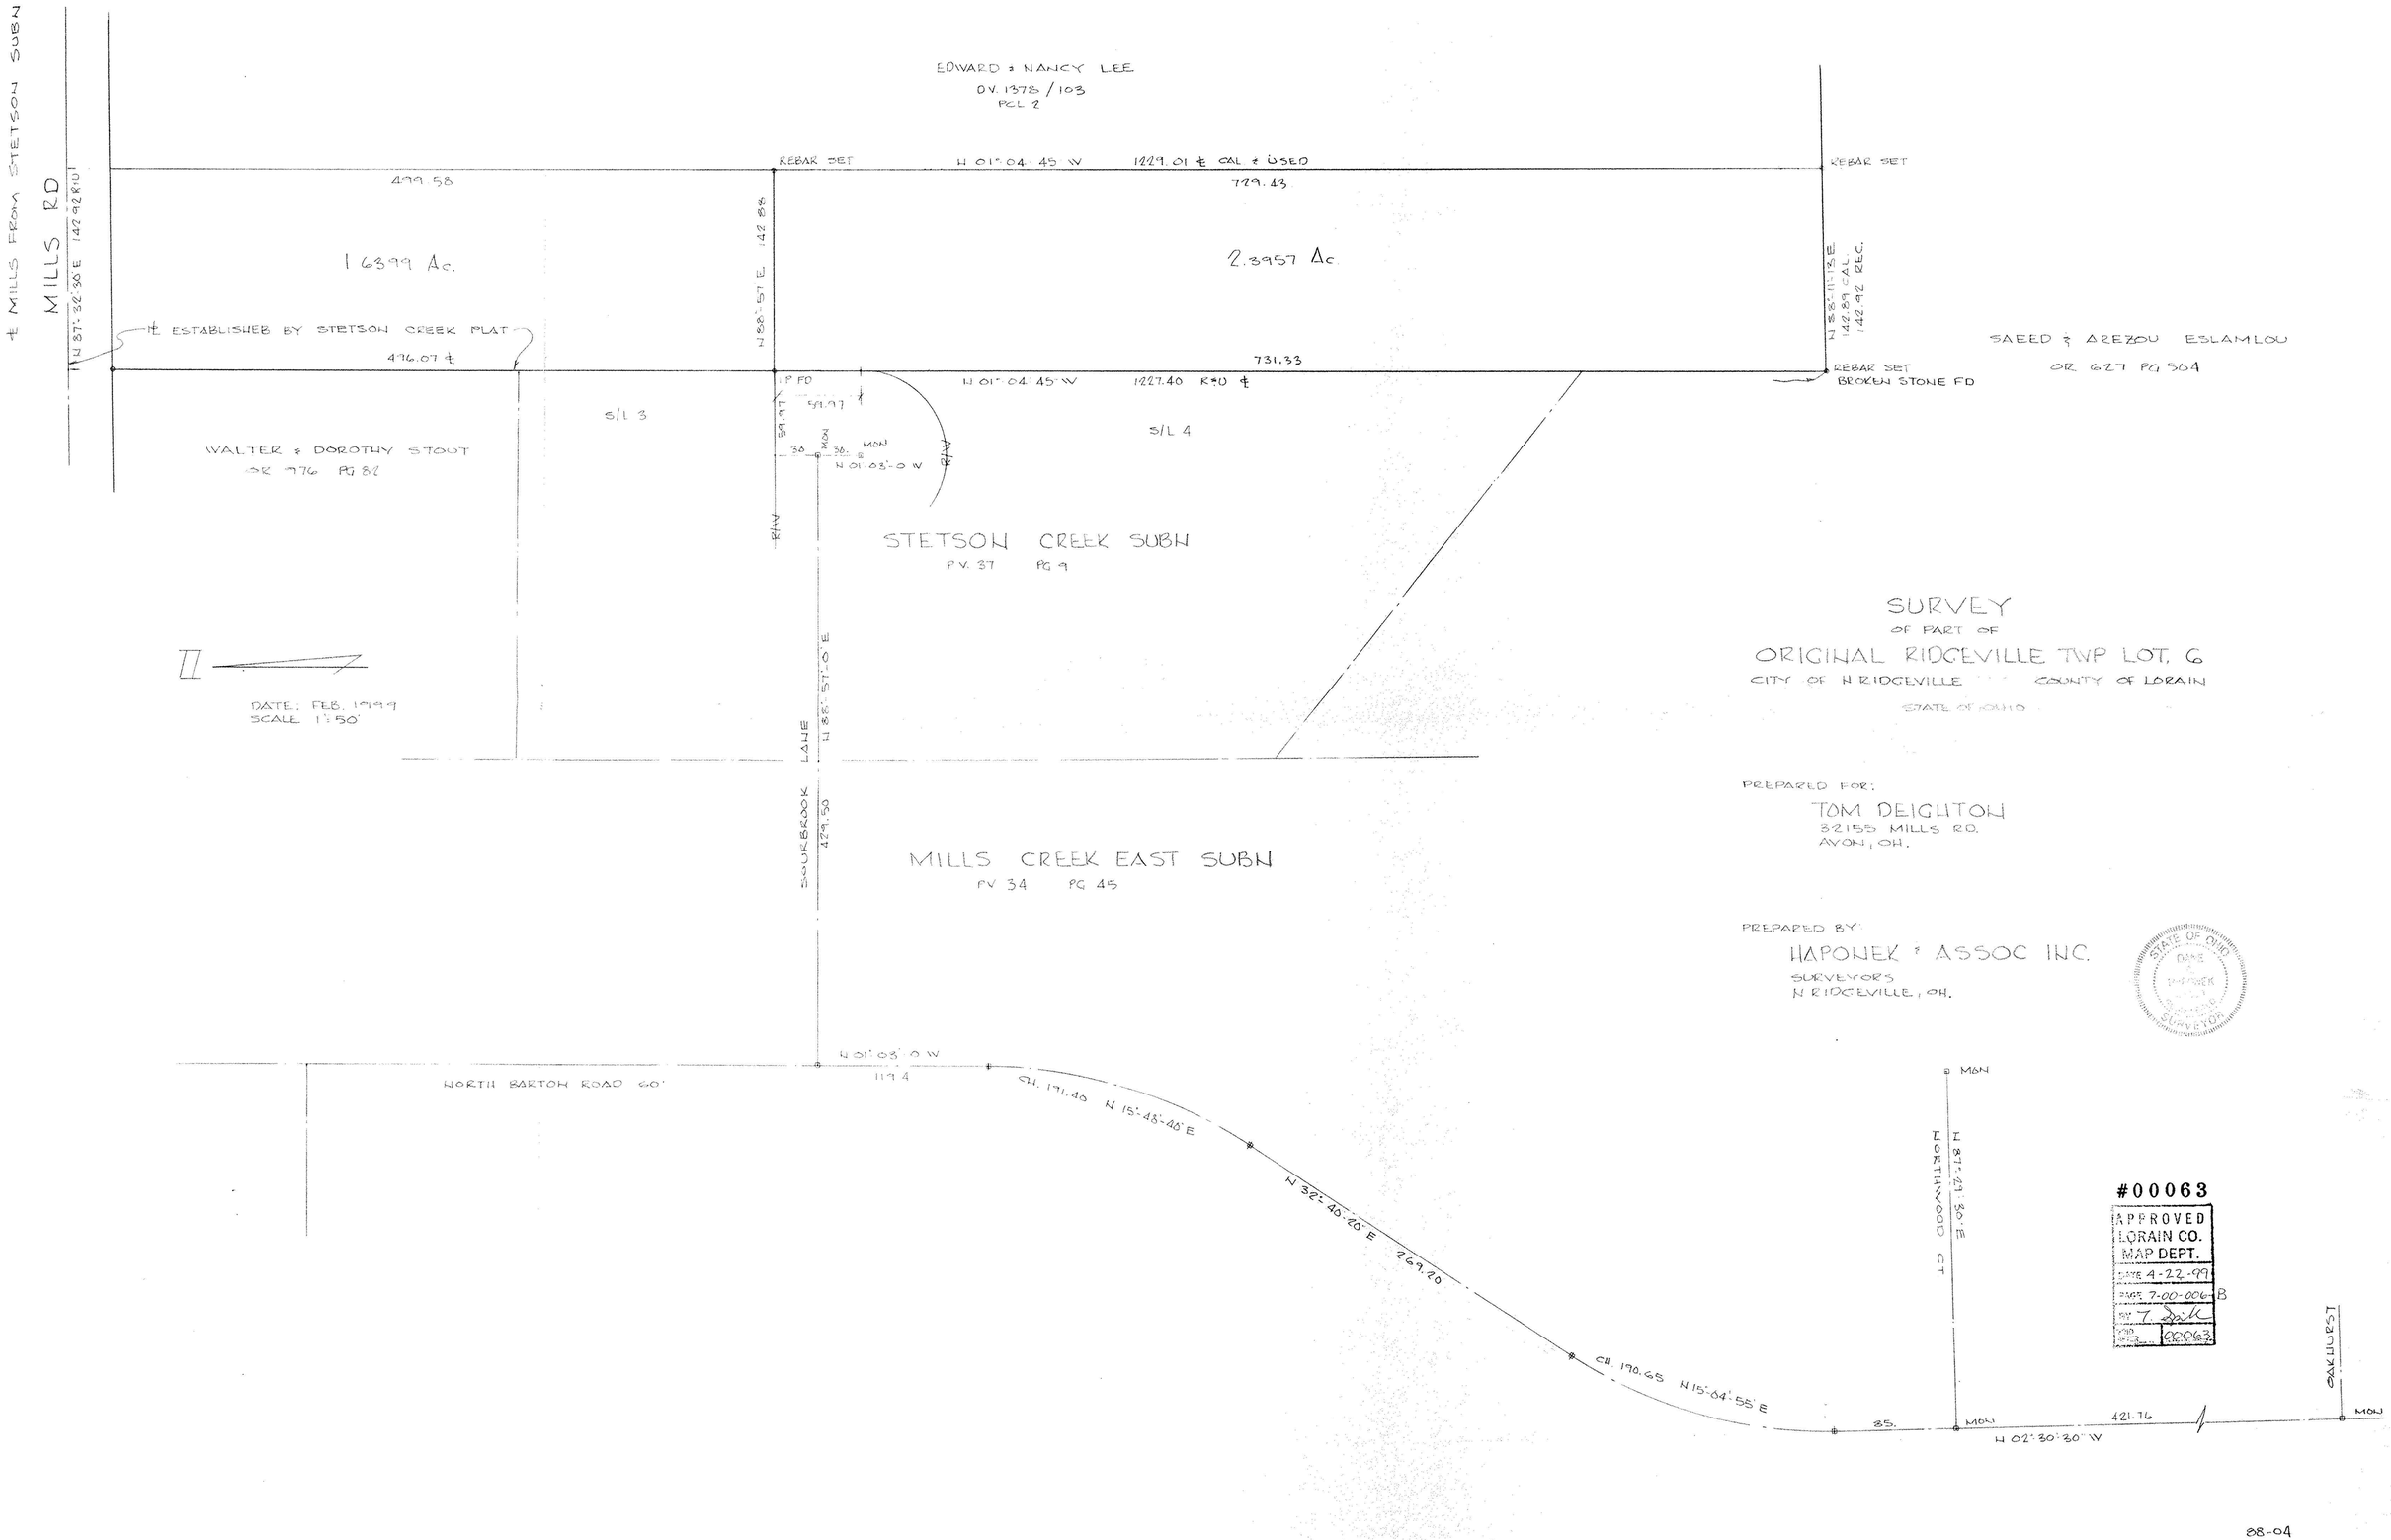
℄ MILLS FROM STETSON SUBN
MILLS RD
N 87°-32'-36" E 142.92 R&U
EDWARD & NANCY LEE
DV. 1378 / 103
PCL 2
REBAR SET
N 01°-04'-45" W
1229.01 ± CAL & USED
729.43
499.58
1.6399 Ac.
2.3957 Ac.
N 88°-57' E 142.88
N 88°-11'-13" E
142.89 CAL
142.92 REC.
℄ ESTABLISHED BY STETSON CREEK PLAT
496.07 ±
731.33
REBAR SET
BROKEN STONE FD
SAEED & AREZOU ESLAMLOU
OR 627 PG 504
P FD
N 01°-04'-45" W
1227.40 R&U ±
59.97
59.97
30
30.
MON
N 01°-03'-0" W
R/W
S/L 3
S/L 4
WALTER & DOROTHY STOUT
OR 976 PG 82
STETSON CREEK SUBN
P.V. 37 PG 9
SURVEY
OF PART OF
ORIGINAL RIDGEVILLE TWP LOT, 6
CITY OF N RIDGEVILLE COUNTY OF LORAIN
STATE OF OHIO
DATE: FEB. 1999
SCALE 1"=50'
LANE
N 88°-57'-0" E
SUNBROOK
429.50
MILLS CREEK EAST SUBN
PV 34 PG 45
PREPARED FOR:
TOM DEIGHTON
32155 MILLS RD.
AVON, OH.
PREPARED BY:
HAPONEK & ASSOC INC.
SURVEYORS
N RIDGEVILLE, OH.
STATE OF OHIO
DAVID
HAPONEK
JR.
REGISTERED
SURVEYOR
NORTH BARTON ROAD 60'
N 01°-03'-0" W
119.4
CH. 171.40 N 15°-48'-40" E
N 32°-40'-20" E 269.20
CH. 190.65 N 15°-04'-55" E
85.
MON
N 87°-29'-30" E
NORTHWOOD CT.
421.76
N 02°-30'-30" W
OAKHURST
#00063
APPROVED
LORAIN CO.
MAP DEPT.
DATE 4-22-99
PAGE 7-00-006-B
BY T. Zak
JOB NO. 00063

88-04