

FOOR & ASSOCIATES

35336 CENTER RIDGE NORTH RIDGEVILLE, OHIO 44039

MAP OF PART OF PARCEL #29 SOUTH HILLS LAND CO'S BRIDGEVILLE NAGLE FARMS

PART OF ORIGINAL LOT NO. 7 CITY OF BRIDGEVILLE OHIO

LORAIN COUNTY OHIO

3RD PARCEL MARY B. FALKNER VOL. 158 P. 521

APPROVED	MAP DEPT.	DATE 9-30-84	PAGE 7-03-007-A	BY C. FRANCIS	VOID 17045
----------	-----------	--------------	-----------------	---------------	------------

N=00°40'00"-E 2867.33'

S=00°40'00"-W 100.00'

REC. & OBS.

Q.L.#7 Q.L.#8

1.P. SET
 1.P. ED. @ 561.87 FROM R/W
 1.P. ED @ 258.80 FROM R/W
 N-00°40'00"-E 100.00'



7-00-007-A


SCALE: 1"=30'

DATE: AUG. 1986

PREPARED FOR WILLIAM R. EVELYN KEARNEY

0.4591 ACRES

0.078

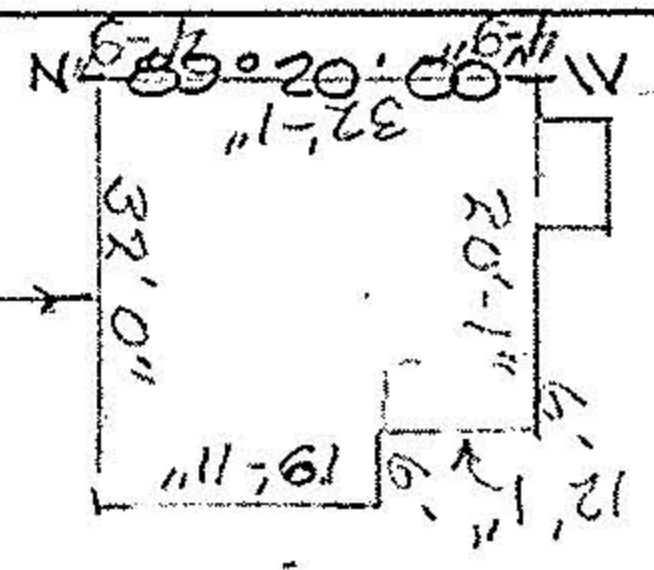


1.P. ED. & HELD

Drive

1.P. ED. & USED

S-89°20'00"-E 200.00'

LEAVE NAGLE ROAD 50'

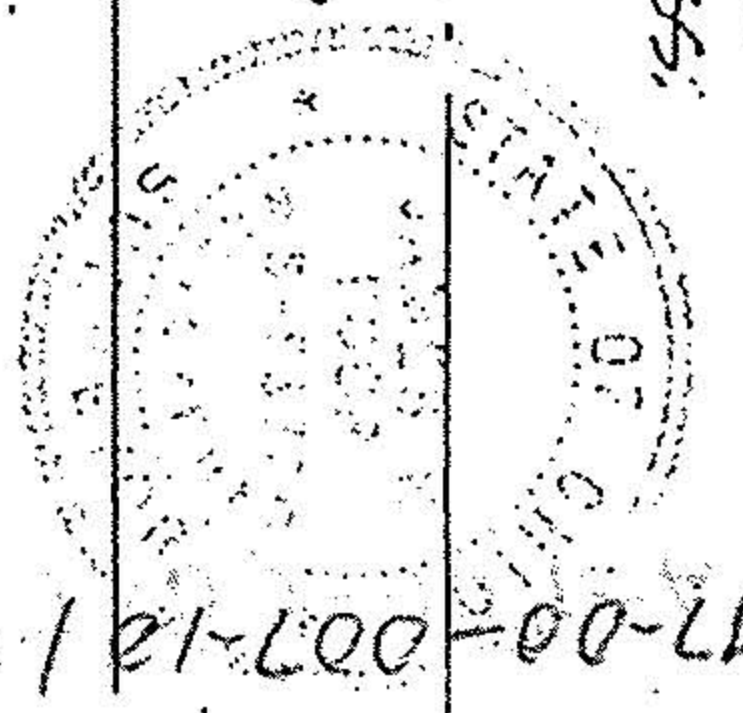

86.01