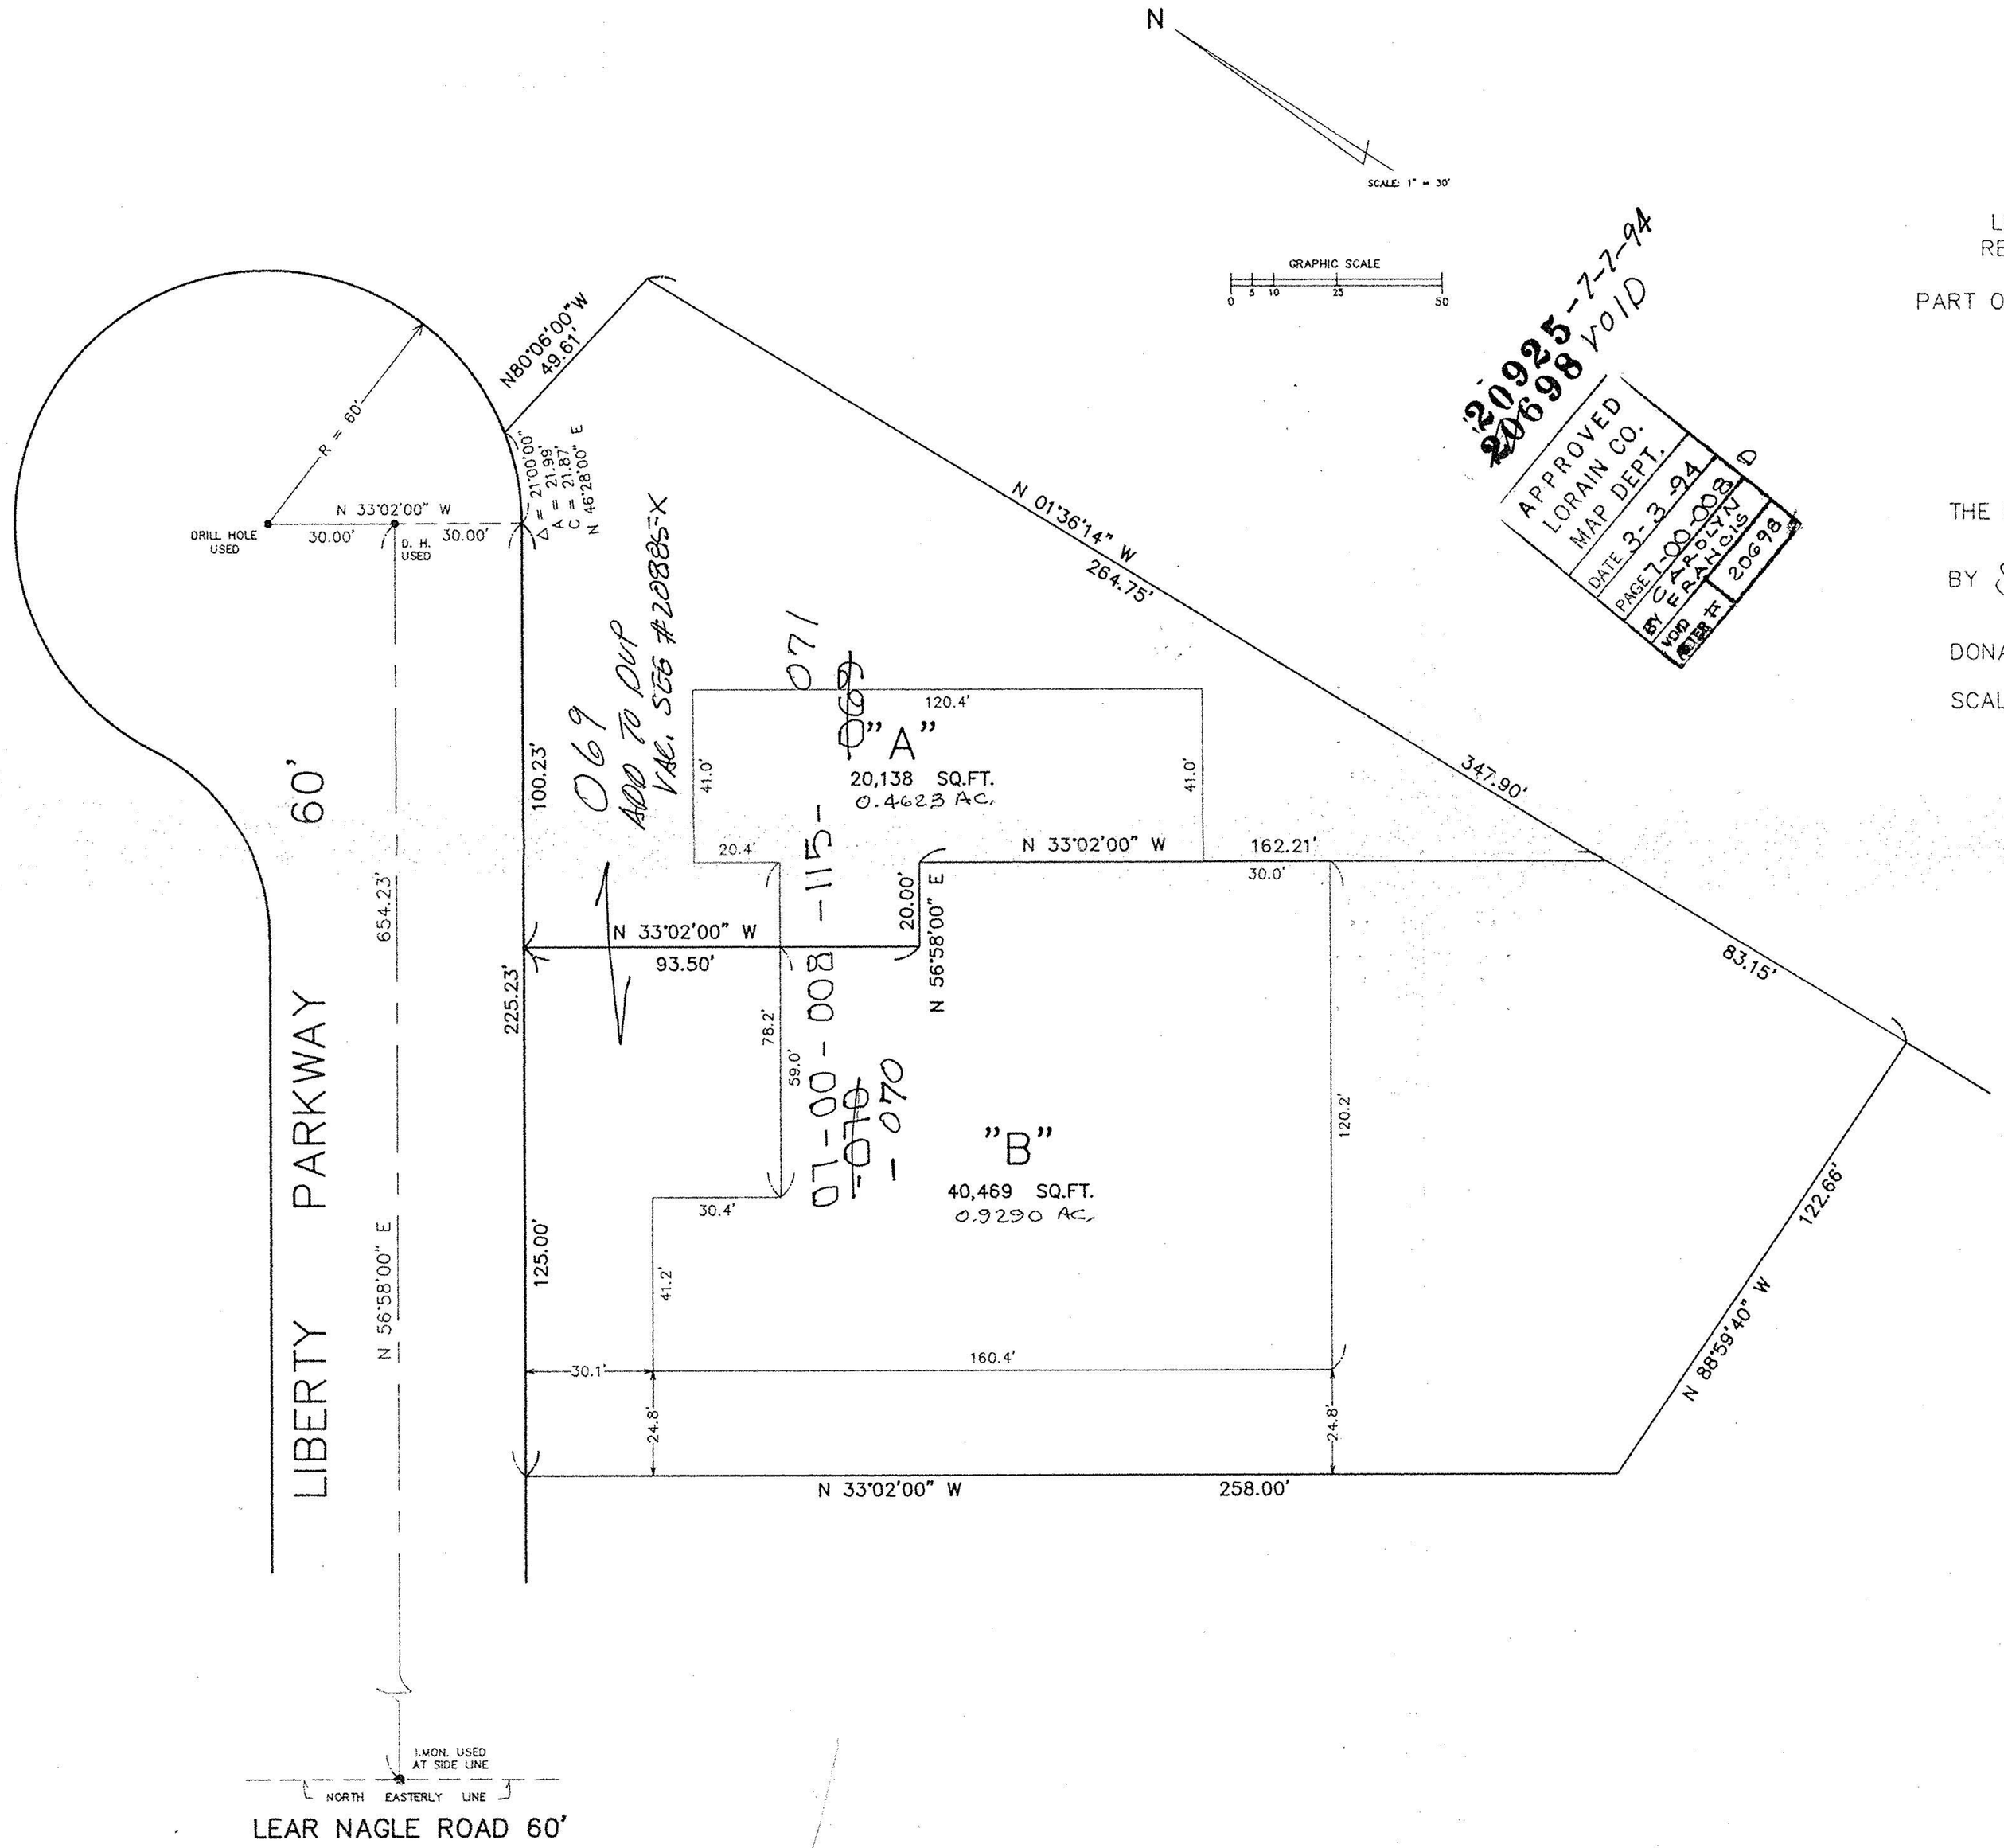


20925-7-7-94
20698 void

APPROVED
LORAIN CO.
MAP DEPT.
DATE 3-3-94
PAGE 7-00-008 D
BY CAROLYN E. FRANCIS
VOID
TR 20698

# SURVEY

OF
UNITS 1 – 4
IN
LIBERTY INDUSTRIAL PARK CONDOMINIUM
RECORDED IN VOLUME 36, PGS 10, 11, 12
OF
PART OF ORIGINAL RIDGEVILLE TOWNSHIP LOT NO. 8
IN
THE CITY OF NORTH RIDGEVILLE
COUNTY OF LORAIN
STATE OF OHIO
FOR
JAMES M. McCLAIN
BY
THE HENRY G. REITZ ENGINEERING CO.

BY Donald E. Woike V. PRES.

DONALD E. WOIKE, REGISTERED SURVEYOR NO. 5547

SCALE: 1" = 30'

OCTOBER, 1993
REVISED: 11-29-93
12/22/93 ADD ACREAGE

STATE OF OHIO
DONALD E. WOIKE
5547
REGISTERED SURVEYOR