700-008

1-00-008

7-00-008 B&D

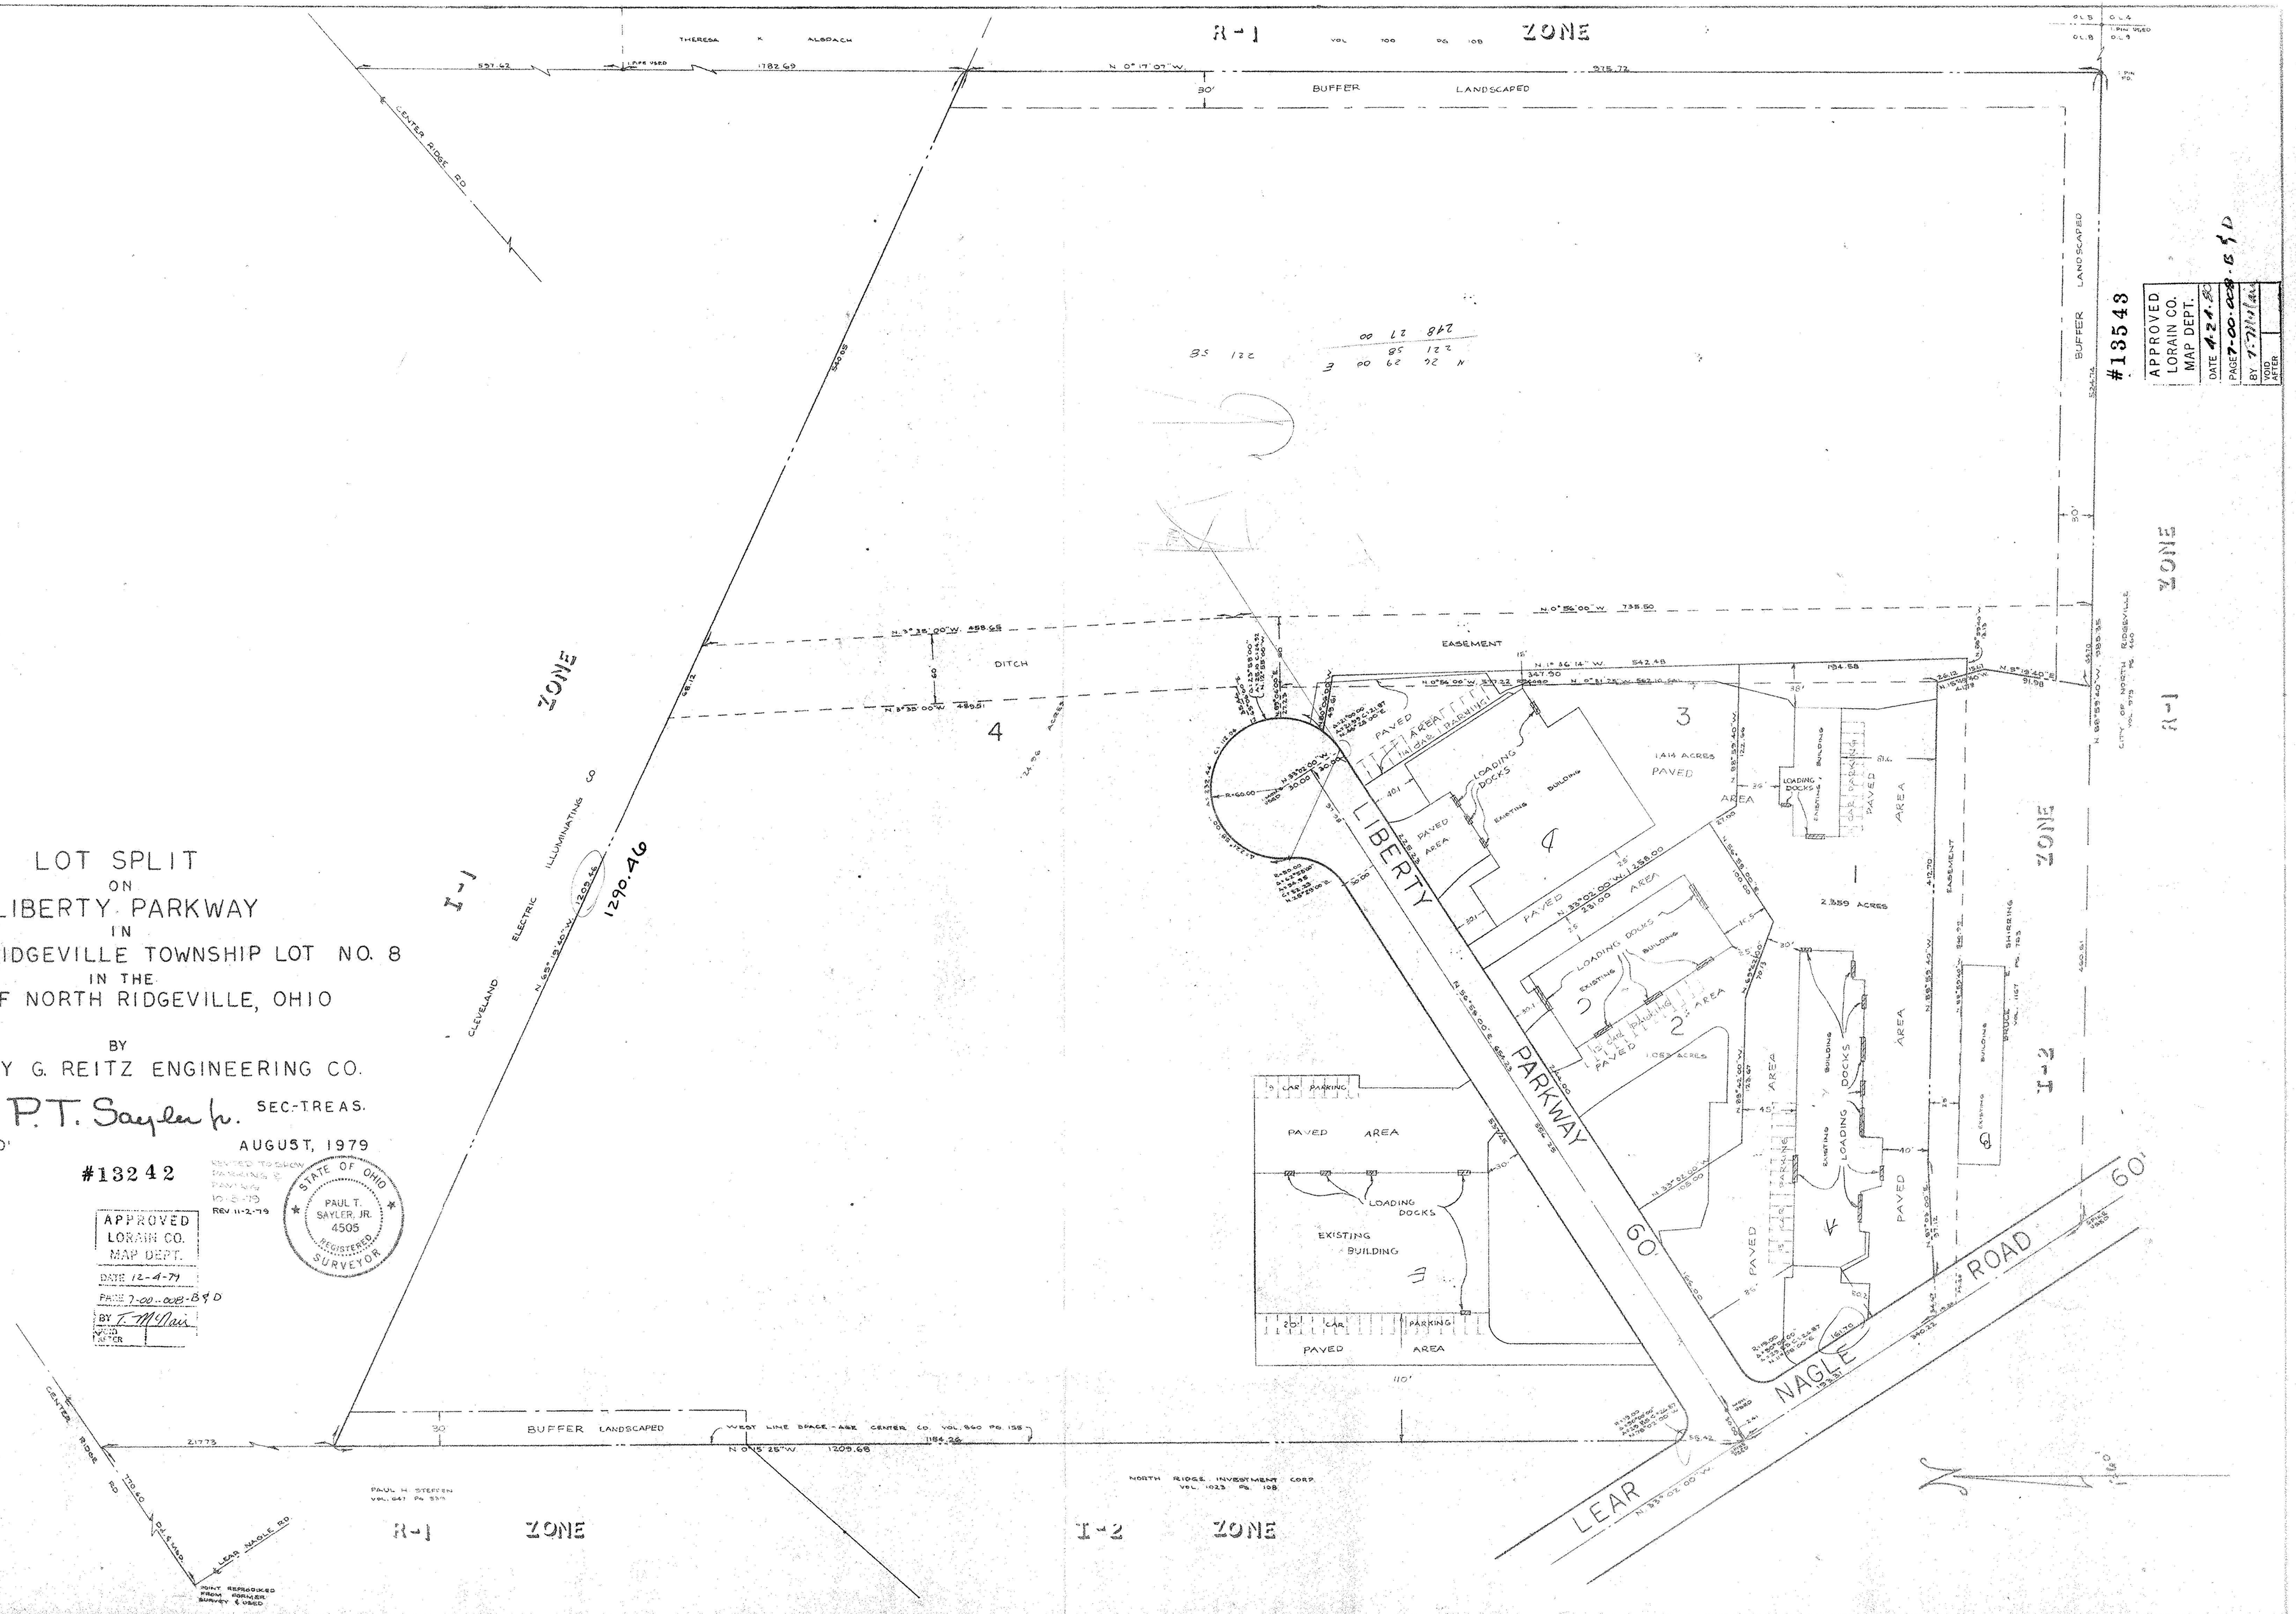

LOT SPLIT
ON
LIBERTY PARKWAY
IN
ORIGINAL RIDGEVILLE TOWNSHIP LOT NO. 8
IN THE
CITY OF NORTH RIDGEVILLE, OHIO

BY
THE HENRY G. REITZ ENGINEERING CO.

BY P.T. Sayler Jr. SEC-TREAS.

SCALE 1"=60' AUGUST, 1979

#13242

REVISED TO SHOW PARKING & PAVING 10-8-79 REV. 11-2-79

STATE OF OHIO PAUL T. SAYLER, JR. 4505 REGISTERED SURVEYOR

APPROVED LORAIN CO. MAP DEPT.
DATE 12-4-79
PAGE 7-00-008-B&D
BY T. McNair
VOID AFTER

#13543

APPROVED LORAIN CO. MAP DEPT.
DATE 4.24.80
PAGE 7-00-008-B&D
BY T. McNair
VOID AFTER