#22436
APPROVED
LORAIN CO.
MAP DEPT
DATE 3/19/98
PAGE 7-00009-A
BY K.Colbert
#22436

STATE OF OHIO
DANE
A.
HAPONEK
S-6211
REGISTERED
SURVEYOR

Scale: 1"=30'
January – 1998
Rev. Feb. – 1998

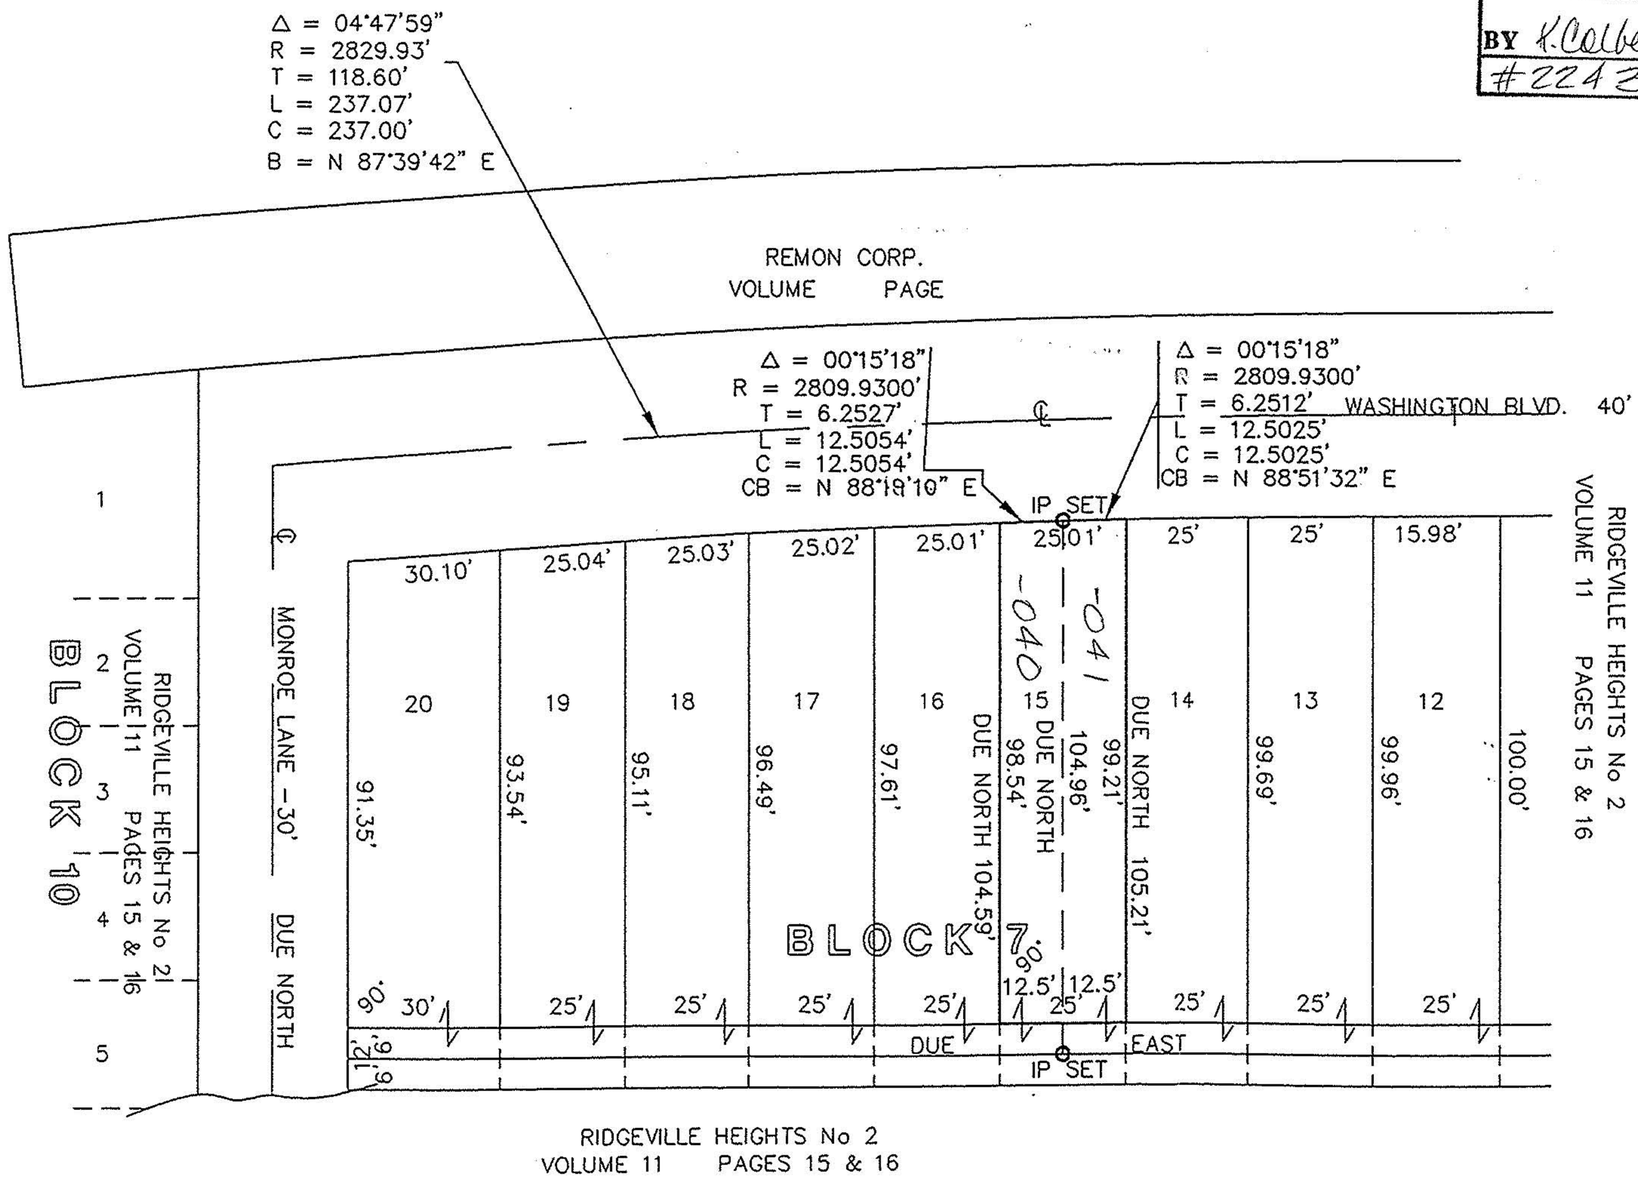

PART OF RIDGEVILLE HEIGHTS No 2
ORIGINAL RIDGEVILLE TOWNSHIP LOT 9
CITY OF NORTH RIDGEVILLE COUNTY OF LORAIN
STATE OF OHIO

PREPARED FOR: REMON CORP.
37000 CENTER RIDGE ROAD
NORTH RIDGEVILLE, OHIO

PREPARED BY: HAPONEK & ASSOCIATES
34100 CENTER RIDGE ROAD
NORTH RIDGEVILLE, OHIO